


DUNHAM SURVEYING, S.C.
SURVEYING & SUBDIVIDING
DELAVER, WISCONSIN 53115

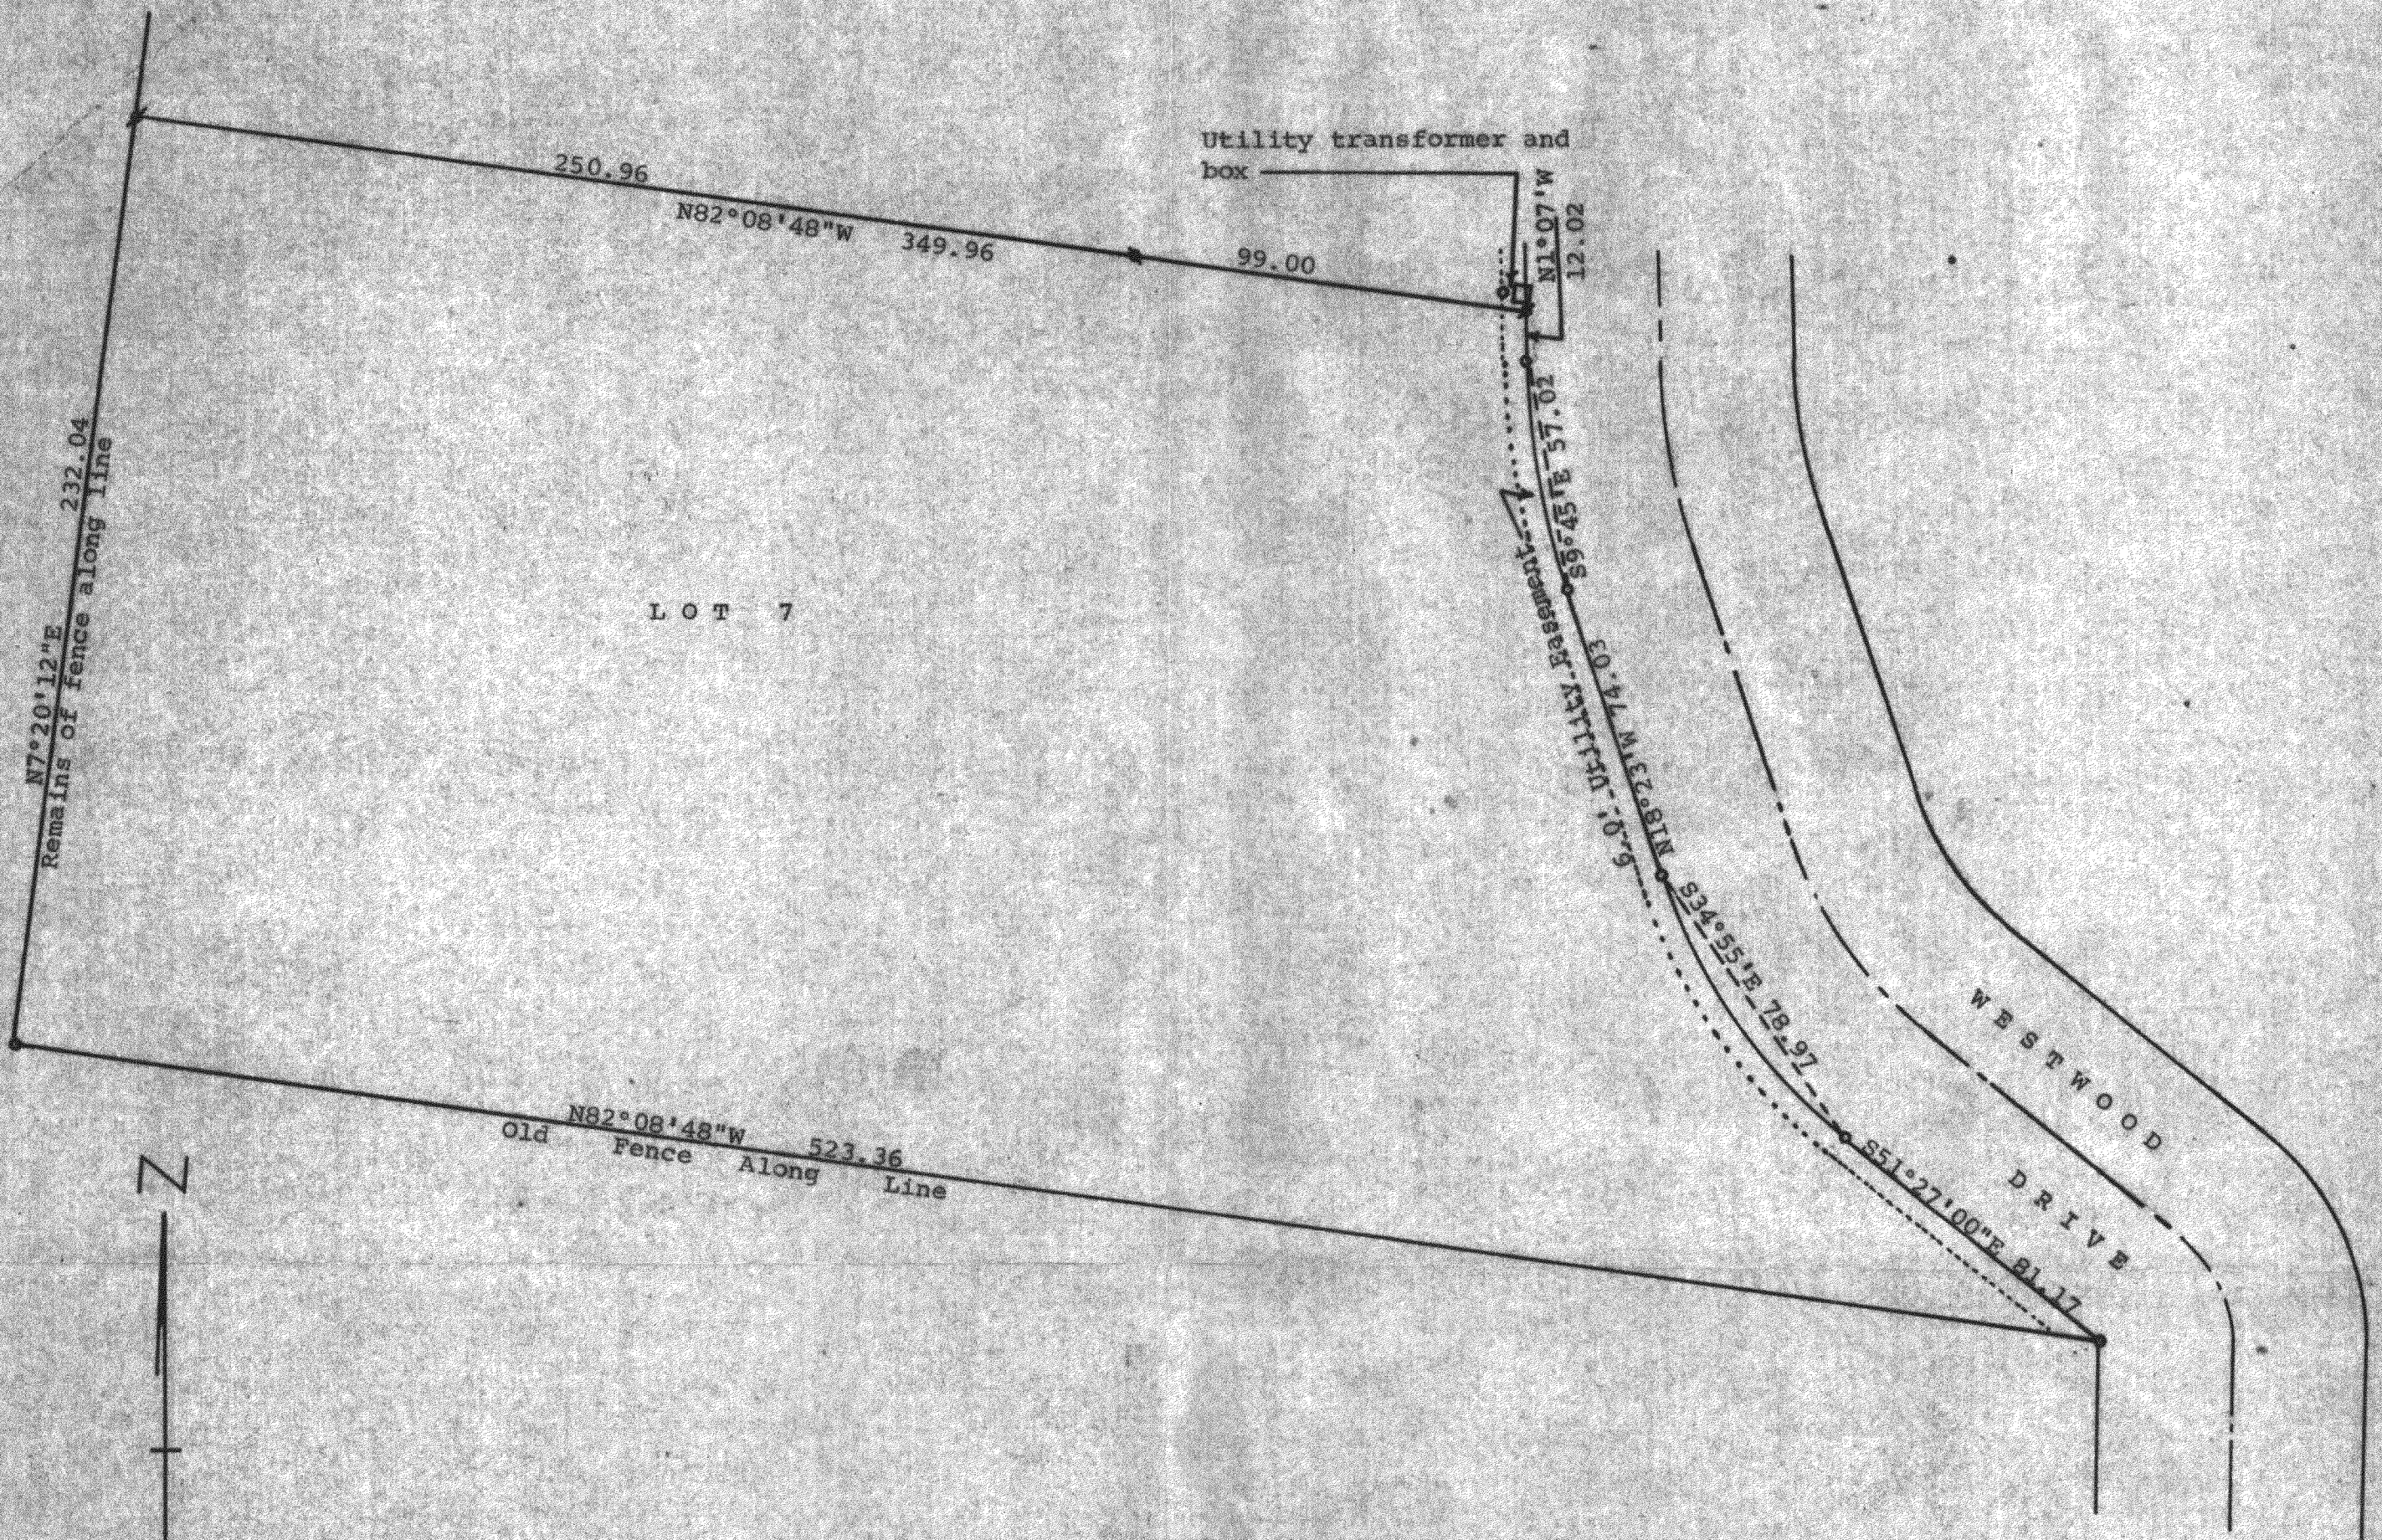

Scale - 1" = 40'
 ● = 1" Iron Pipe Found
 ○ = 2" Iron Pipe Found
 Bearings used are those of record
 Owner: Arland Mesmer
 Delavan, WI 53115
 ● = 3/4" Iron Pipe Found

STATE OF WISCONSIN) SS
 COUNTY OF WALWORTH)

I, George T. Dunham, Surveyor, certify that I have surveyed the property described as follows:

Lot 7 in Westwood, a subdivision located in Sections 11 and 14, T 2 N, R 15 E, Walworth County, Wisconsin, and that the plat shown above is a true representation thereof and shows the size and location of the property, its exterior boundaries, the location of boundary fences, apparent easements, roadways and visible encroachments, if any, and that I have surveyed the property hereon described according to the official records, to the best of my knowledge and belief.
 April 27, 1984

George T. Dunham
 George T. Dunham, Surveyor

