


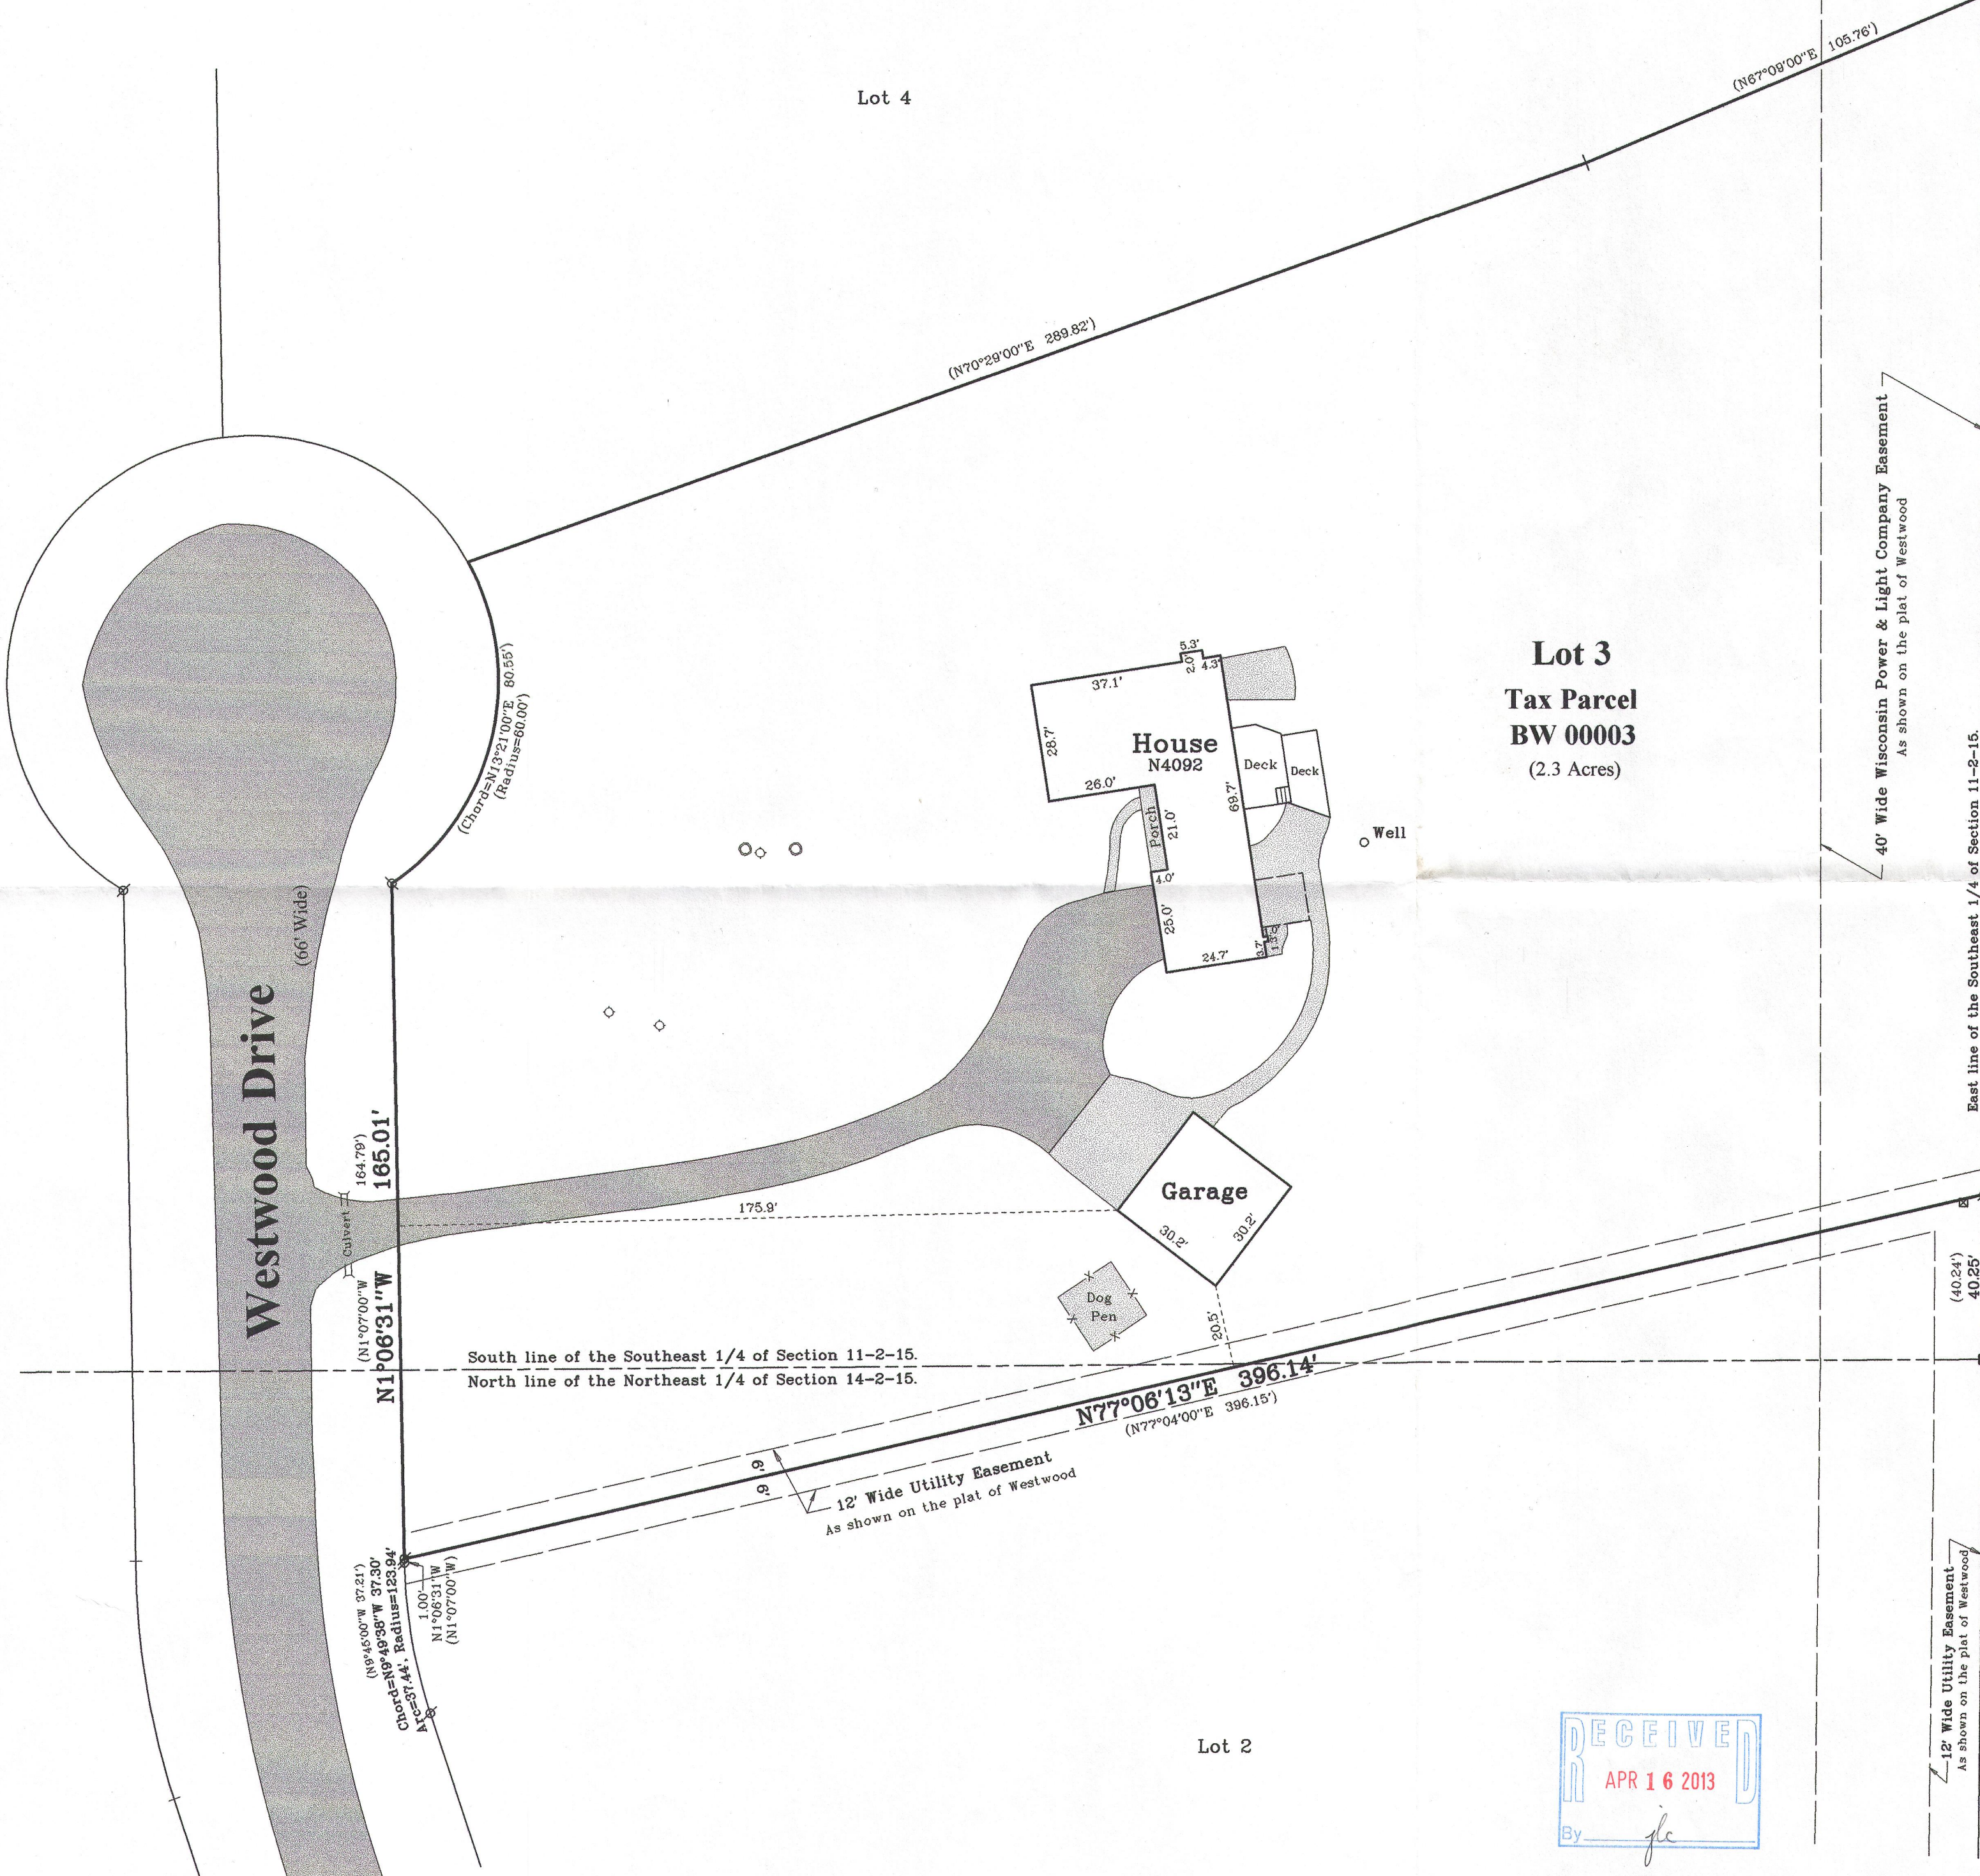


Plat of Survey

of
A Portion of Lot 3 of Westwood,


a subdivision located in the Southeast 1/4 of Section 11 and the
Northeast 1/4 of Section 14, Town 2 North, Range 15 East, Town
of Darien, Walworth County, Wisconsin.

Surveyed for: **Phil Lindloff**
N4092 Westwood Drive
Delavan, Wisconsin. 53115

Tax Parcel

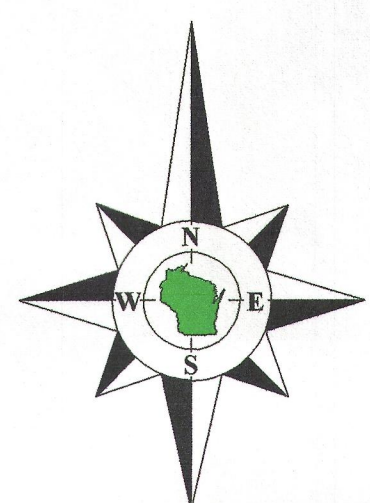

Bearings reference to the
plat of Westwood.

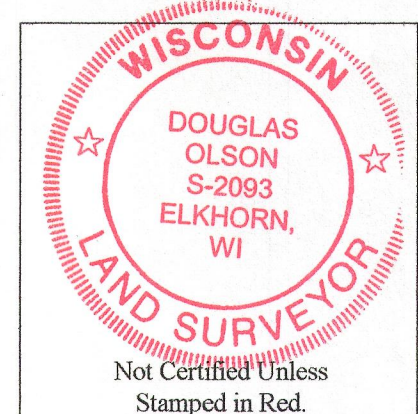


- Notes:**
- 1) This survey plat is not certified unless signed and sealed in red ink.
 - 2) This survey is subject to Wisconsin lien laws. This Plat of Survey is the notice of intent to file lien. Lien waiver required.

Copyright 2012 by Jensen & Olson Land Surveying, LLC.


All rights reserved. No part of this survey plat may be reproduced or transmitted in any form by any means - graphic, electronic, or mechanical, including photocopying, tracing, or information storage and retrieval systems - without permission in writing from Douglas G. Olson, Jensen & Olson Land Surveying, LLC.

I, Douglas G. Olson, Wisconsin Registered Land Surveyor, do hereby certify that this survey was performed by me, or under my direction in full compliance with the owner's/agent's instructions and Chapter A-E 7 of the Wisconsin Administrative Code "Minimum Standards for Property Surveys"; and that this map is an accurate representation thereof to the best of my knowledge and belief.

Douglas G. Olson
Wisconsin Registered Land Surveyor - 2093

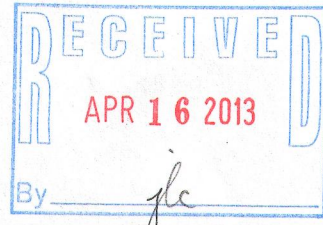

Survey Date: December 14, 2012.
Revisions:

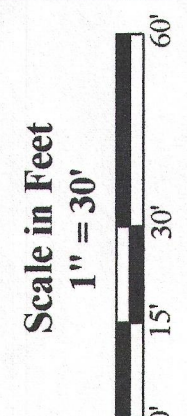

Jensen & Olson Land Surveying, LLC

45 South Wisconsin Street * P.O. Box 322 * Elkhorn, Wisconsin. 53121
Telephone: (262) 723-3434 * Facsimile: (262) 723-8044
Email: jensen.olson@elknet.net

Legend

- Found County Section Corner
- Recorded Information
- Utility Pole
- Utility Pedestal
- Concrete Cover
- Asphalt Surface
- Concrete

Sheet 1 of 1 Sheets

Drawing Name: Ch 15-2012131-2012131Plat.swp

Job Reference Number

2012.131

2012.131