


of

recorded December 21, 1984 in Vol. 8 of Certified Survey Maps of Walworth County on Page 270 as Document Number 110415 and located in the Southwest 1/4 of the Southeast 1/4 of Section 25, Town 2 North, Range 15 East, Town of Darien, Walworth County, Wisconsin.

Bearings referenced to the straight line between the South 1/4 Corner and the Southeast Corner of Section 25-2-15, recorded as N87°28'10"E in the Wisconsin State Plane Coordinate System, South Zone, (NAD-27).

Coordinates are referenced to the Wisconsin State Plane Coordinate System, South Zone, (NAD-27).

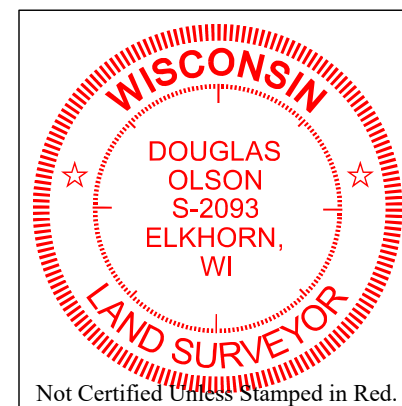

- 1) This Plat of Survey is not certified unless signed and sealed in red ink.
- 2) This survey is subject to Wisconsin lien laws. This Plat of Survey is the notice of intent to file lien. Lien waiver required.
- 3) The Survey Date shown on this Plat of Survey is the completion date of the field work.

All rights reserved. No part of this survey plat may be reproduced or transmitted in any form by any means - graphic, electronic, or mechanical, including photocopying, tracing, or information storage and retrieval systems - without permission in writing from Douglas G. Olson, Olson Land Surveying, LLC.

I hereby certify that I have surveyed the above described property in compliance with Chapter A-E 7 of the Wisconsin Administrative Code and that the map hereon is correct to the best of my professional knowledge and belief and shows the size and location of the property, its exterior boundaries, the location and dimensions of all visible structures thereon, boundary fences, apparent easements and roadways and visible encroachments, if any.

This survey is made for the exclusive use of the present owners of the property, and also those who purchase, mortgage or guarantee title thereto, within one year from the date hereof.

Douglas G. Olson
Wisconsin Professional Land Surveyor - 2093

Survey date: August 13, 2024.

Revisions: No. 1 – Proposed A
 No. 2 – Misc. Area
 No. 3 – Set Pipe

Scale in Feet
1" = 30'

A horizontal scale bar with alternating black and white segments. The segments are labeled from left to right: 0', 15', 30', 60', and 90'. The bar is oriented vertically in the image.

45 South Wisconsin Street | P.O. Box 322
Elkhorn, Wisconsin 53121
Telephone: (262) 723-3434
Facsimile: (262) 723-8044
Email: doug@olsonsurveying.com
Website: www.olsonsurveying.com



N North
S South
E East
W West
In Bearings
" Degrees
" Minutes
" Seconds
In Distances
" Feet
" Inches
No. Number
NW. Northwest
NE. Northeast
Dia. Diameter

Legend of Symbols & Abbreviations

Legend of Symbols &

- Found County Section Corner
- Found Iron Pipe
- Found Iron Rod
- Set Iron Pipe, 1" dia.
- Recorded Information
- Utility Pole
- Utility Pedestal
- Concrete Cover
- Septic Vent
- Asphalt Surface
- Concrete Surface
- Gravel Surface
- Brick Pavers

Sheet 1 of 1 Sheets

Reference Number
2022.045

2022.045