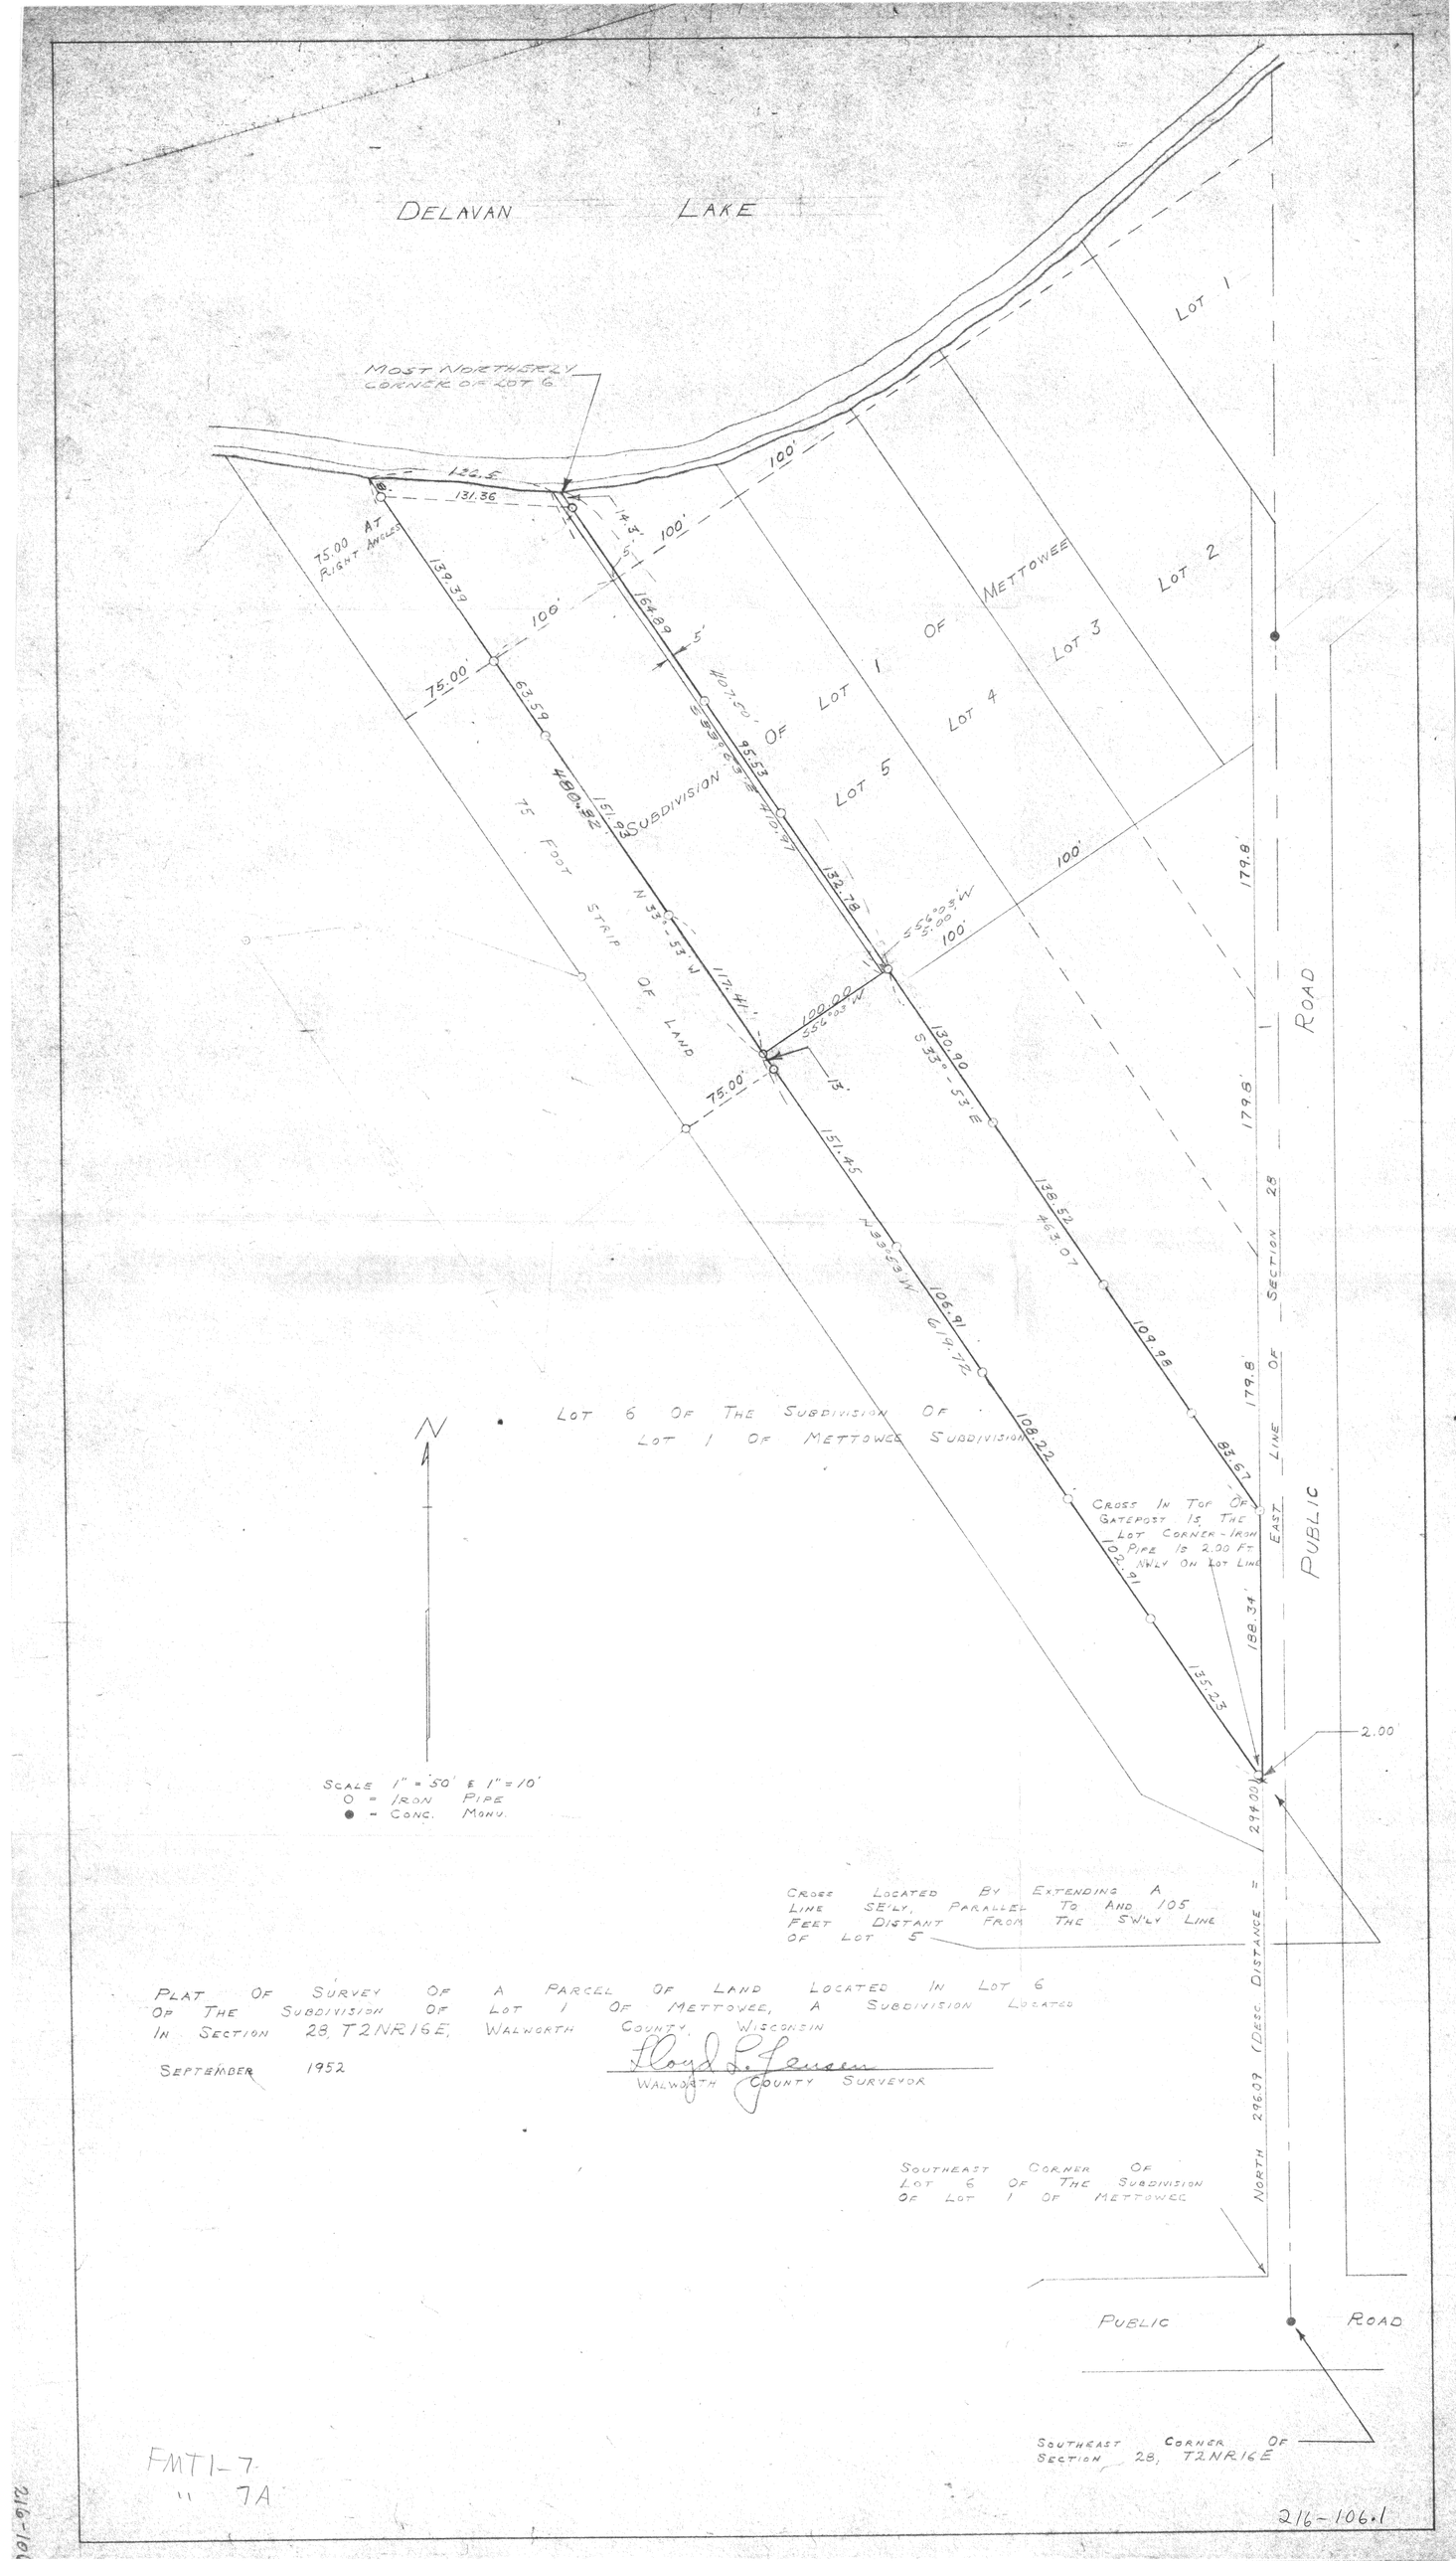

PLAT OF SURVEY OF A PARCEL OF LAND LOCATED IN LOT 6 OF THE SUBDIVISION OF LOT 1 OF METTOWEE, A SUBDIVISION LOCATED IN SECTION 28, T2NR16E, WALWORTH COUNTY, WISCONSIN

SEPTEMBER 1952

Floyd S. Jensen
WALWORTH COUNTY SURVEYOR

FMT 1-7
" 7A

216-106.1