


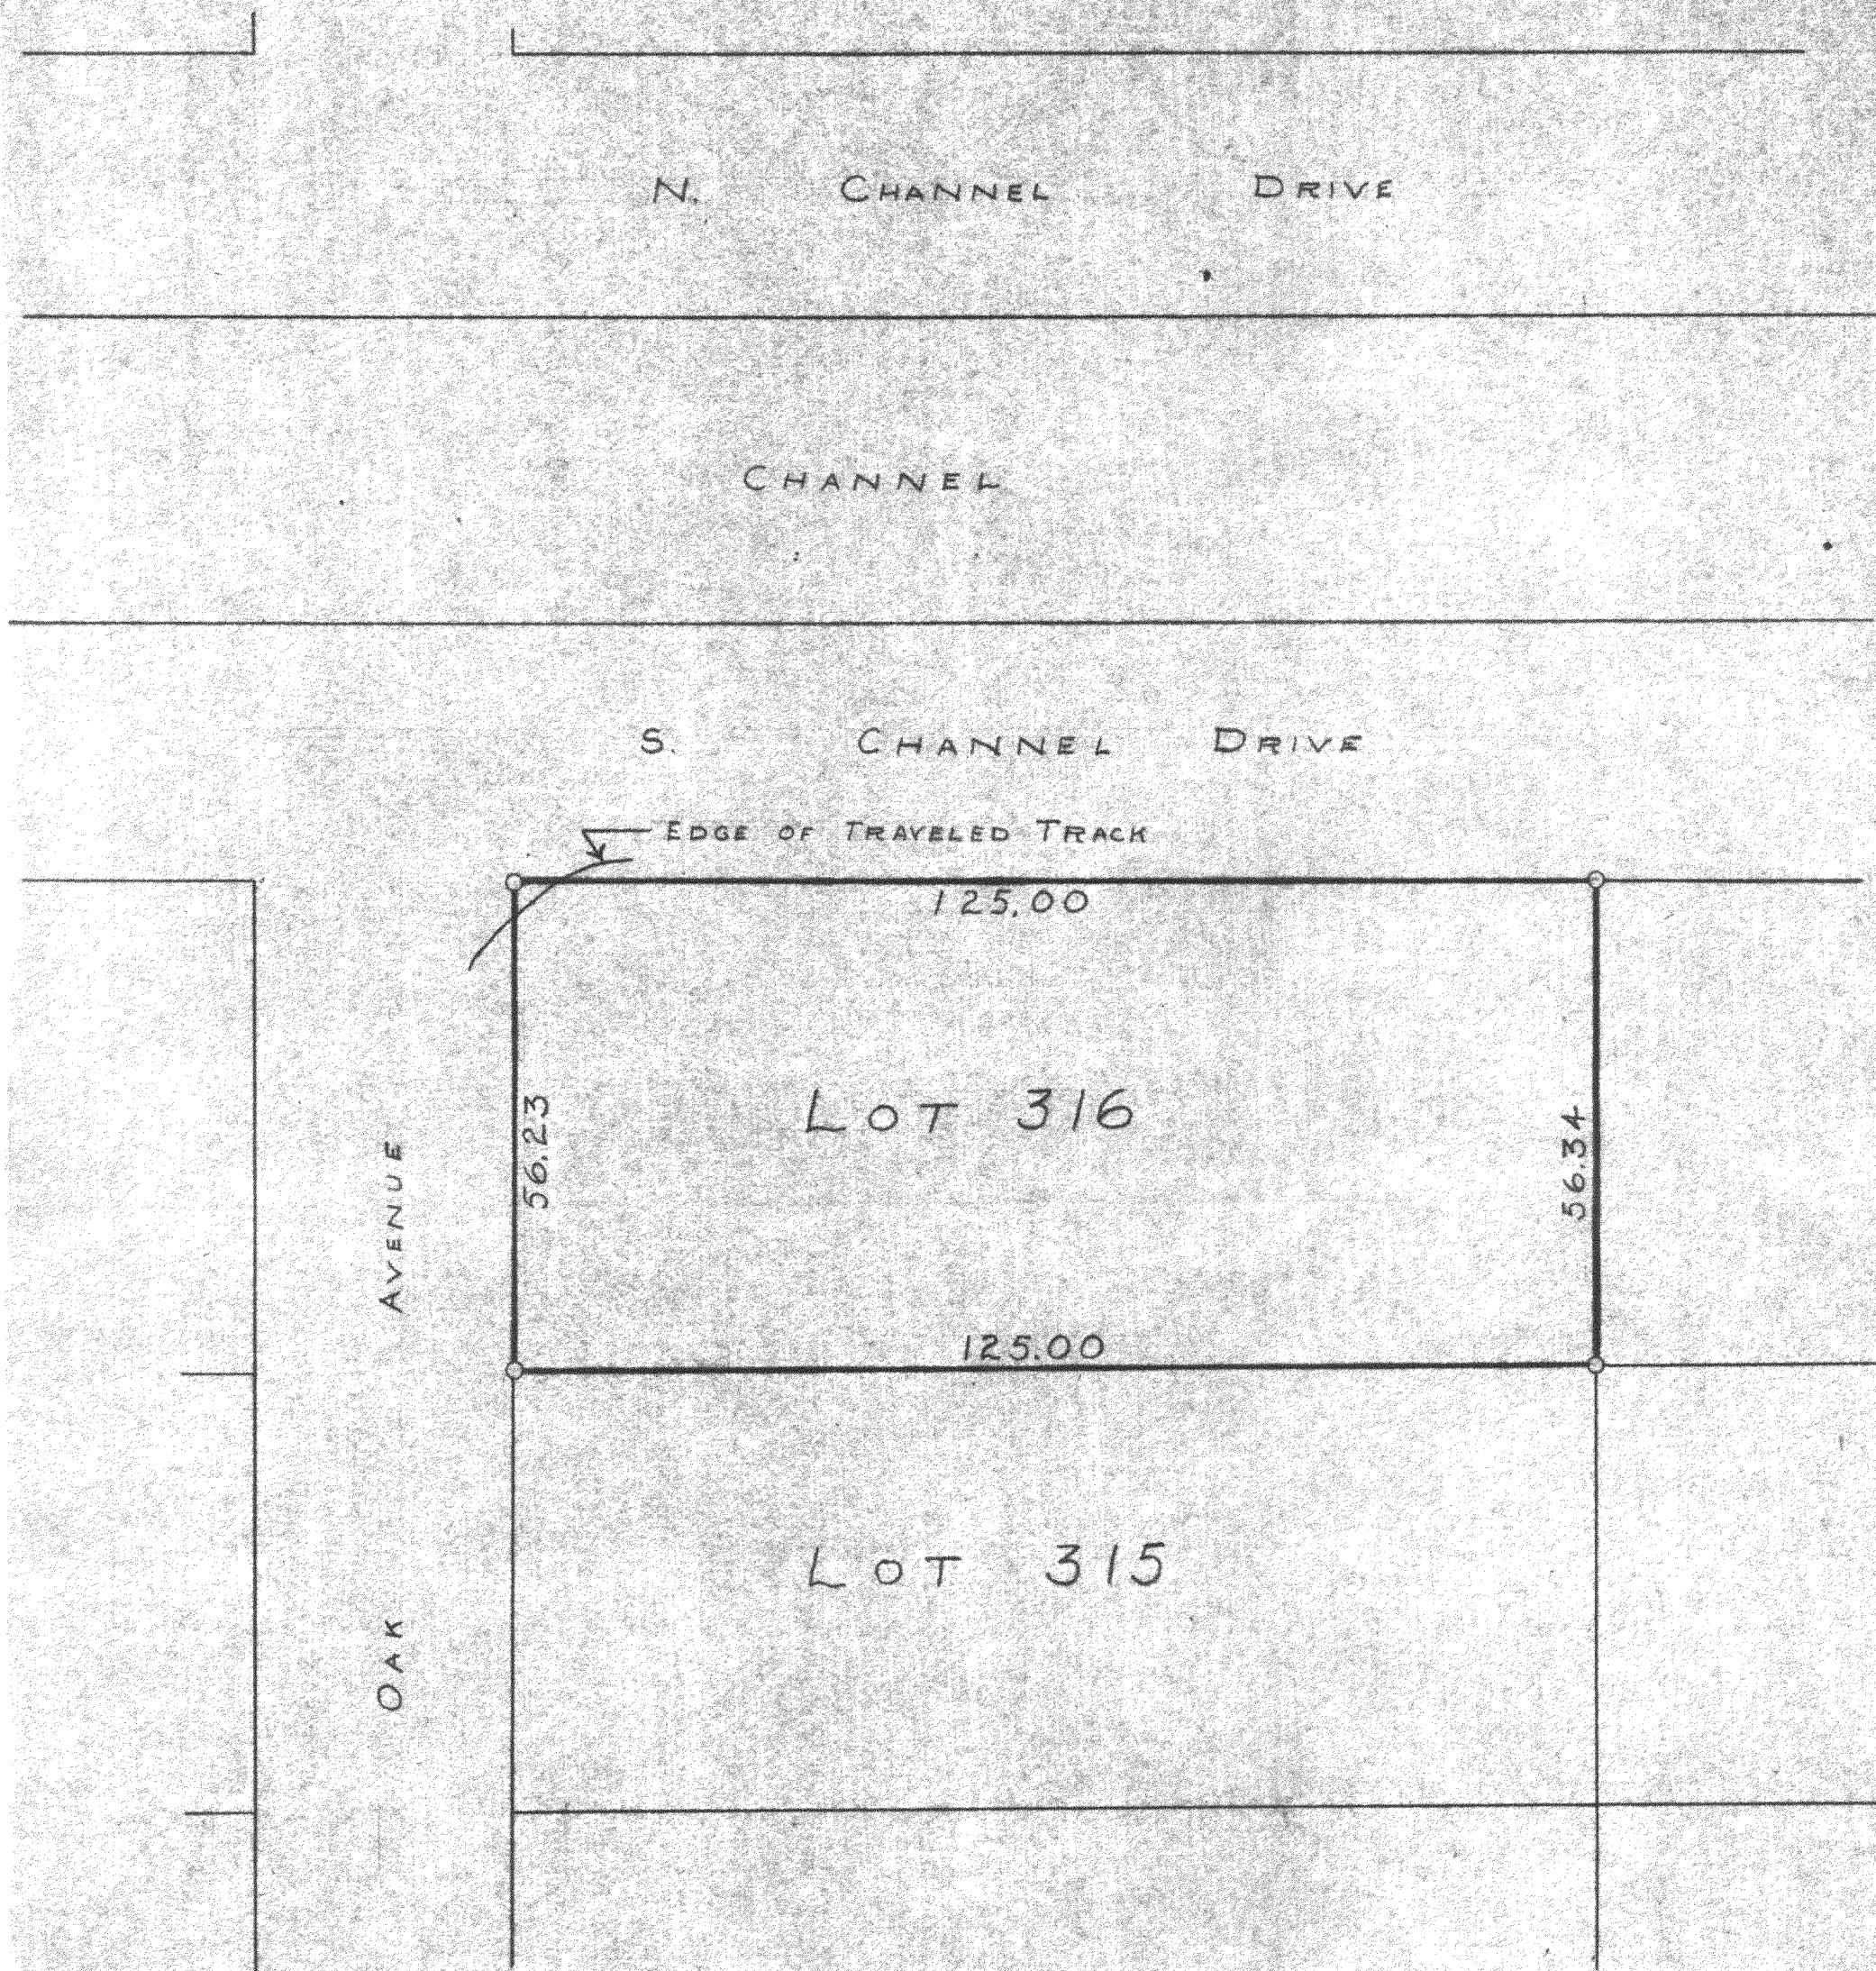

SCALE - 1" = 20'
O = IRON PIPE

PLAT OF SURVEY OF LOT 316, LAKE DELAVAN HIGHLANDS, A SUBDIVISION
LOCATED IN THE SE 1/4 OF SECTION 31, T2N R16E, WALWORTH COUNTY, WISCONSIN
APRIL 2, 1953

GEORGE T. DUNHAM, SURVEYOR 216-24
DELAVAN WISCONSIN

FLAD-237