Township 2 North, Range 16 East of the 4th Principal Meridian, Town of Delavan, Walworth County, Wisconsin.

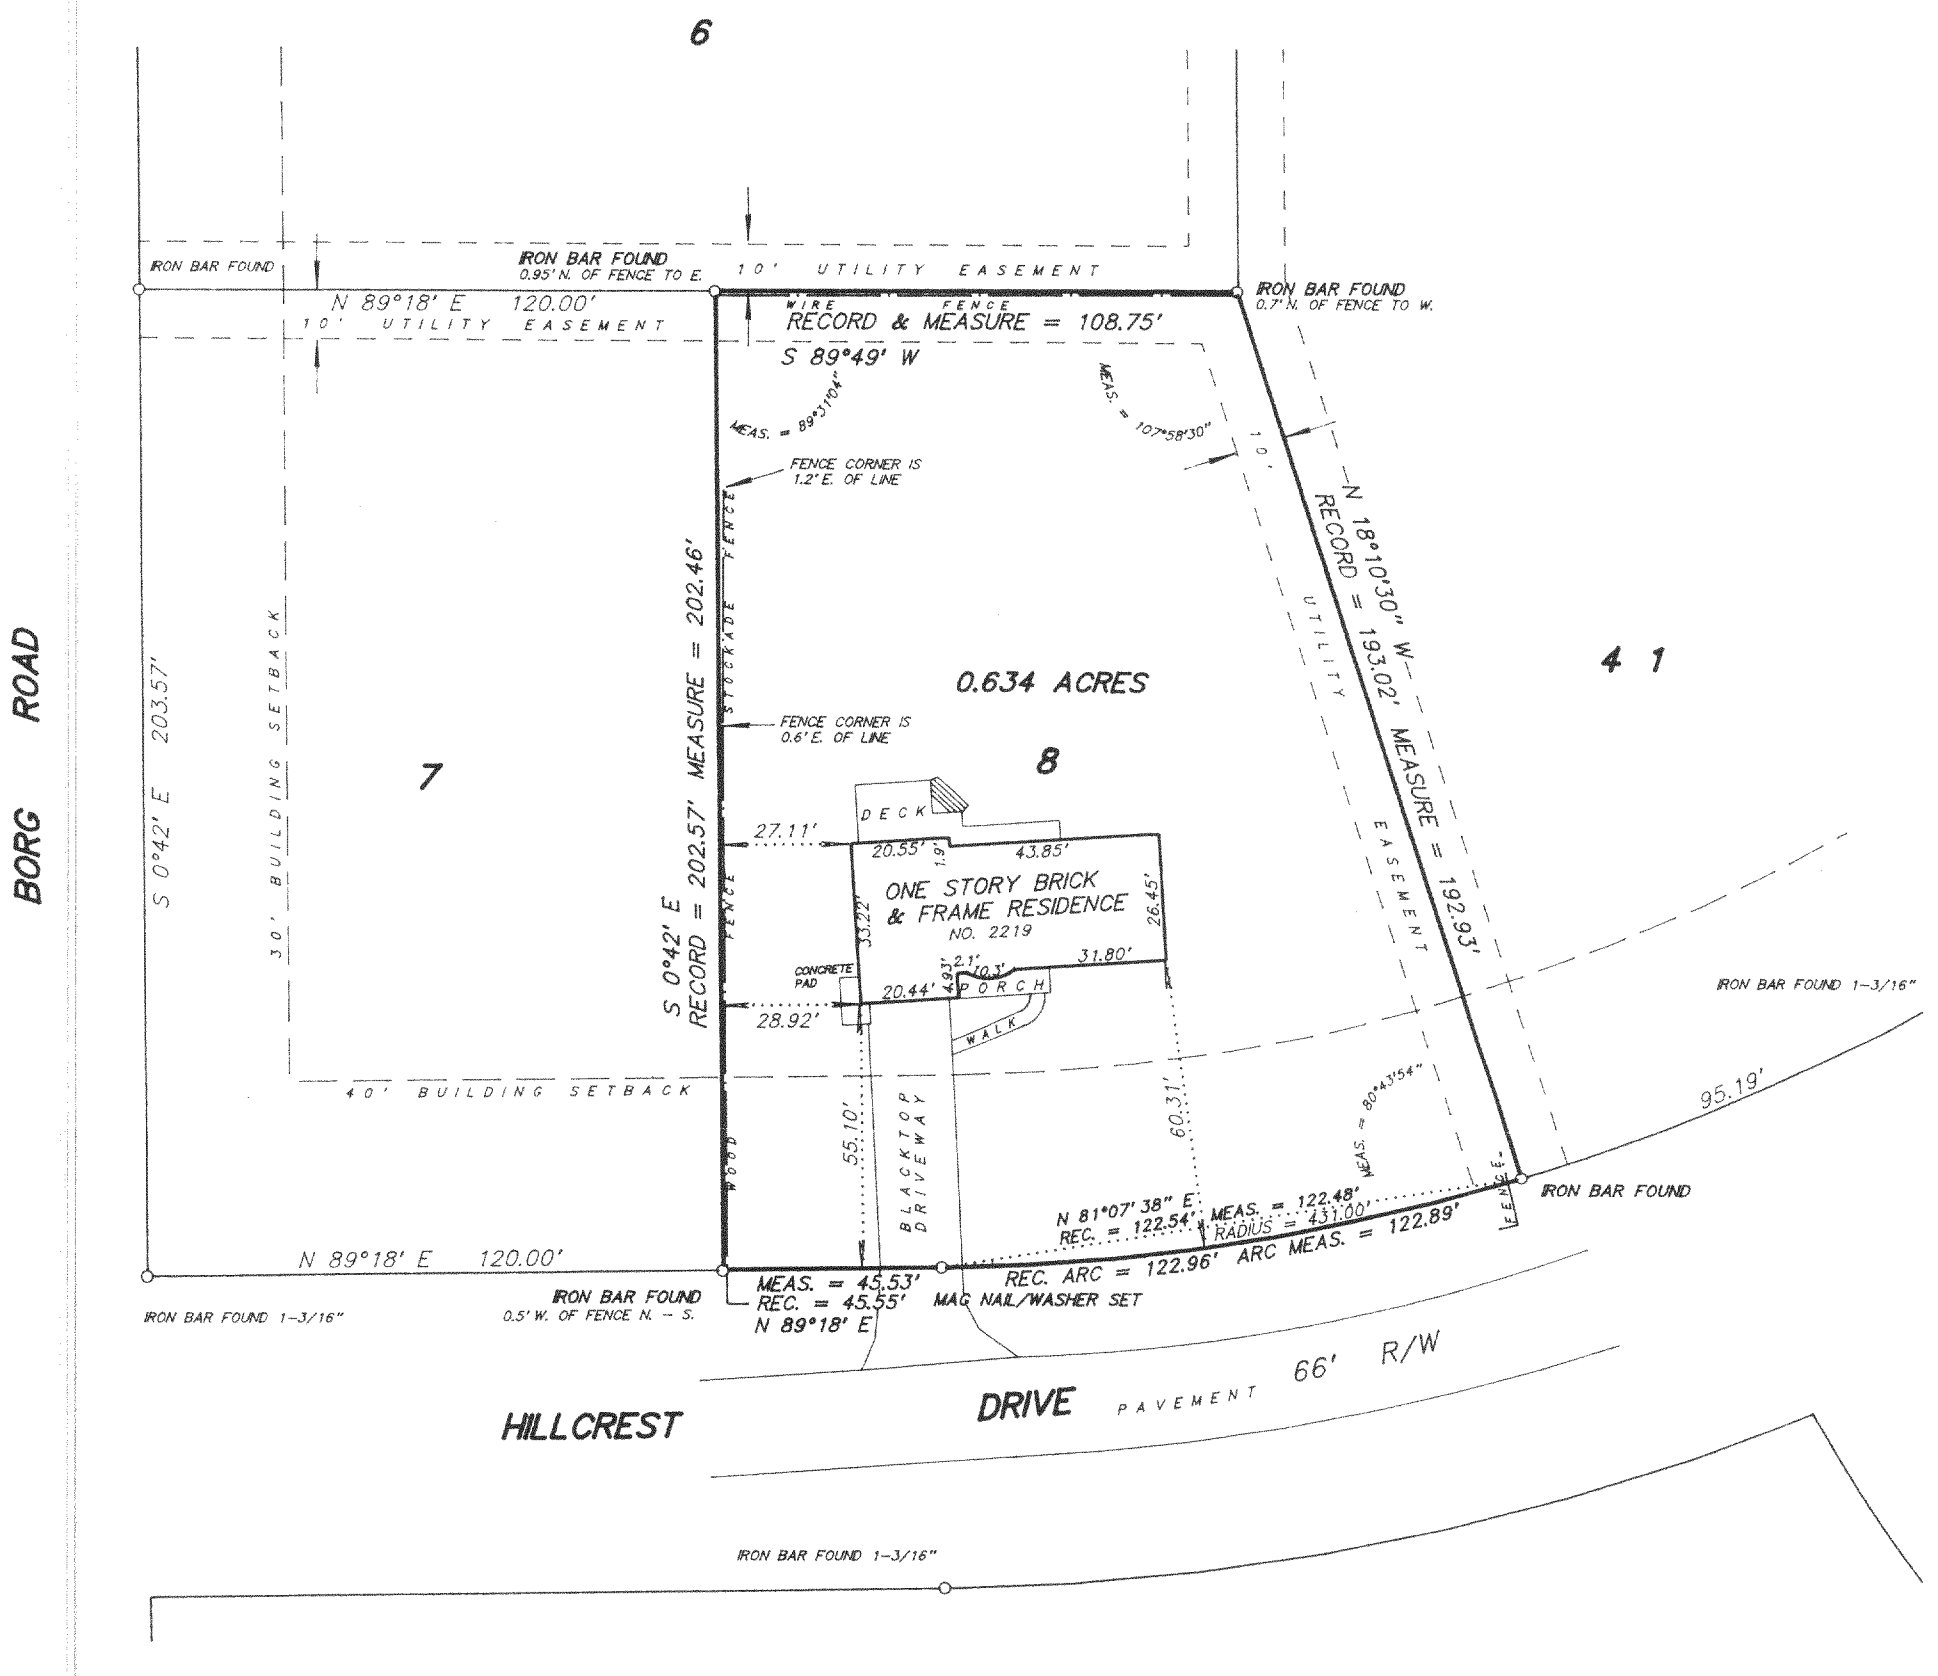

RECEIVED
OCT 3 2001

SCALE 1 inch = 40 feet

ORDERED BY C. Gene Simons / REMAX - Geneva Realty

JOB NO. 0 1 1 2 4

I hereby certify that I have surveyed the above described property and the c
plat is a true representation thereof and shows the size and location of
property, its exterior boundaries, the location and dimensions of all vis
structures thereon, boundary fences, apparent easements and roadways and vis
encroachments, if any.

This survey is made for the exclusive use of the present owners of the prope
and also those who purchase, mortgage, or guarantee the title thereto withir
year from the date hereof.

Dated at Bassett, Wisconsin this _____ day of _____ 20

Mark A. Bolender
Wisconsin Registered Land Surveyor S - 1784

FOMS-8
216-3071