


DUNHAM SURVEYING, S.C.
SURVEYING & SUBDIVIDING
DELAVER, WISCONSIN 53115

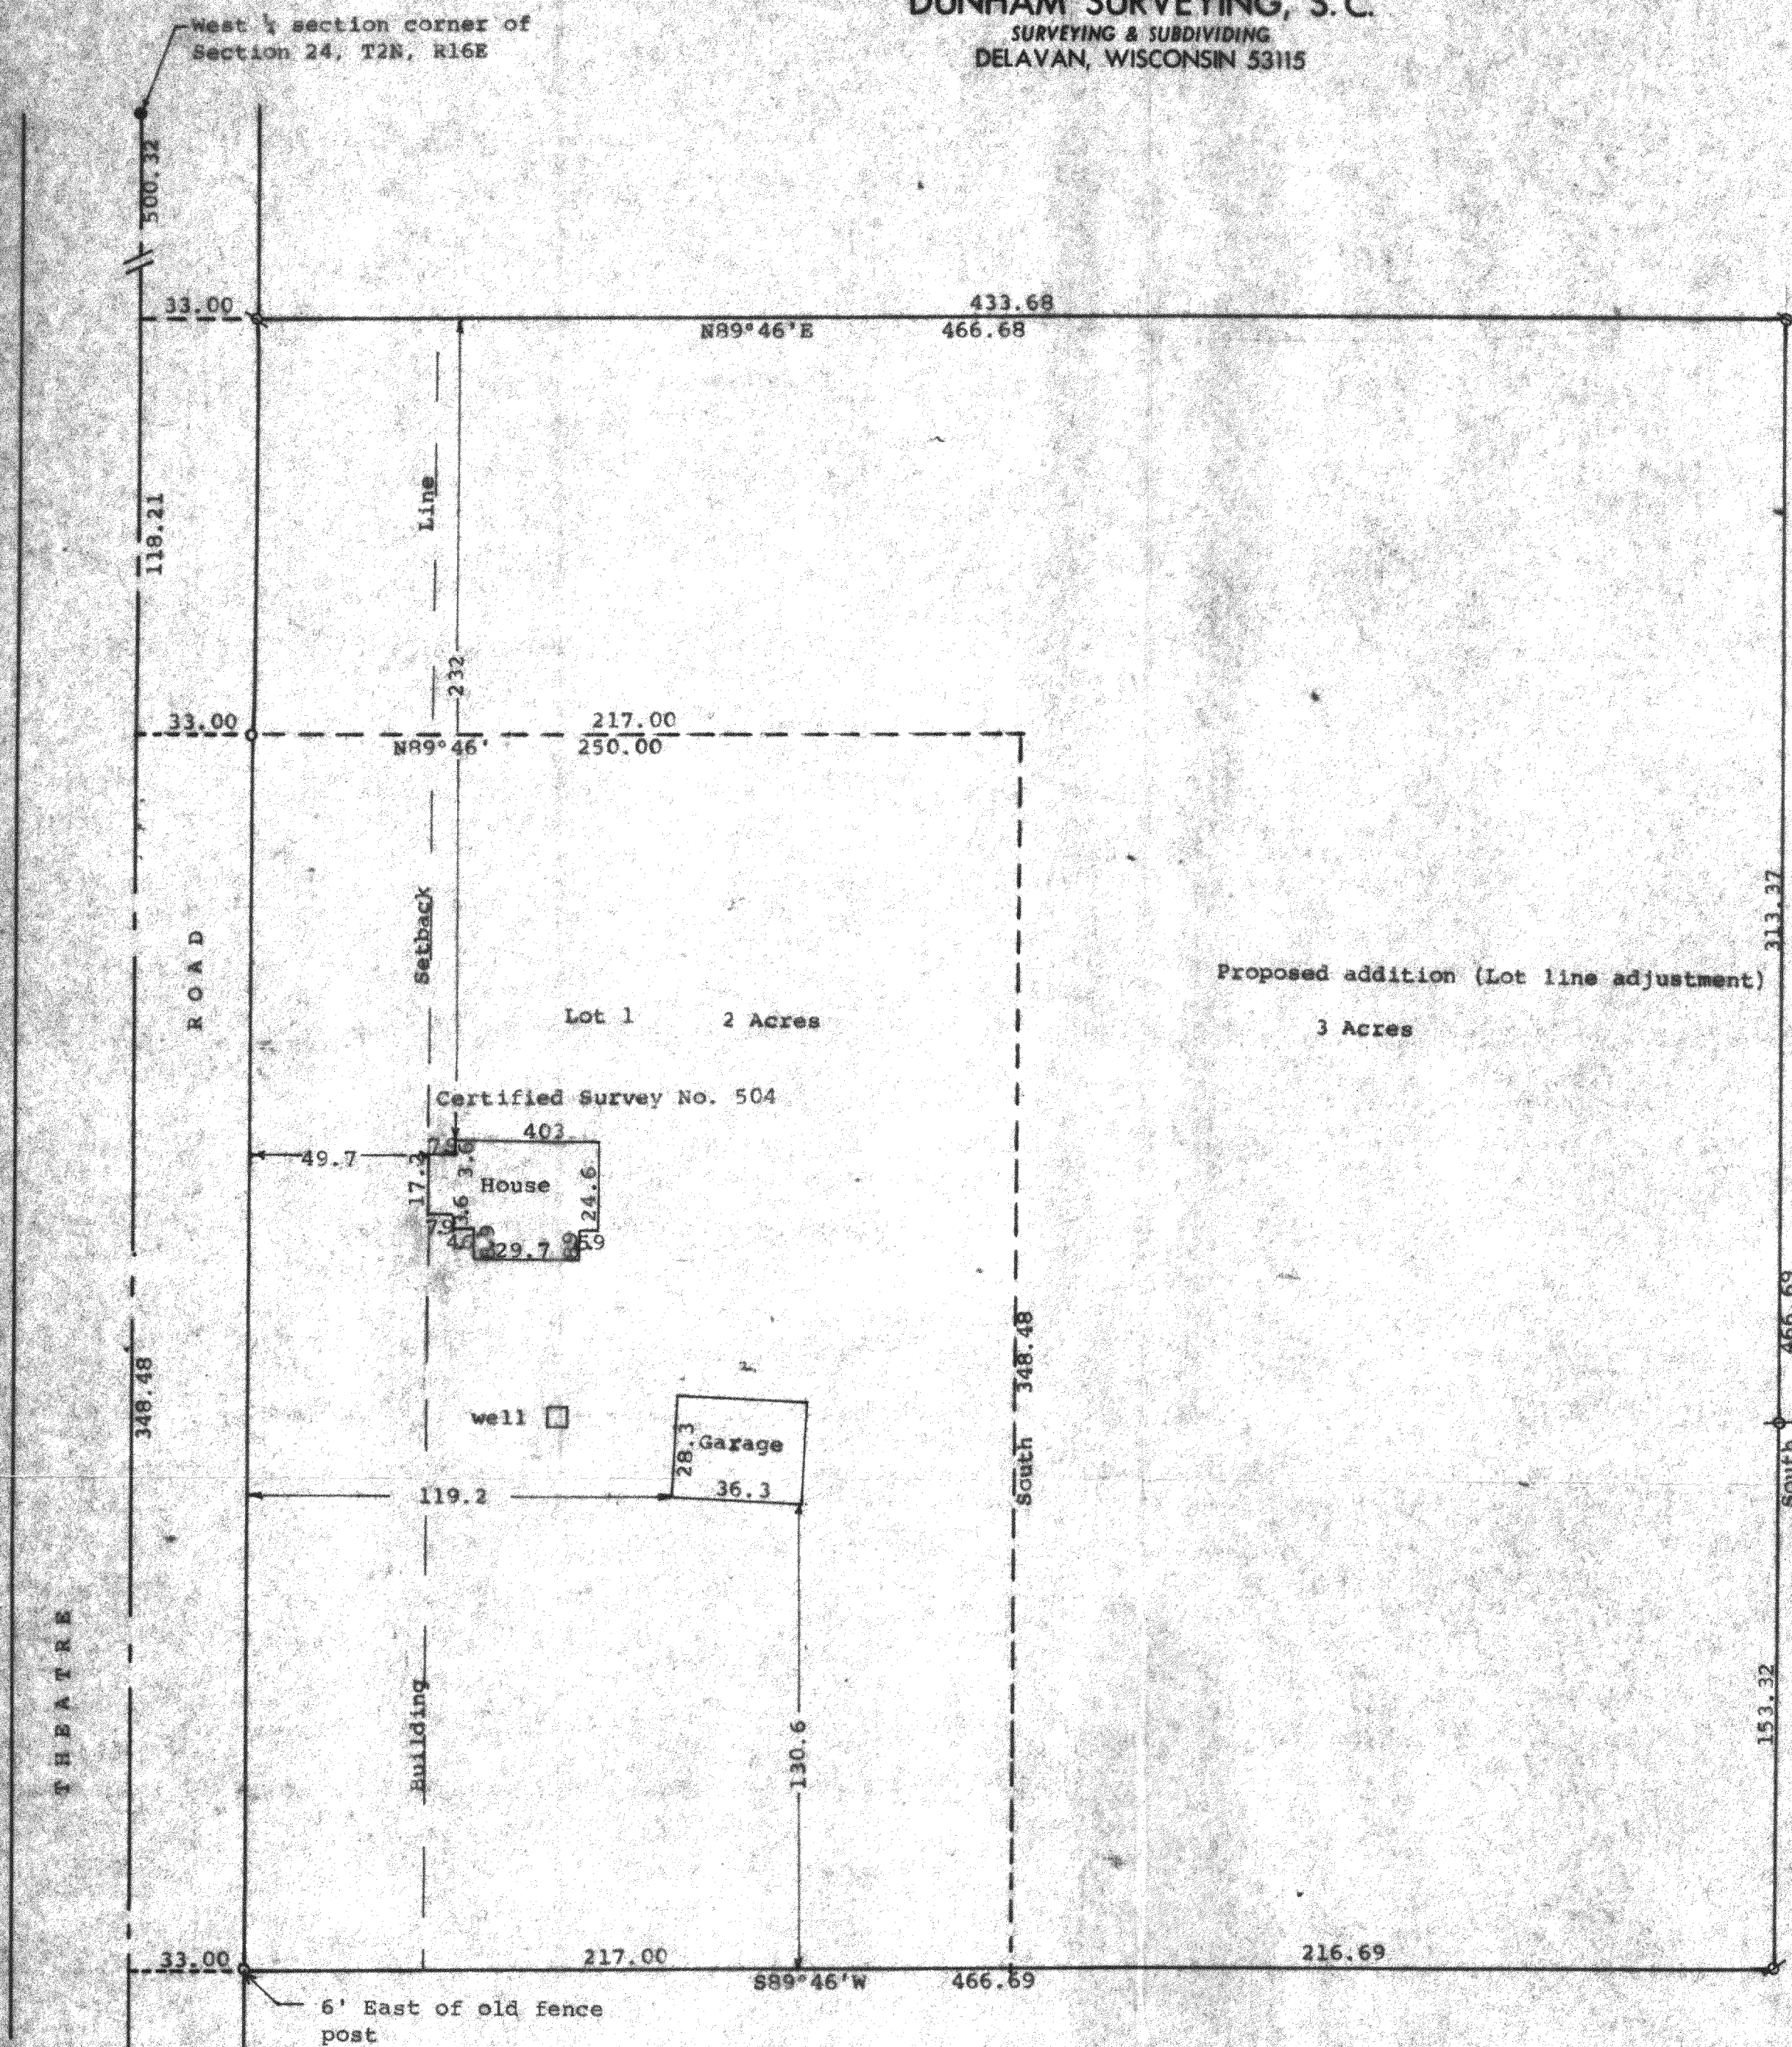

Scale - 1" = 40'

● = Concrete Monument Found

○ = 1" Iron Pipe Found

Survey ordered by:

Gerald Hartlaub

272 Park Place

Williams Bay, WI 53191

○ = 1 1/4" iron pipe Set

○ = 1" Iron Pipe Set

○ = 3/4" Iron Pipe Set

STATE OF WISCONSIN) ss
COUNTY OF WALWORTH)

I, George T. Dunham, Surveyor, certify that I have surveyed the property described as follows:

Lot 1 of Certified Survey No. 504, recorded in Volume 2 of Certified Surveys, Page 334, on July 18, 1975, in the Office of the Register of Deeds, Elkhorn, Wisconsin, Document No. 694014, being a parcel of land located in the Northwest 1/4 of the Southwest 1/4 of Section 24, T 2 N, R 16 E, Walworth County, Wisconsin, together with a parcel of land described as follows: Commencing at the West 1/4 corner of said section 24; thence South along the west line of said Northwest 1/4 of the Southwest 1/4, 500.32 feet to the place of beginning; thence N89°46'E 466.68 feet; thence South 466.69 feet; thence S89°46'W 216.69 feet to the southeast corner of said Certified Survey No. 504; thence North along the east line of said Certified Survey No. 504, 348.48 feet to the northeast corner of said Certified Survey No. 504; thence S89°46'W 250.00 feet to the northwest corner of said Certified Survey No. 504; thence North 118.21 feet to the place of beginning containing in all 5.0 acres of land.

March 11, 1997

and I further certify that the plat shown hereon is a correct representation thereof and shows the size and location of the property, its exterior boundaries, the location of all visible structures and dimensions of all principal buildings thereon, boundary fences, apparent easements, roadways and visible encroachments if any, and that I have surveyed the property hereon described, according to the official records, to the best of my knowledge and belief

October 17, 1997

George T. Dunham
George T. Dunham, Surveyor

George T. Dunham
George T. Dunham, Surveyor

