


Point Located 169.23 Feet
S89°-52'E of the Southwest Corner
of Lot 10 of Cedar Point Subdivision

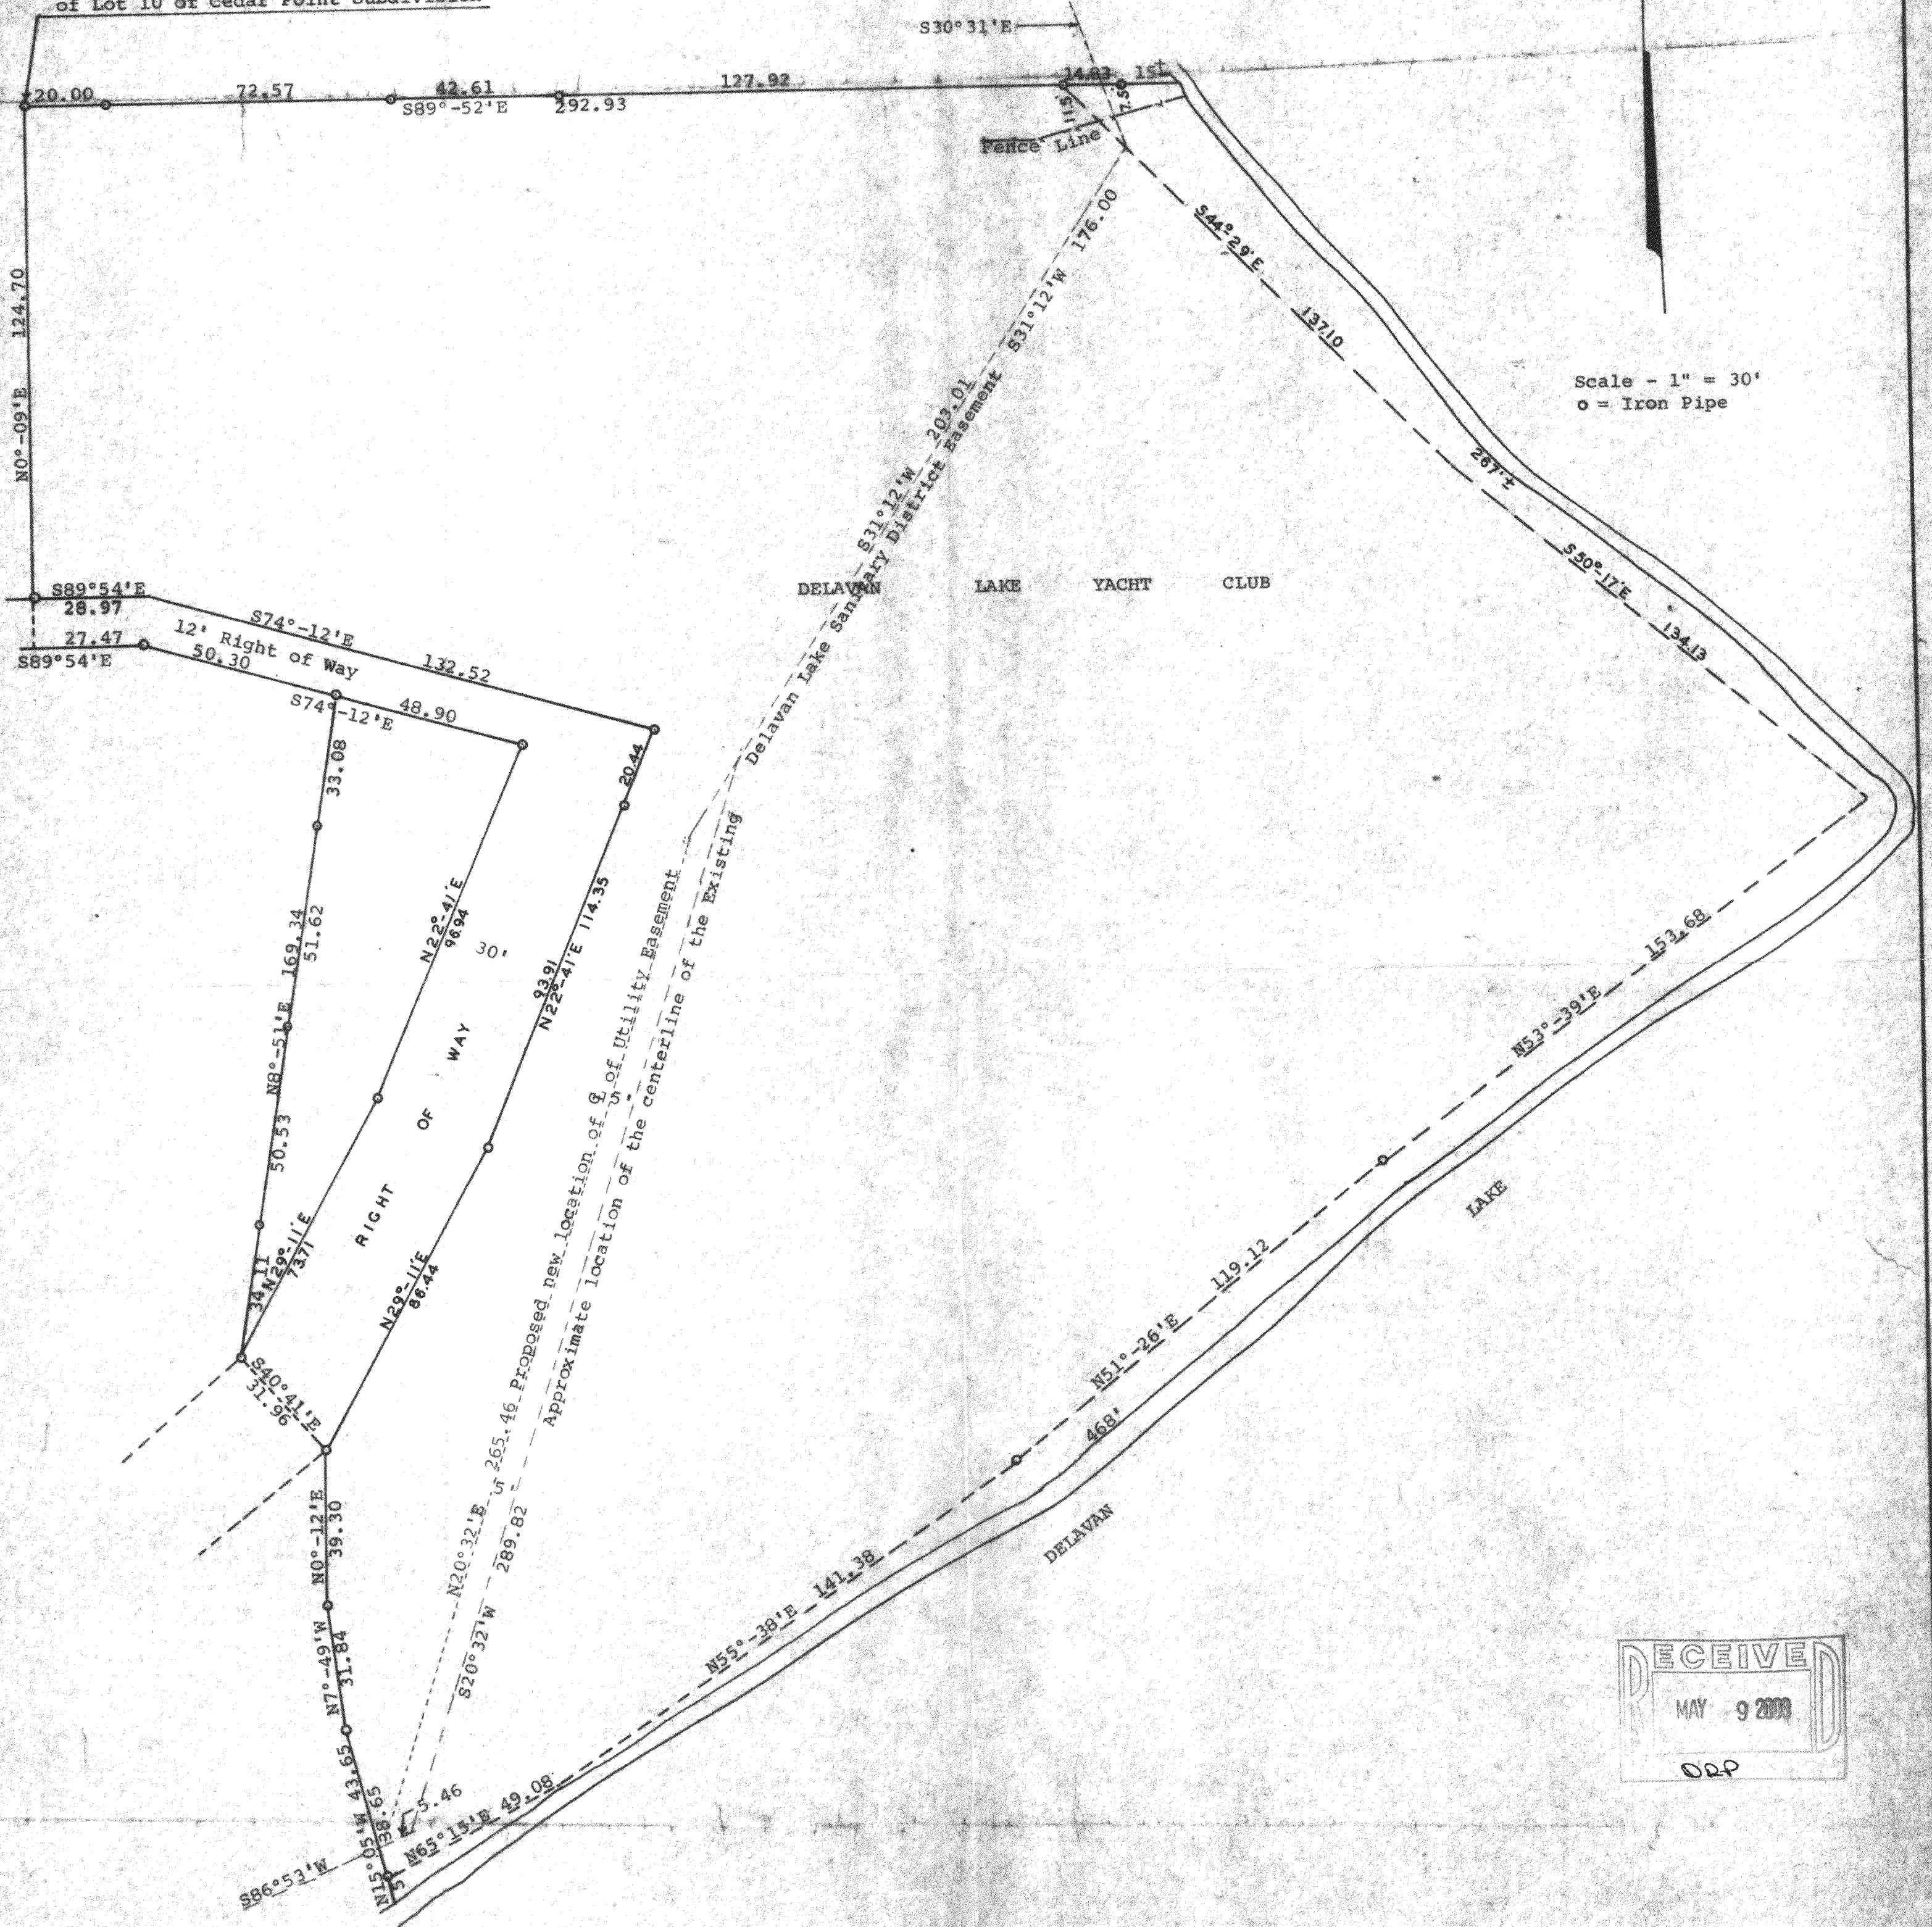

RECEIVED
MAY 9 2009
029

