


Deer Run, Delavan, Wisconsin


Revised Grade Left Front Pipe 6/15/04

949.36
EL

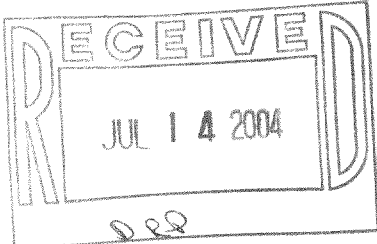

WISCONSIN

DENNIS C.
SAUER
S-2421
FRANKLIN,
WI

LAND SURVEYOR

Dennis C. Sauer
Registered Land Surveyor S-2421

FHP1 00013

216-3765