


LOT 13

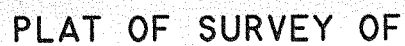

The diagram shows a property boundary with the following dimensions (clockwise from top-left):

- Top-left horizontal boundary: 35.3'
- Top-left vertical boundary: 22.0'
- Bottom-left vertical boundary: 27.3'
- Bottom-left vertical boundary: 24.0'
- Bottom horizontal boundary: 42.7'
- Right vertical boundary: 25.3'
- Right vertical boundary: 8.7'
- Right vertical boundary: 12.0'
- Top-right horizontal boundary: 11.7'
- Top-right vertical boundary: 2.0'
- Top-right horizontal boundary: 4.7'
- Top-right vertical boundary: 2.0'
- Top-right horizontal boundary: 5.0'
- Top-right vertical boundary: 2.0'
- Top horizontal boundary: 13.4'
- Top vertical boundary: 2.0'

Central text:

HOUSE DETAIL  
DETAIL NOT TO SCALE

Stamp in bottom-left corner:

EIVEN  
30 2007