

GRID NORTH
WISCONSIN STATE PLANE COORDINATE
SYSTEM - SOUTH ZONE (NAD-27)
N. LINE OF THE SE 1/4 OF SECTION 29-2-16
BEARS S 89°20'10" W

PLAT OF SURVEY

LOT 1 OF HAMLET OF DON SECOUR AND A 20' WIDE STRIP OF UNPLATTED LANDS

LOCATED IN PART OF GOVERNMENT LOTS 1 AND 2, SECTION 29, TOWN 2 NORTH,
RANGE 16 EAST, WALWORTH COUNTY, WISCONSIN




WORK ORDERED BY -
JORDT BUILDERS
168 ELKHORN ROAD
WILLIAMS BAY, WISCONSIN 53191

FARRIS, HANSEN & ASSOCIATES, INC.
ENGINEERING - ARCHITECTURE - SURVEYING
7 RIDGWAY COURT P.O. BOX 437
ELKHORN, WISCONSIN 53121
OFFICE: (262) 723-2098 FAX: (262) 723-5886

REVISIONS

PROJECT NO.
8401
DATE:
8/24/2011
SHEET NO.
1 OF 1

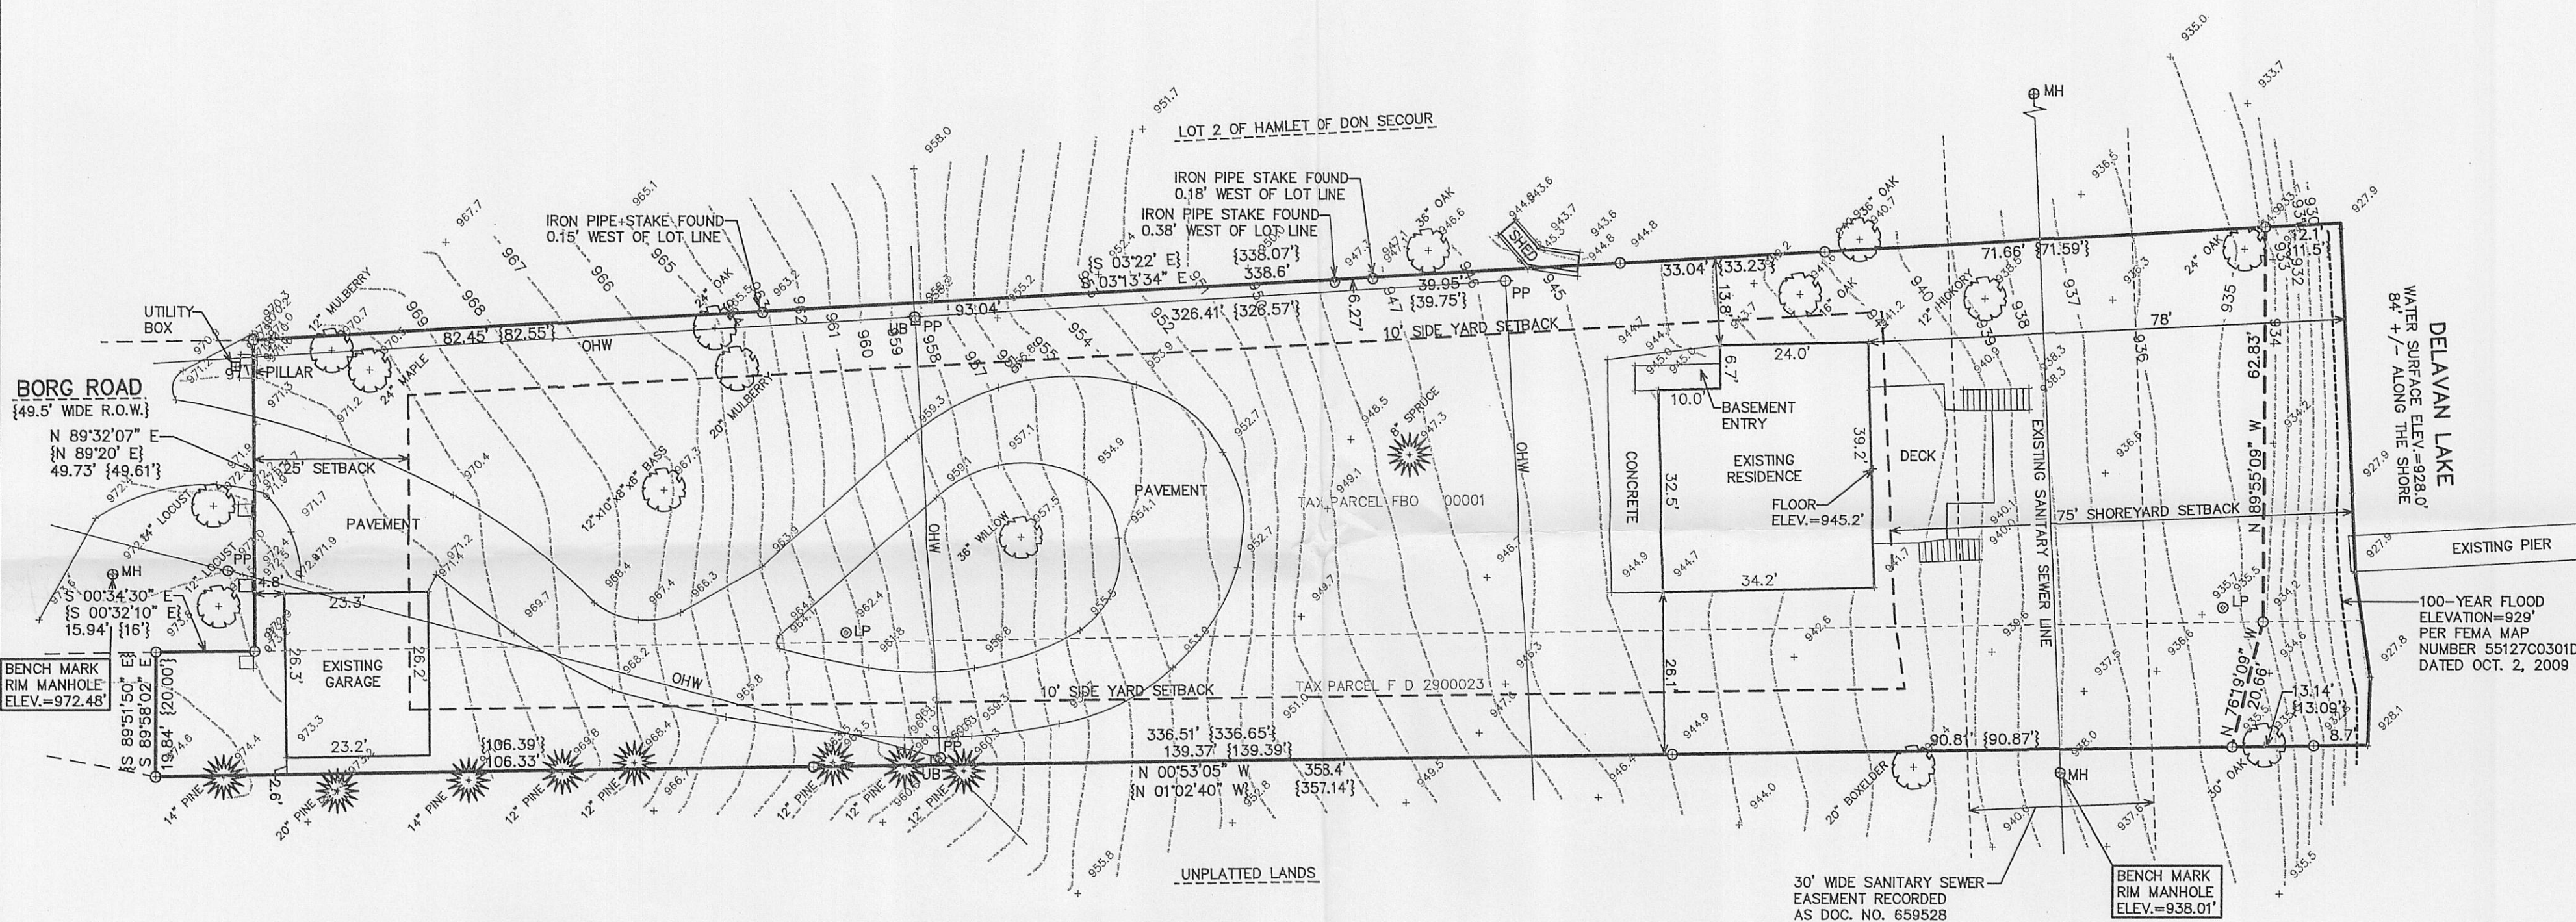


LEGEND

○ = 1" DIA. IRON PIPE STAKE FOUND

{xxx} = RECORDED AS

TOTAL LAND AREA = 26,320 SQ. FT. (0.60 ACRES)

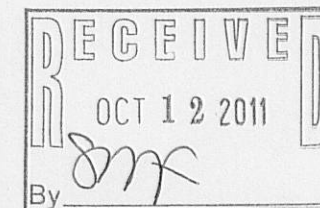


NOTE: COPIES OF THIS MAP TO WHICH THE FOLLOWING CERTIFICATE
WILL APPLY SHOW THE SURVEYOR'S ORIGINAL SEAL AND SIGNATURE
IN RED INK. COPIES BY ANY OTHER MEANS MAY HAVE ALTERATIONS
WHICH DO NOT REPRESENT THE SURVEYOR'S WORK PRODUCT.

I HEREBY CERTIFY THAT THE ABOVE DESCRIBED PROPERTY HAS BEEN
SURVEYED UNDER MY DIRECTION AND THAT THE ABOVE MAP IS A TRUE
REPRESENTATION THEREOF AND SHOWS THE SIZE AND LOCATION OF
THE PROPERTY AND ITS EXTERIOR BOUNDARIES. THIS SURVEY IS
MADE FOR THE USE OF THE PRESENT OWNERS OF THE PROPERTY, AND
ALSO THOSE WHO PURCHASE, MORTGAGE, OR GUARANTEE THE TITLE
THERE TO WITHIN ONE YEAR FROM THE DATE HEREOF.

DATE: AUGUST 24, 2011

PETER S. GORDON
R.L.S. 2101

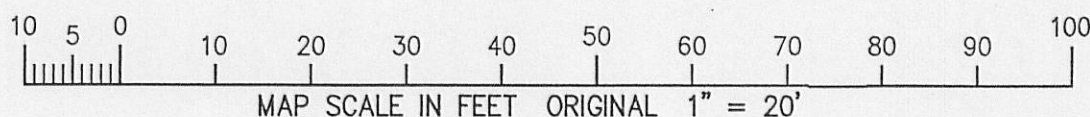

8/24/2011 x:\Projects\8401\Doc\TOPO_20110824

FA4371-1

216-4886