PLAT OF SURVEY & TOPOGRAPHIC MAPPING

LOT 9 OF ST. MARY'S OF DELAVAN LAKE

LOCATED IN PART OF THE SOUTHEAST 1/4 OF THE NORTHWEST 1/4 OF SECTION 28,
TOWN 2 NORTH, RANGE 16 EAST, WALWORTH COUNTY, WISCONSIN

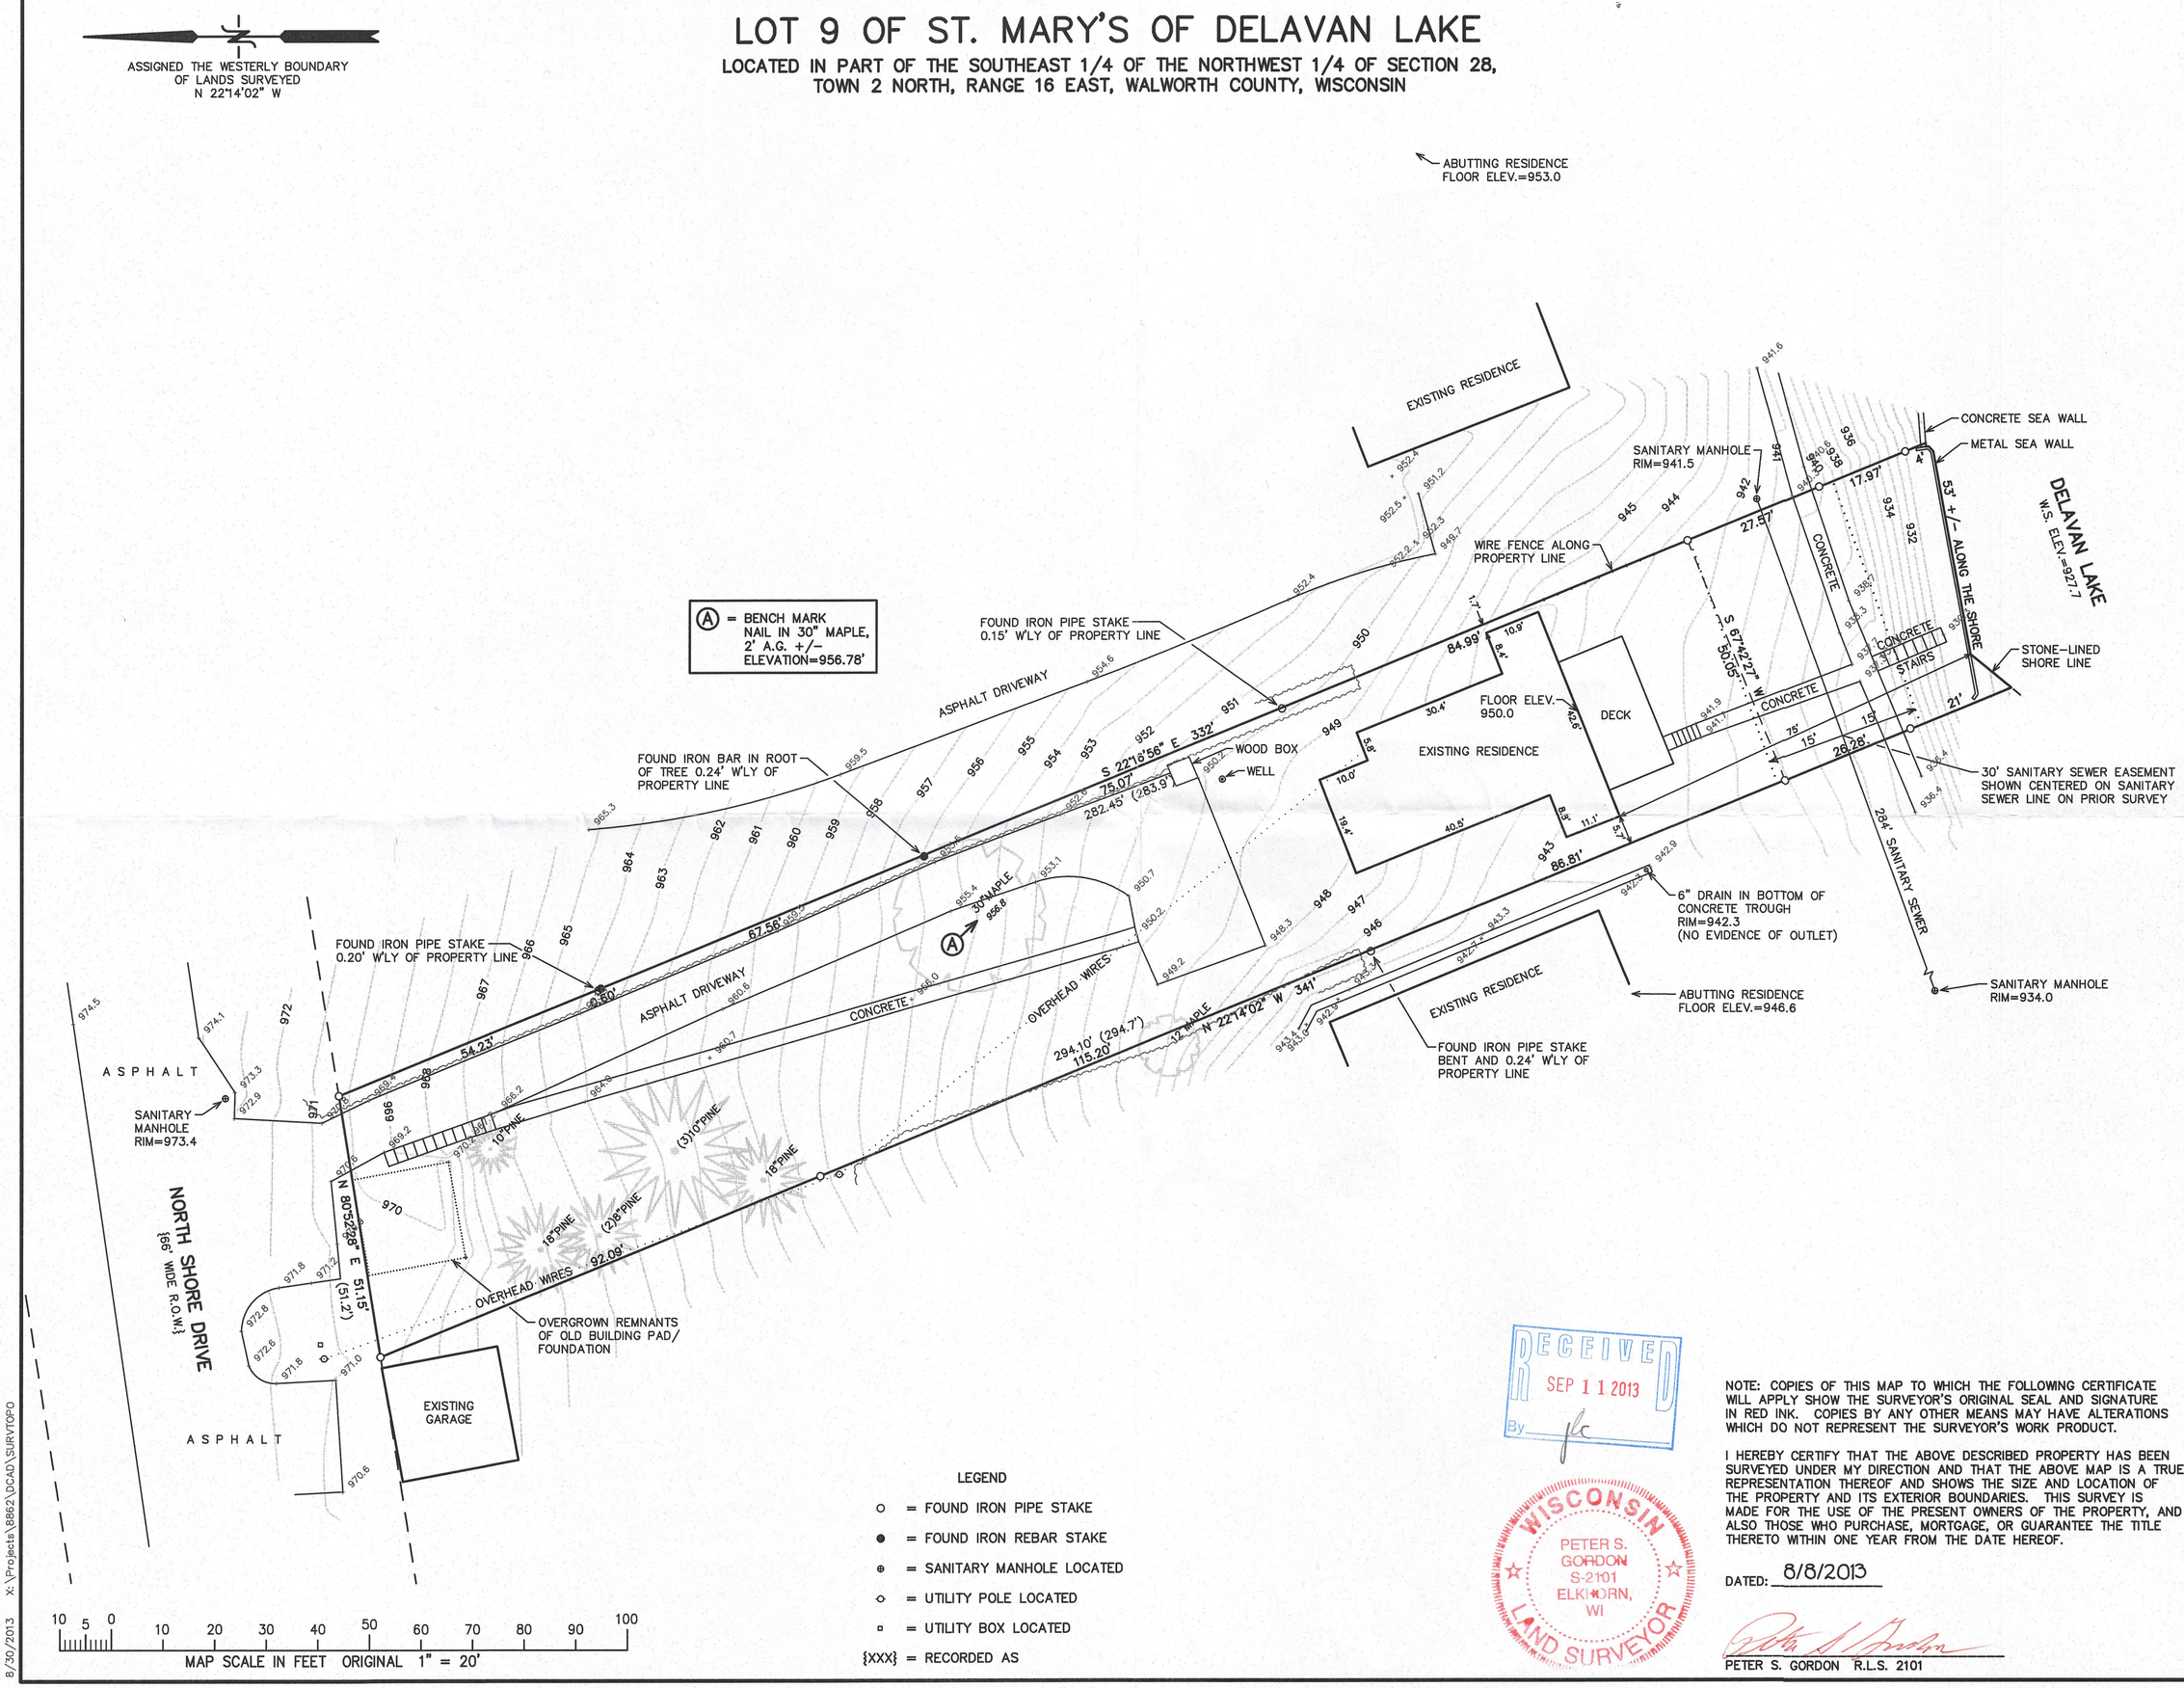

LEGEND

- ○ = FOUND IRON PIPE STAKE
- ● = FOUND IRON REBAR STAKE
- ⊕ = SANITARY MANHOLE LOCATED
- ◇ = UTILITY POLE LOCATED
- ▫ = UTILITY BOX LOCATED
- {XXX} = RECORDED AS

RECEIVED SEP 11 2013 By jlc

WISCONSIN PETER S. GORDON S-2101 ELKHORN, WI LAND SURVEYOR

NOTE: COPIES OF THIS MAP TO WHICH THE FOLLOWING CERTIFICATE WILL APPLY SHOW THE SURVEYOR'S ORIGINAL SEAL AND SIGNATURE IN RED INK. COPIES BY ANY OTHER MEANS MAY HAVE ALTERATIONS WHICH DO NOT REPRESENT THE SURVEYOR'S WORK PRODUCT.

I HEREBY CERTIFY THAT THE ABOVE DESCRIBED PROPERTY HAS BEEN SURVEYED UNDER MY DIRECTION AND THAT THE ABOVE MAP IS A TRUE REPRESENTATION THEREOF AND SHOWS THE SIZE AND LOCATION OF THE PROPERTY AND ITS EXTERIOR BOUNDARIES. THIS SURVEY IS MADE FOR THE USE OF THE PRESENT OWNERS OF THE PROPERTY, AND ALSO THOSE WHO PURCHASE, MORTGAGE, OR GUARANTEE THE TITLE THERETO WITHIN ONE YEAR FROM THE DATE HEREOF.

DATED: 8/8/2013

PETER S. GORDON R.L.S. 2101

PLAT OF SURVEY
TOPOGRAPHIC MAPPING

– WORK ORDERED BY –
CHOYCE GROUP
168 ELKHORN ROAD
WILLIAMS BAY, WI 53191

FARRIS, HANSEN & ASSOCIATES, INC.
ENGINEERING – ARCHITECTURE – SURVEYING
7 RIDGWAY COURT P.O. BOX 437
ELKHORN, WISCONSIN 53121
OFFICE: (262) 723-2098 FAX: (262) 723-5886

REVISIONS

PROJECT NO.	8862
DATE:	08/08/2013
SHEET NO.	1 OF 1

8/30/2013 X:\Projects\8862\DCAD\SURVTOPO

FS-5 216-5040