
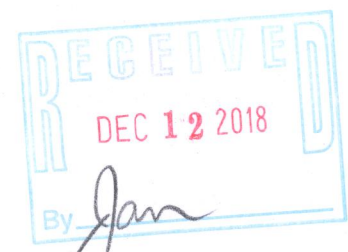


PLAT OF SURVEY OF LOT 4 AND THE NORTHEASTERLY 10 FEET OF LOT 5, BAILEY SUBDIVISION, BEING PART OF THE SE 1/4 AND SW 1/4 OF THE NW 1/4 OF SECTION 27, T. 2 N., R. 16 E., WALWORTH COUNTY, WISCONSIN

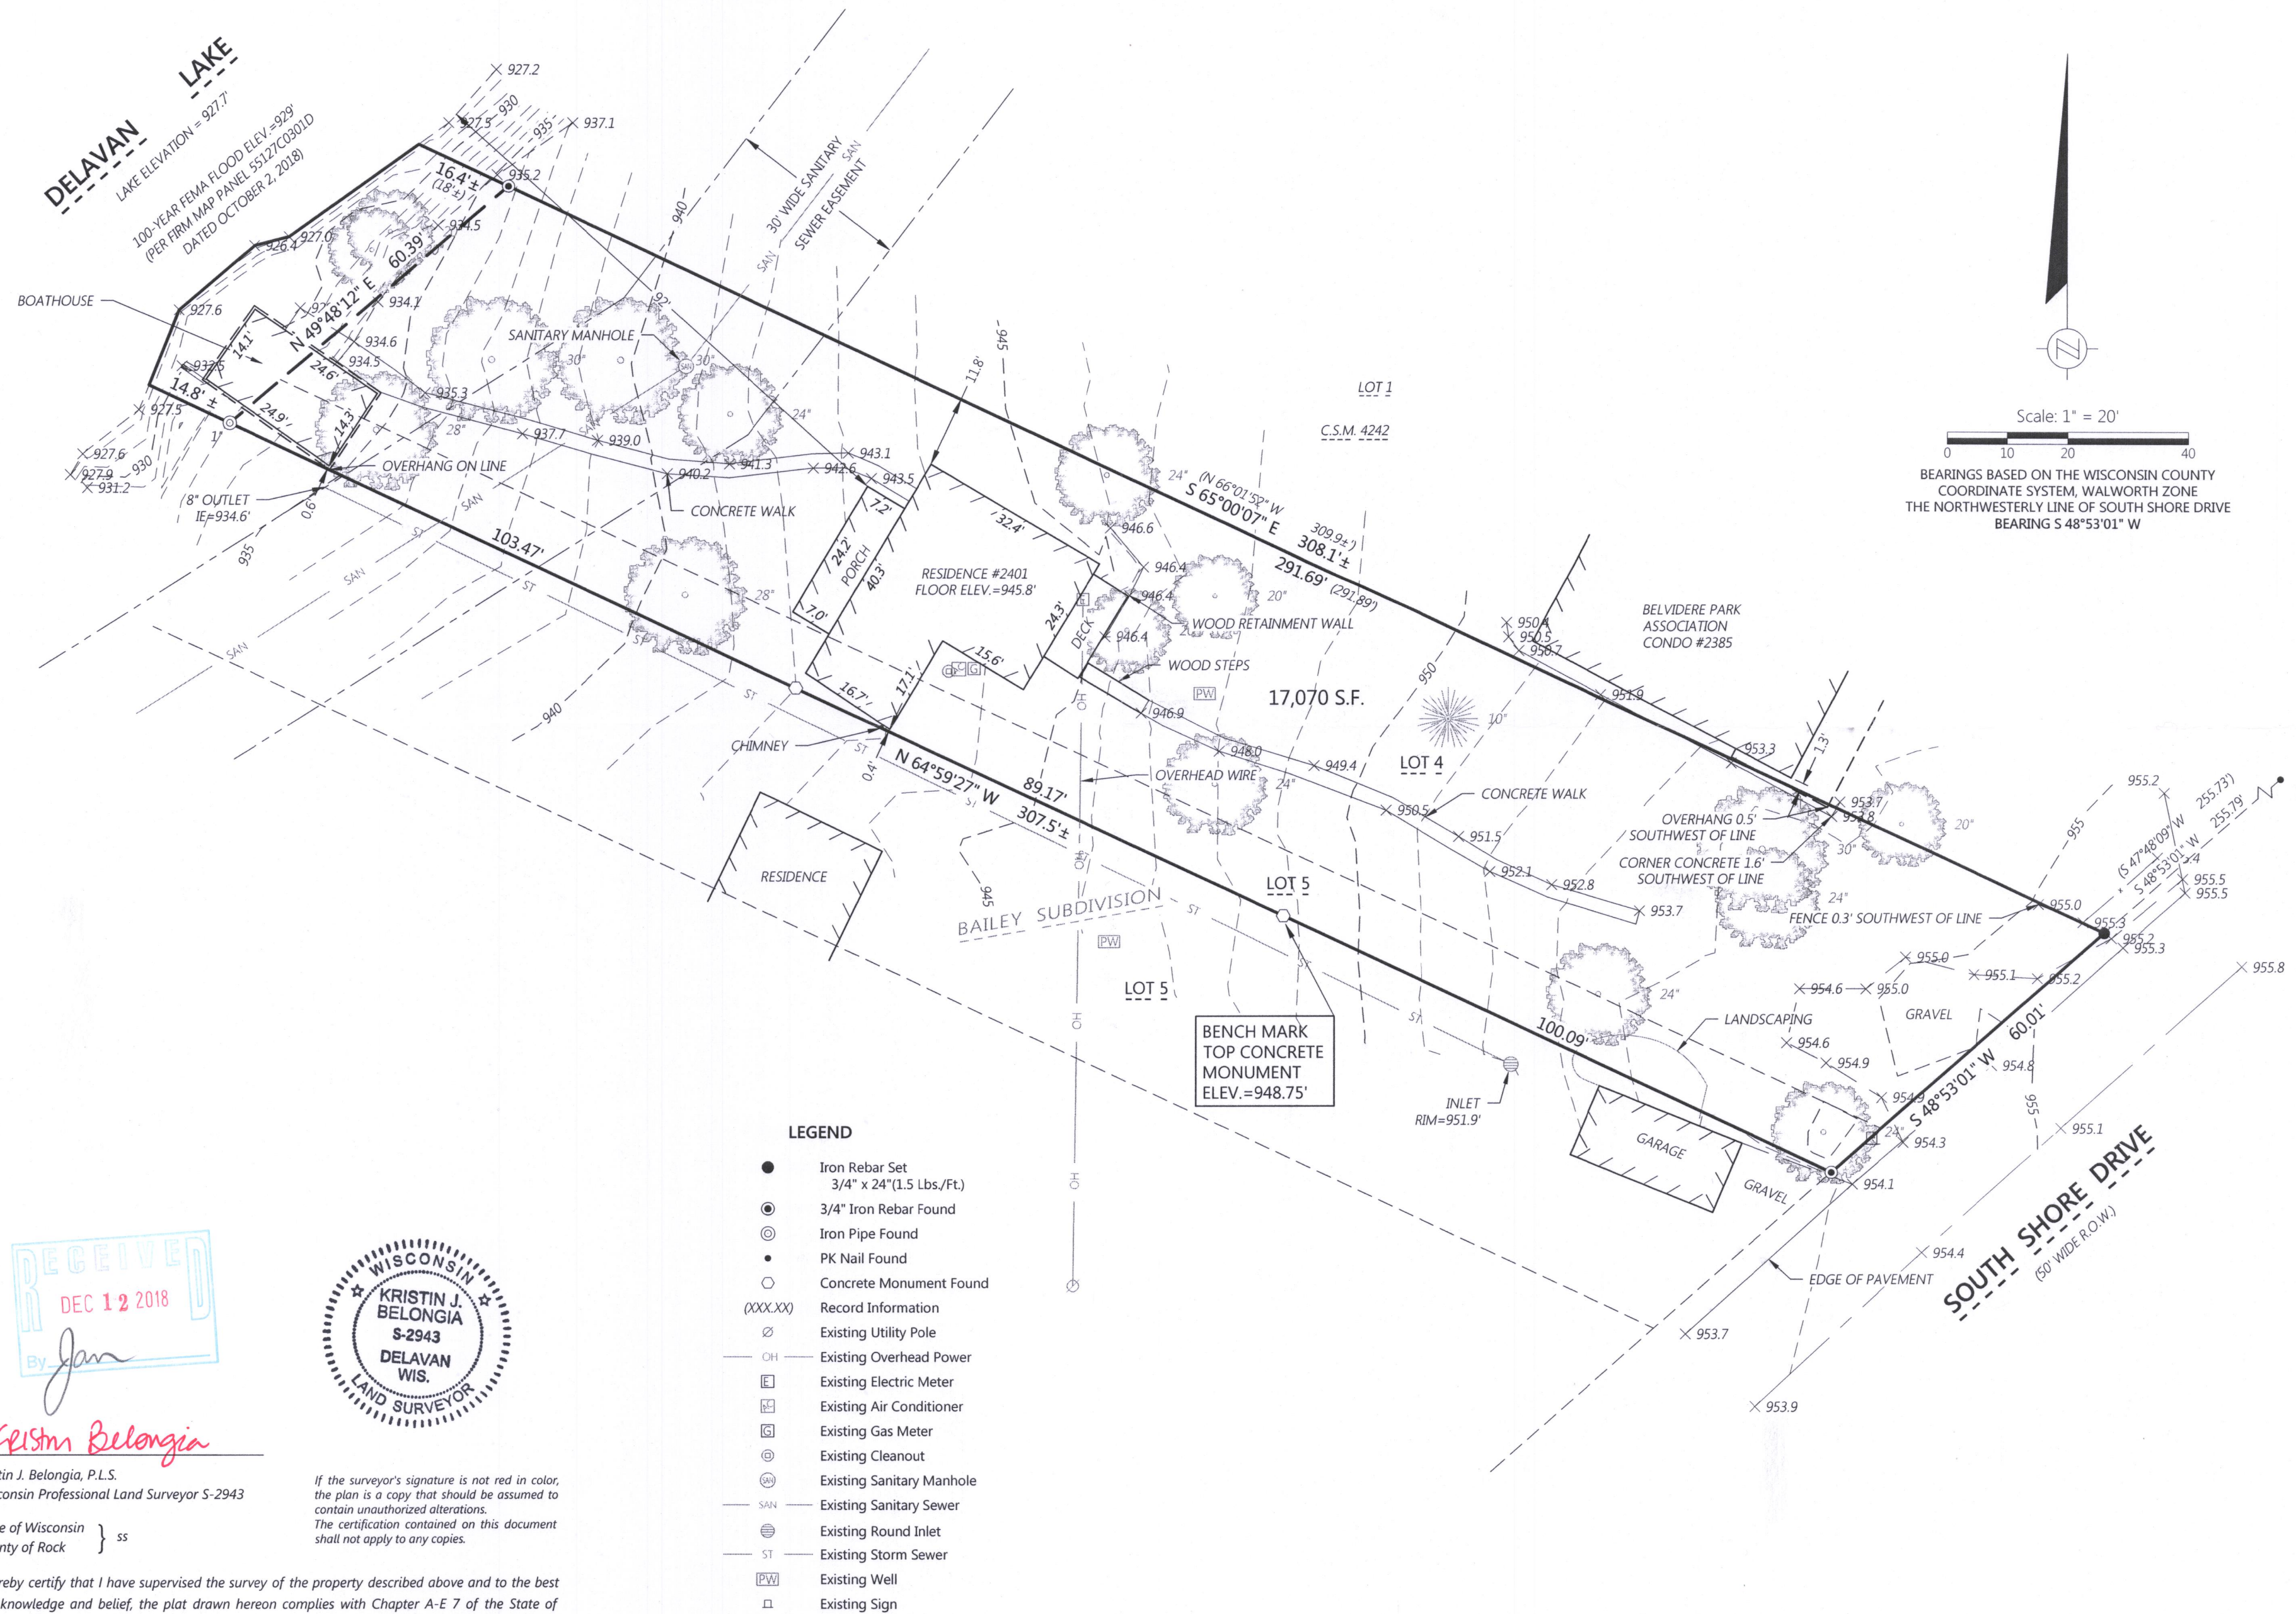

Kristin Belongia
 Kristin J. Belongia, P.L.S.
 Wisconsin Professional Land Surveyor S-2943

State of Wisconsin
 County of Rock } ss

I hereby certify that I have supervised the survey of the property described above and to the best of my knowledge and belief, the plat drawn hereon complies with Chapter A-E 7 of the State of Wisconsin Administrative Code, Minimum Standards for Property Surveys and correctly represents said survey and its location.
 Given under my hand and seal this 18th day of September, 2018 at Beloit, Wisconsin.
 Last day of field work September 14, 2018



If the surveyor's signature is not red in color, the plan is a copy that should be assumed to contain unauthorized alterations.
 The certification contained on this document shall not apply to any copies.