

PLAT OF SURVEY

LOCATION: Windmill Avenue, Delavan, Wisconsin


LEGAL DESCRIPTION:

Lot 27 in **DUTCH MEADOWS**, located in the Northwest 1/4, Southwest 1/4, and Southeast 1/4 of the Northwest 1/4 of Section 31, Town 2 North, range 16 East, Walworth County, Wisconsin

October 31, 2018

November 6, 2018 Collected Topography

Survey No. 110177

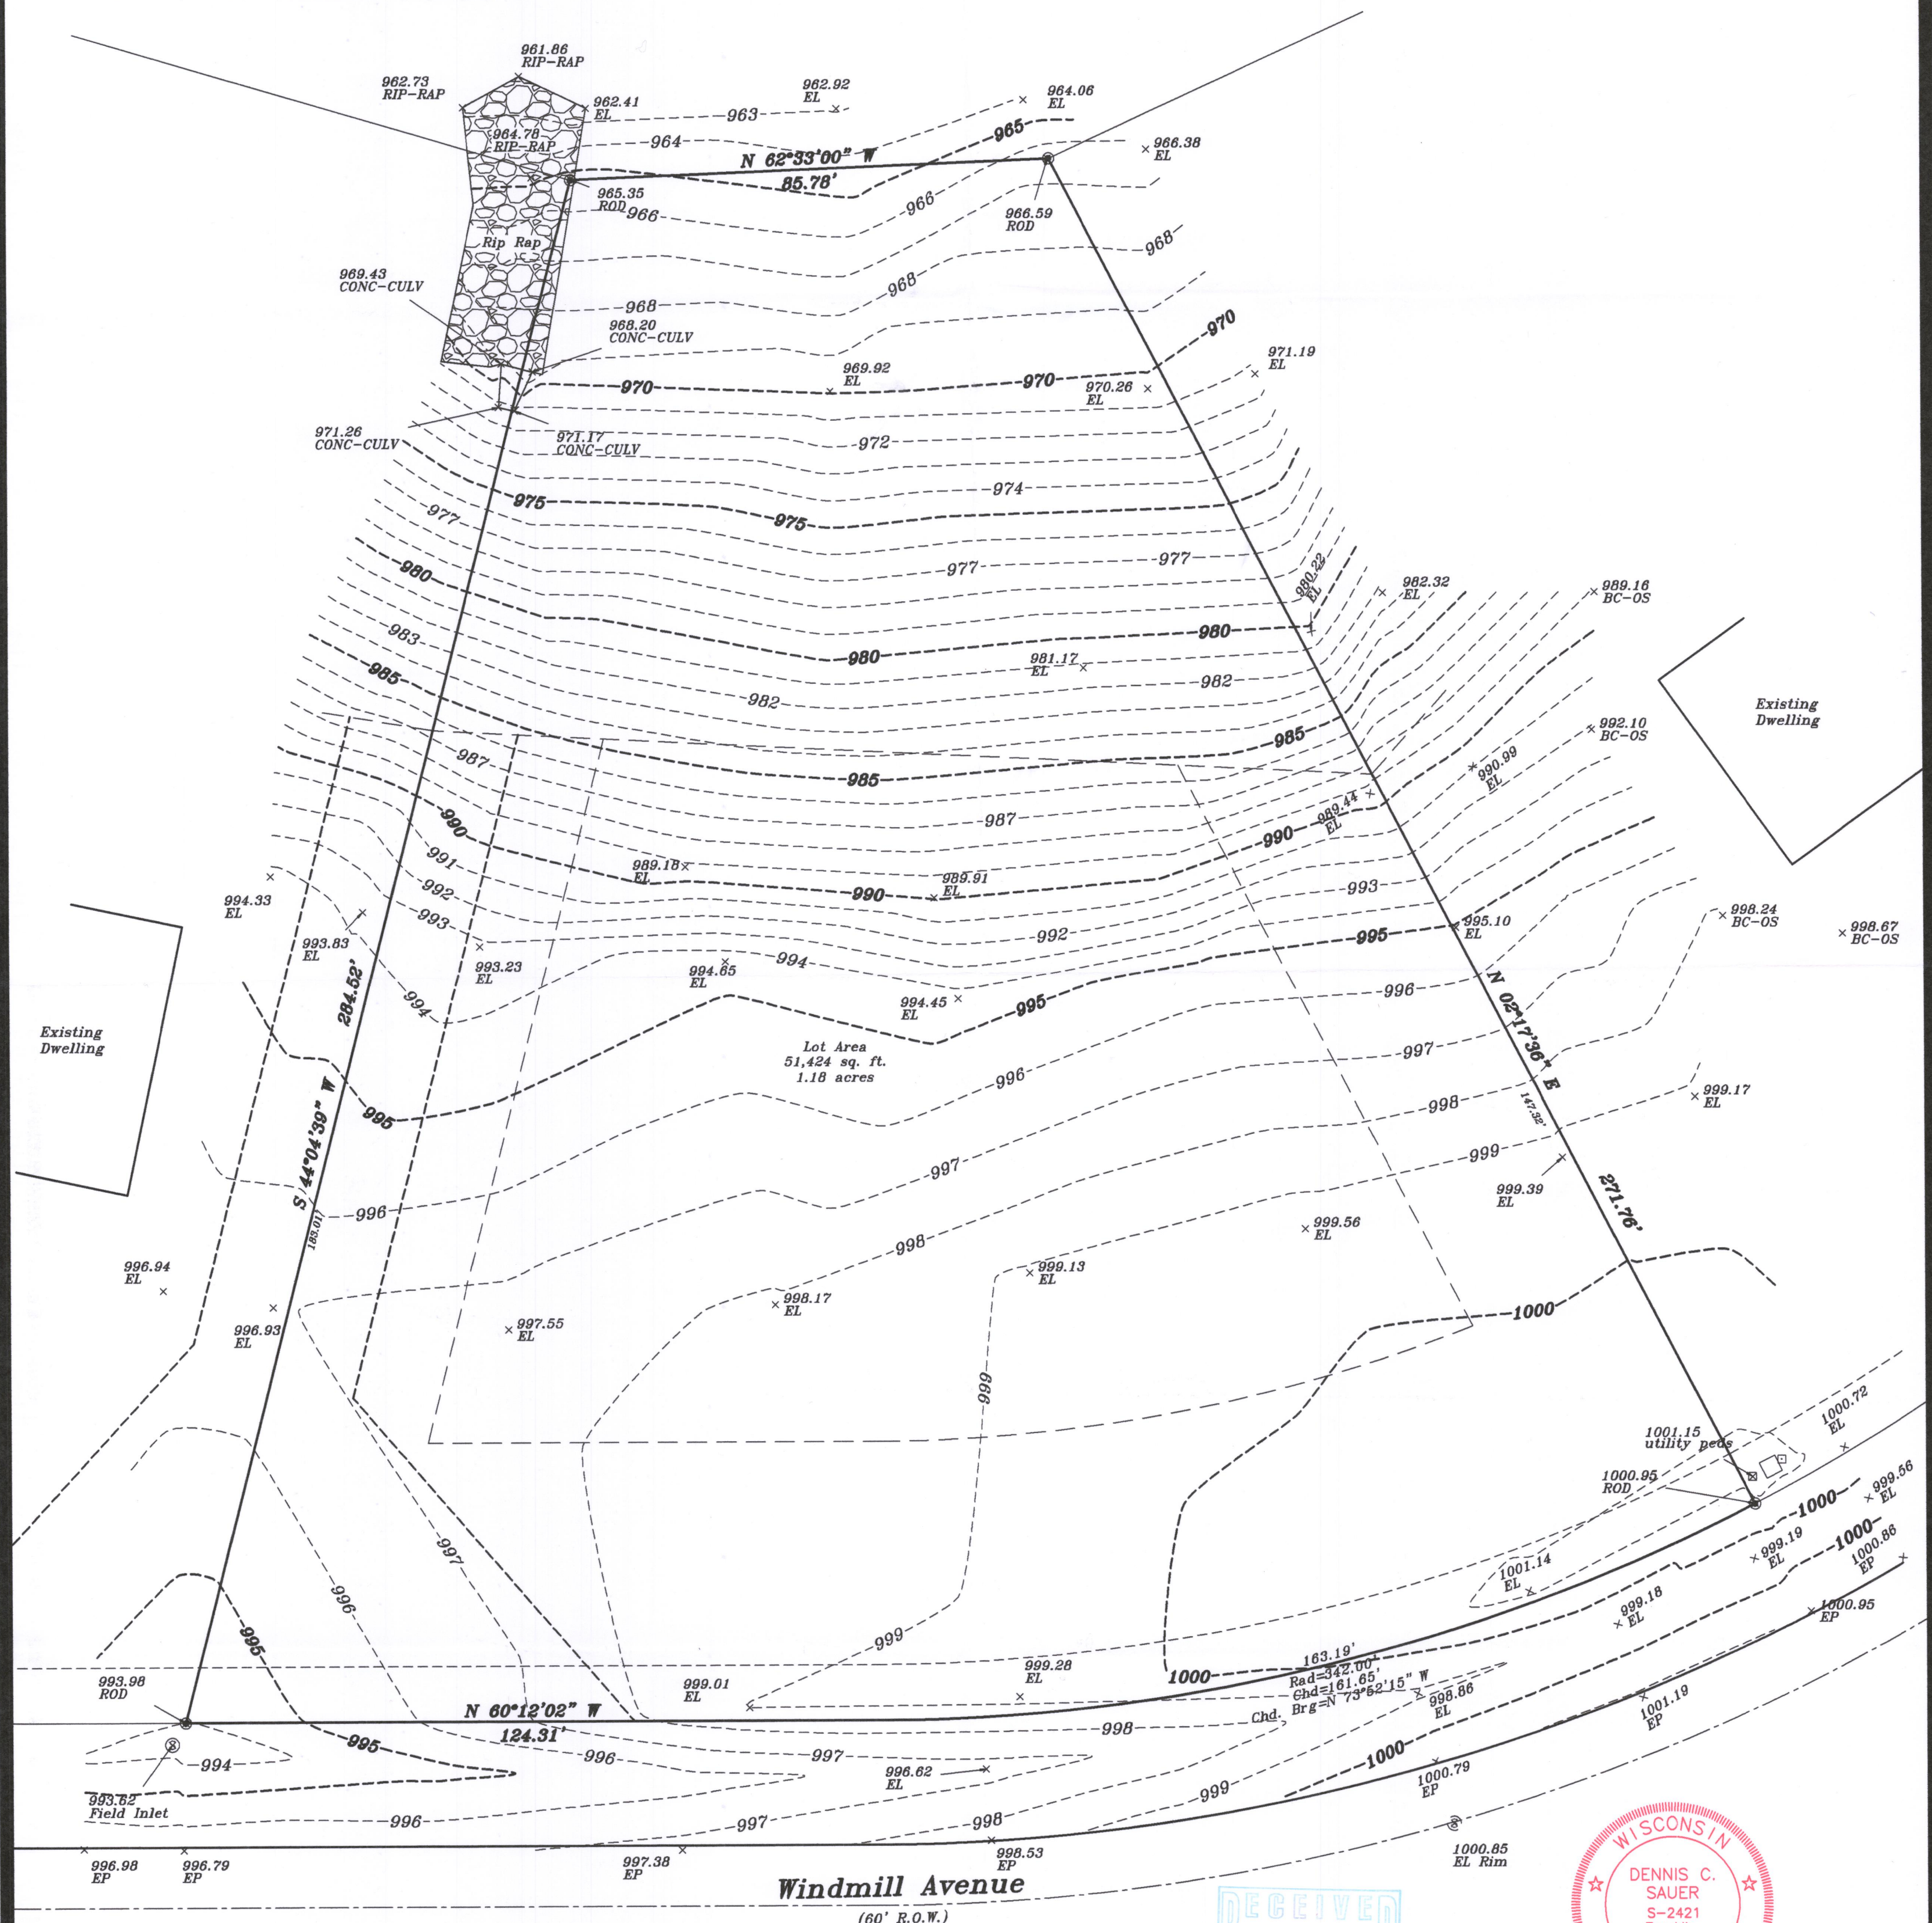

METROPOLITAN SURVEY SERVICE, INC.

PROFESSIONAL LAND SURVEYORS AND CIVIL ENGINEERS


9415 West Forest Home Avenue, Suite 202
Hales Corners, Wisconsin 53130

PH. (414) 529-5380 FAX (414) 529-9787
email address: survey@metropolitansurvey.com


⊙ — Denotes Iron Rod Found

○ — Denotes Iron Pipe Set

GRAPHIC SCALE

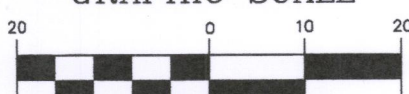

(IN FEET)
1 inch = 20 ft.

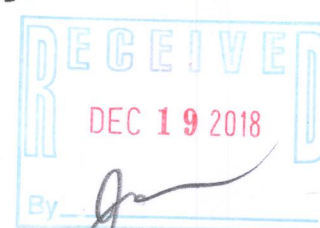

I HEREBY CERTIFY THAT I HAVE SURVEYED THE ABOVE DESCRIBED PROPERTY AND THAT THE ABOVE MAP IS A TRUE REPRESENTATION THEREOF AND SHOWS THE SIZE AND LOCATION OF THE PROPERTY, ITS EXTERIOR BOUNDARIES, THE LOCATION OF ALL VISIBLE STRUCTURES AND DIMENSIONS OF ALL PRINCIPAL BUILDINGS THEREON, BOUNDARY FENCES, APPARENT EASEMENTS AND ROADWAYS AND VISIBLE ENCROACHMENT, IF ANY.

THIS SURVEY IS MADE FOR THE EXCLUSIVE USE OF THE PRESENT OWNERS OF THE PROPERTY, AND ALSO THOSE WHO PURCHASE, MORTGAGE, OR GUARANTEE THE TITLE THERETO WITHIN ONE (1) YEAR FROM THE DATE HEREOF.

SIGNED

Dennis C. Sauer

Dennis C. Sauer

Professional Land Surveyor S-2421

FduT-27 216-5541