Plat of Survey

A Proposed 1 Lot Certified Survey Map,

A Portion of Tax Parcel F D 1000001A,

located in the Northwest 1/4 of Section 10, Town 2 North, Range 16 East, Town of Delavan, Walworth County, Wisconsin.

Record Description of Tax Parcel F D 1000001A

A parcel of land described in a Personal Representative's Deed recorded on May 17, 2004 as Document No. 603487, as shown below:


That part of NW 1/4 of Section 10, T2N, R16E, N.W. of railroad and Southeast of highway, Town of Delavan, Walworth County, Wisconsin. Also described as: Being all of the N.W. 1/4 of Section No. 10 in the Township of Delavan in said County and State which lies N. of the Chicago, Milwaukee and St. Paul Railway Company lands and S. of the highway leading from Delavan to Elkhorn, and West of the highway running North and South through said quarter section.

Surveyed for: Betty J.M. Crosby 6075 Highway 11 Elkhorn, Wisconsin. 53121



Bearings referenced to the North line of the Northwest 1/4 of Section 10-2-16, recorded as N88°09'42"E in the Wisconsin State Plane Coordinate System,

Coordinates are referenced to the Wisconsin State Plane Coordinate System, South Zone, (NAD-27).

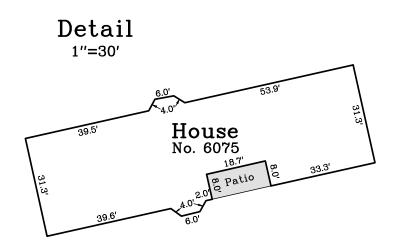



- 1) This Plat of Survey is not certified unless signed and sealed in red ink.
- 2) This survey is subject to Wisconsin lien laws. This Plat of Survey is the notice of intent to file lien. Lien waiver required.
- 3) The Survey Date shown on this Plat of Survey is the completion date of the field work.

Copyright © 2022 by Olson Land Surveying, LLC.

All rights reserved. No part of this survey plat may be reproduced or transmitted in any form by any means - graphic, electronic, or mechanical, including photocopying, tracing, or information storage and retrieval systems - without permission in writing from Douglas G. Olson, Olson Land Surveying, LLC.

I hereby certify that I have surveyed the above described property in compliance with Chapter A-E 7 of the Wisconsin Administrative Code and that the map hereon is correct to the best of my professional knowledge and belief and shows the size and location of the property, its exterior boundaries, the location and dimensions of all visible structures thereon, boundary fences, apparent easements and roadways and visible encroachments, if any.

This survey is made for the exclusive use of the present owners of the property, and also those who purchase, mortgage or guarantee title thereto, within one year from the date hereof.

Wisconsin Professional Land Surveyor - 2093

