


DUNHAM SURVEYING, S.C.  
SURVEYING & SUBDIVIDING  
DELAVER, WISCONSIN 53115

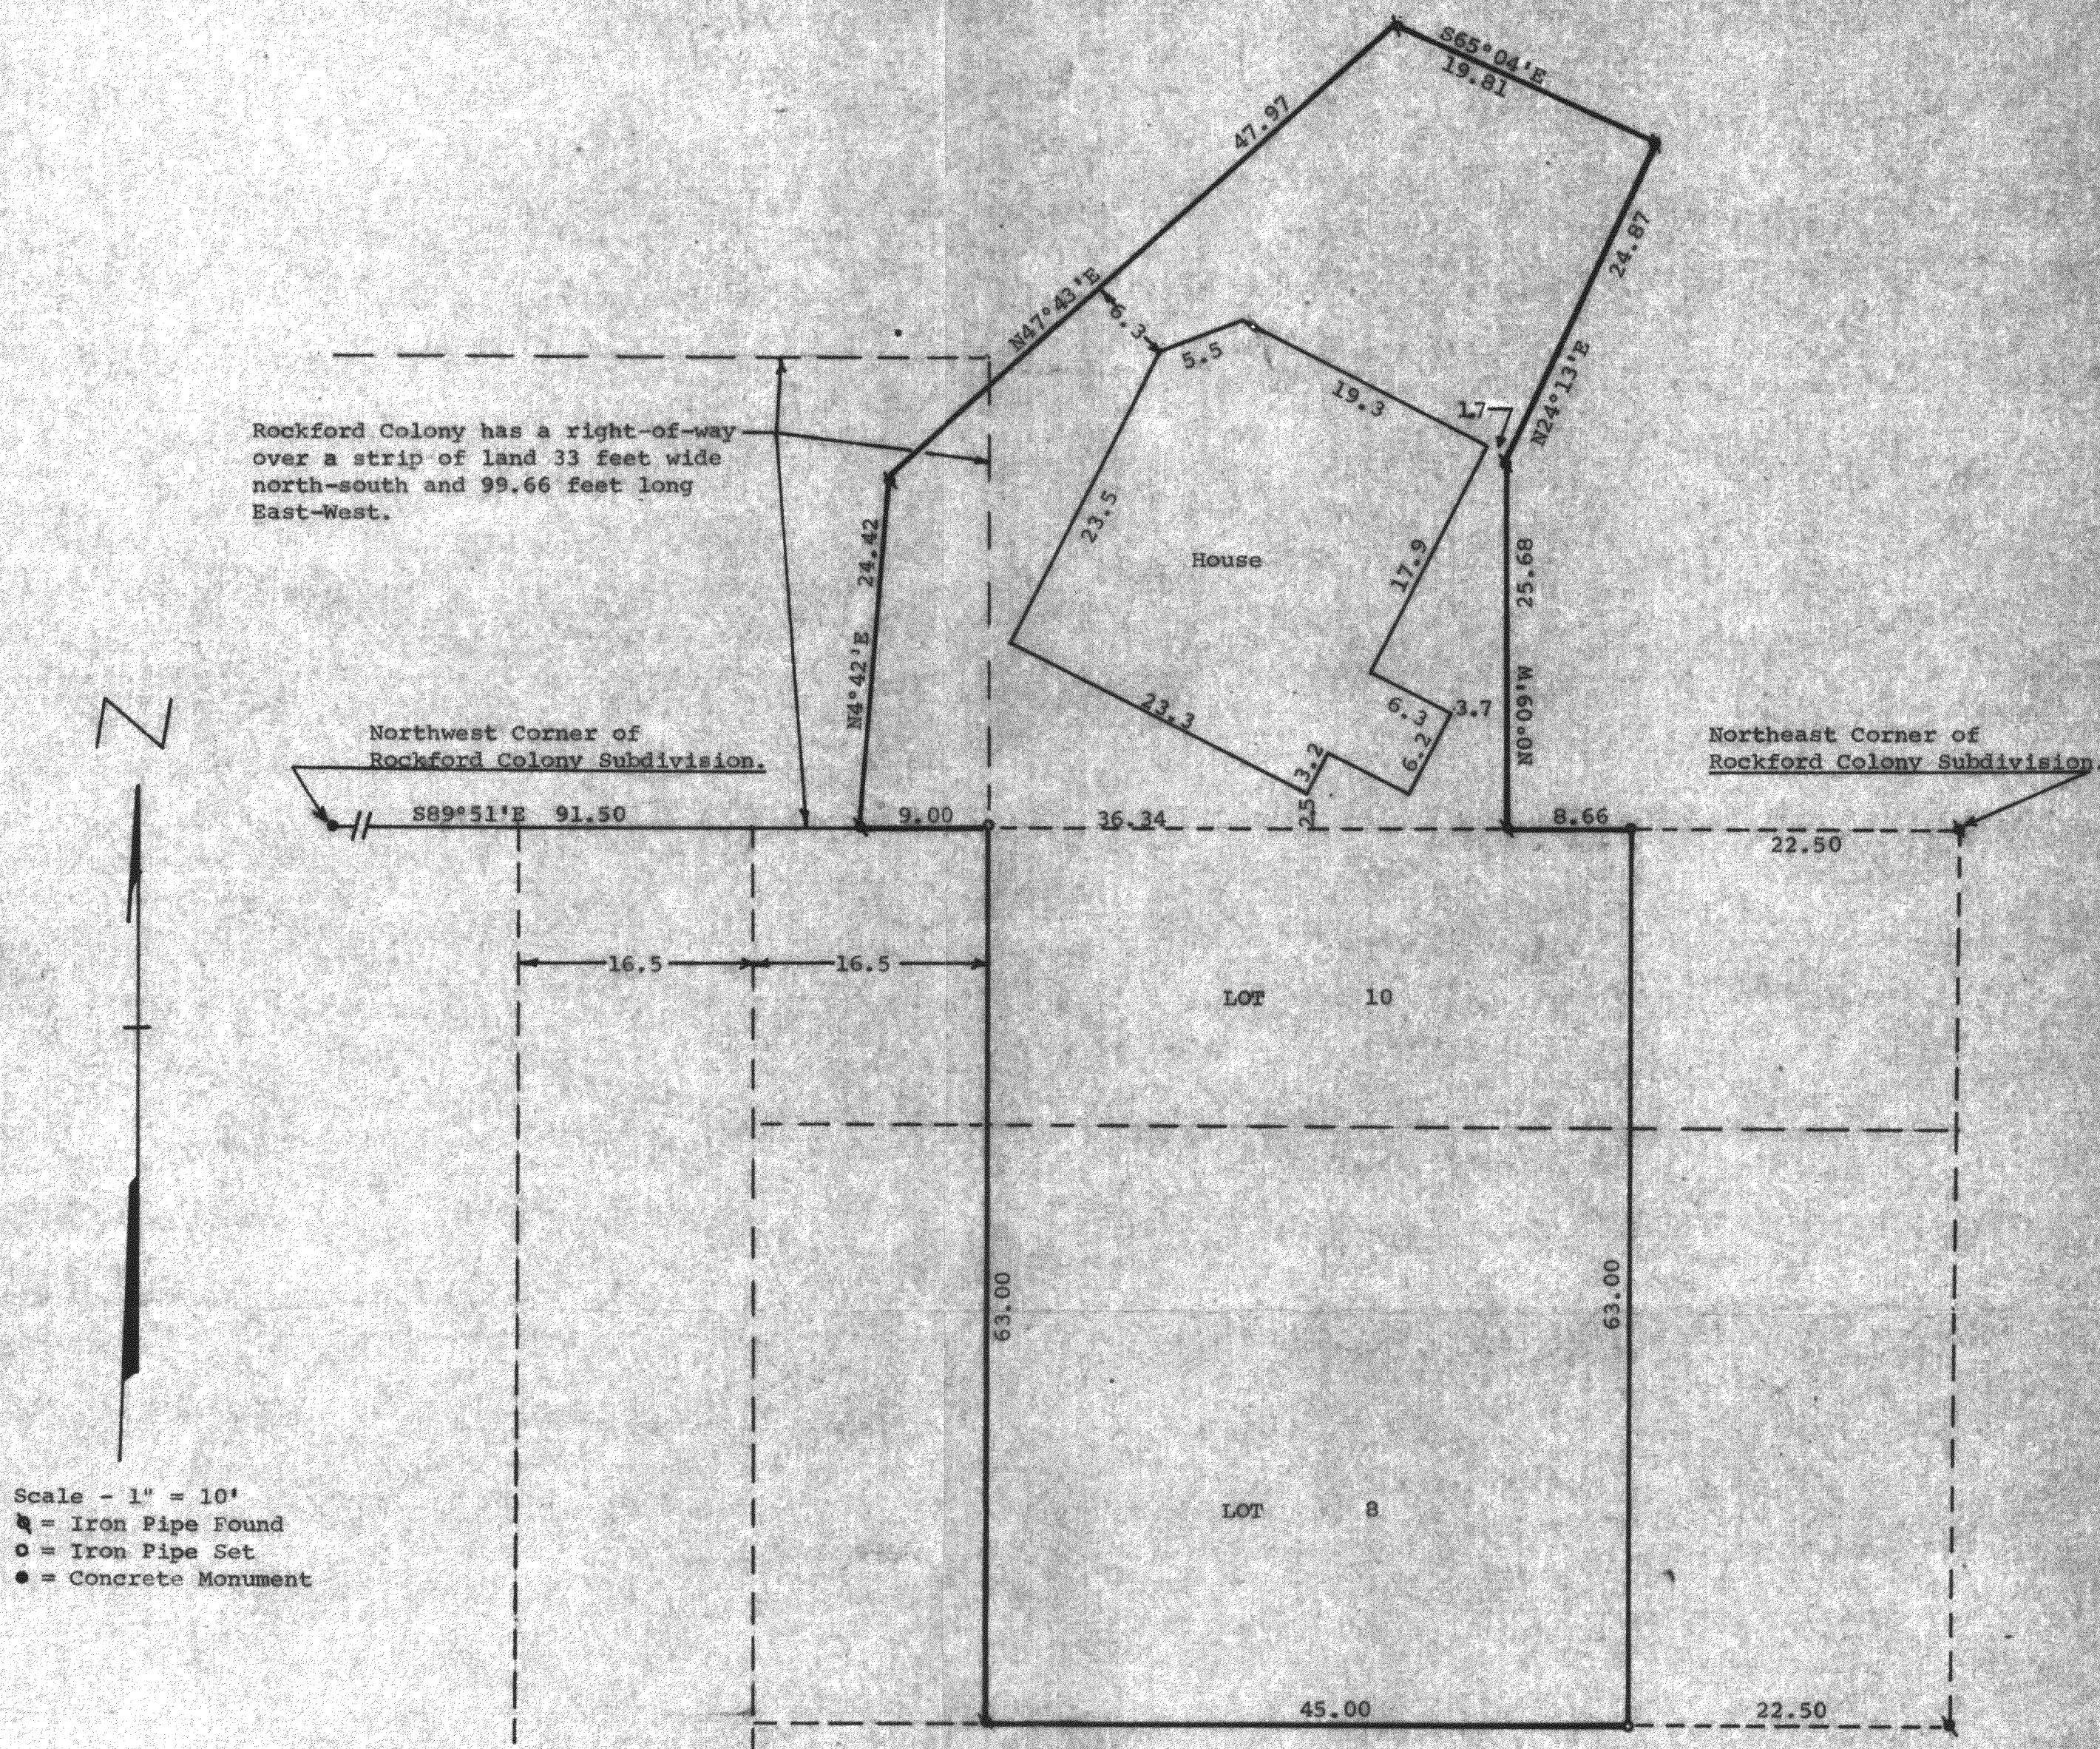

STATE OF WISCONSIN) SS  
COUNTY OF WALWORTH)

I, George T. Dunham, Surveyor, certify that I have surveyed the property described as follows:

A parcel of land located in the Northwest Fractional  $\frac{1}{4}$  of Fractional Section 28, T2N, R16E, Walworth County, Wisconsin, described as follows: Commencing at the northeast corner of Rockford Colony; thence N89°51'W 31.16 feet along the north line of said Rockford Colony to the place of beginning; thence N0°09'W 25.68 feet; thence N24°13'E 24.87 feet; thence N65°04'W 19.81 feet; thence S47°43'W 47.97 feet; thence S4°42'W 24.42 feet to the north line of Rockford Colony; thence S89°51'E 45.34 feet along the north line of said Rockford Colony to the place of beginning, subject to the following right-of-way given to Rockford Colony as shown on Page 171 of Volume 62 of Deeds in Walworth County Records which is described as follows: Commencing 25 links north of the northwest corner of an acre of land in Section No. 28-2-16, deeded by said Nelson to Rockford Colony; thence East 1.51 chains parallel with the north line of said acre, said line is the center of said right-of-way, said right-of-way is 50 links wide, together with other right-of-ways of record.

ALSO part of Lots 8 and 10 in Rockford Colony Subdivision according to the recorded Plat thereof, described as follows: Commencing at a point on the South line of said Lot 8, 22 $\frac{1}{2}$  feet west from the southeast corner of said Lot 8; thence running West on the South line of said Lot 8, 45 feet; thence North at right angles to said south line to the North line of said Lot 10; thence East on the north line of said Lot 10, 45 feet; thence South to the place of beginning.

and that the above map is a true representation thereof and shows the size and location of the property, its exterior boundaries, the location of all visible structures and dimensions of all principal buildings thereon, apparent easements, roadways and visible encroachments, if any.

This survey is made for the use of the present owners of the property, and also those who purchase, mortgage, or guarantee the title thereto within one (1) year from date hereof.

July 22, 1980

*George T. Dunham*  
George T. Dunham, Surveyor

