KOLB LAND CONSULTING, INC.

LAND SURVEYING · SUBDIVIDING · LAND PLANNING

LAKE GENEVA, WISCONSIN 53147

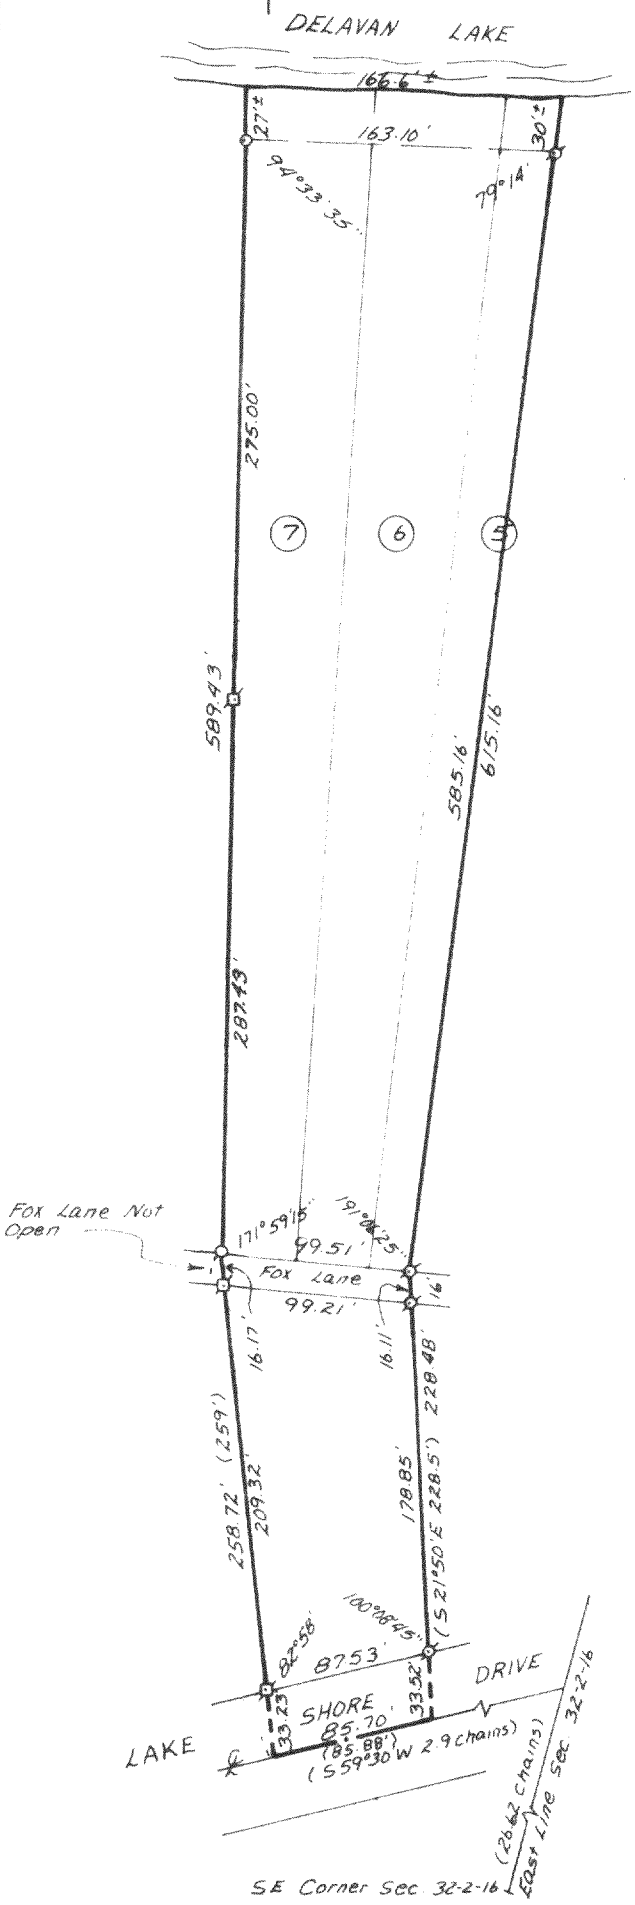

PLAT OF SURVEY OF

LOT 6 AND 7 AND PART OF LOT 5, AUSTIN & WALLIS SUBDIVISION, SECTION 32, T2N, R16E AND A PARCEL OF LAND LOCATED IN THE SOUTHEAST ¼ OF SECTION 32, T2N, R16E, WALWORTH COUNTY, WISCONSIN.

CONTAINING 2.27 ACRES EXCLUDING ROAD RIGHT-OF-WAY.

ORDERED BY: KEEFE REAL ESTATE
DELAVAN, WI 53115

LEGEND

- ⌀ - IRON PIPE FOUND
- o - IRON PIPE SET
- ⌑ - CONCRETE MONUMENT FOUND
- () - RECORDED AS

SCALE - 1"=100'

I, HAROLD H. KOLB, DO HEREBY CERTIFY THAT I HAVE SURVEYED THE PROPERTY HEREON DESCRIBED ACCORDING TO THE OFFICIAL RECORDS, AND THAT THE PLAT HEREON IS A CORRECT REPRESENTATION OF THE LOT LINES TO THE BEST OF MY KNOWLEDGE AND BELIEF.

Harold H. Kolb
HAROLD H. KOLB
WISCONSIN REGISTERED LAND SURVEYOR, S-187
DATE AUGUST 29, 1984

FAWL 4
FD32-109

216-791-K

2-16 FD-32-109 + FAWL-4