DUNHAM SURVEYING, S. C.
SURVEYING & SUBDIVIDING
DELAVAN, WISCONSIN 53115

RECEIVED
SEP 4 1985

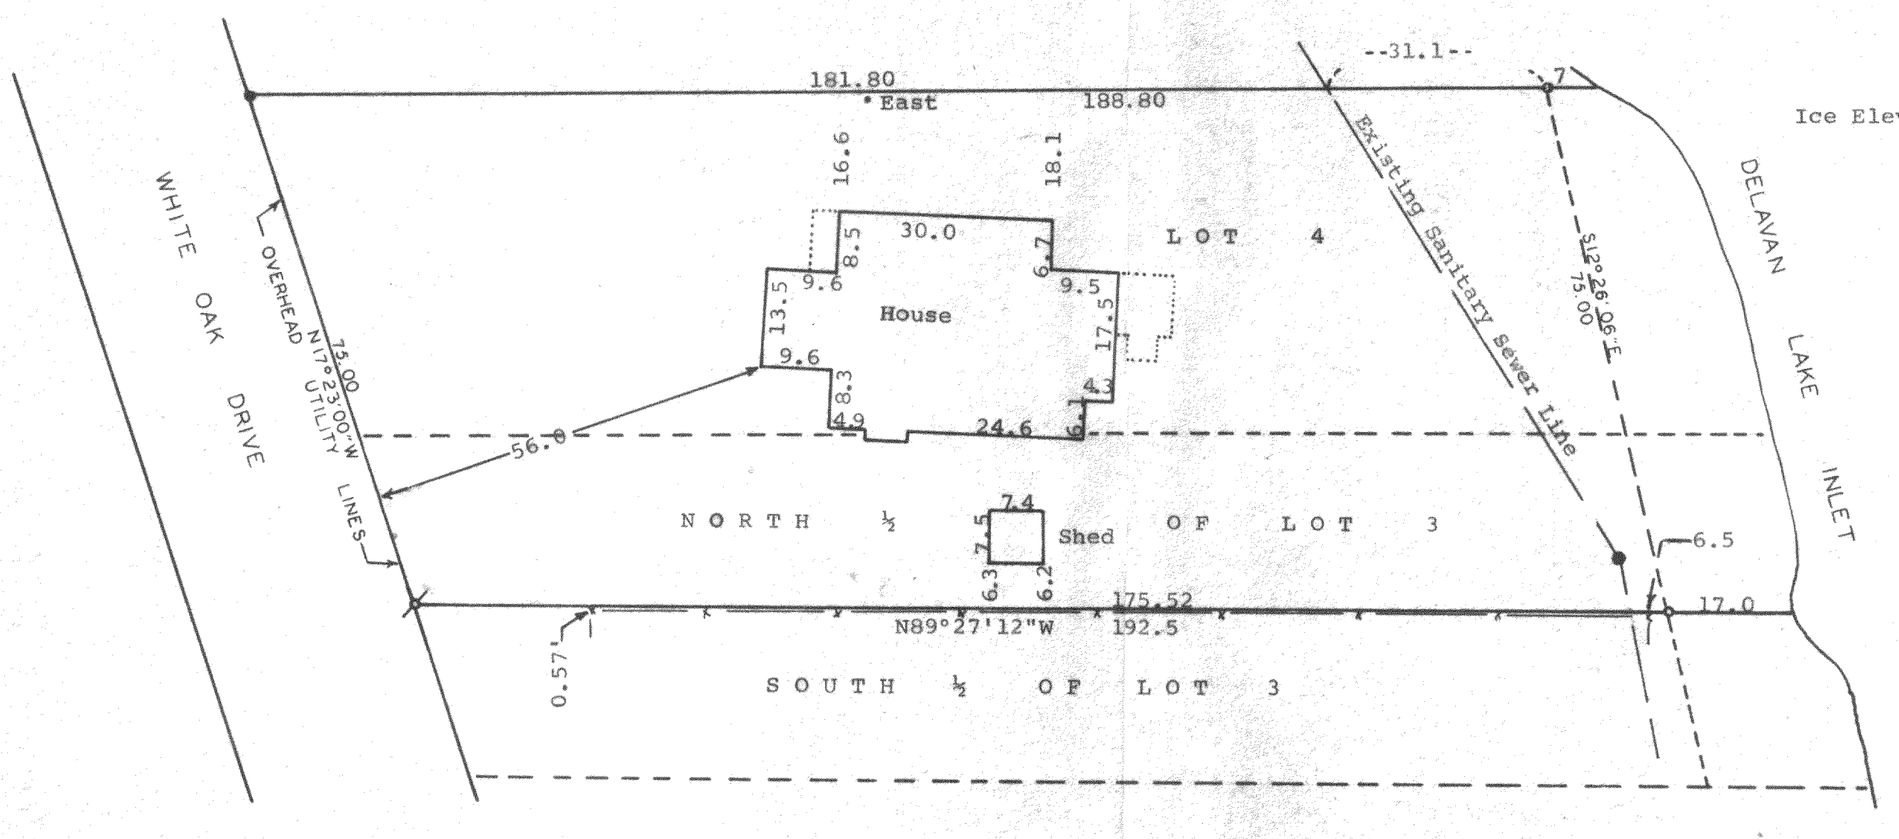

Scale - 1" = 20'
● = 1¼" Dia. Iron Pipe Found
= 1" Dia. Iron Pipe Found
○ = Iron Pipe Set - 3/4"x24"
● = Manhole
—x——x— = Fence line

NOTE: Entire property is above the flood plain elevation of 929.00.

Bearings referenced to the north line of Lot 4. Assumed bearing of East used.

Survey ordered by: The Rauland Agency
Delavan, WI 53115

STATE OF WISCONSIN)
COUNTY OF WALWORTH) SS

I, George T. Dunham, Surveyor, certify that I have surveyed the property described as follows,

Lot 4 and the North ½ of Lot 3 of the Annex to Inlet Oaks, located in Sections 15 and 22, T 2 N, R 16 E, Walworth County, Wisconsin,

and that the map shown above is a correct representation thereof and shows the size and location of the property, its exterior boundaries, the location of all visible structures and dimensions of all principal buildings thereon, boundary fences, apparent easements, roadways and visible encroachments, if any, and that I have surveyed the property hereon described according to the official records, to the best of my knowledge and belief.

February 1, 1985
Revised March 30, 1985

George T. Dunham, Surveyor

WISCONSIN LAND SURVEYOR
GEORGE T. DUNHAM
S-306
DELAVAN WIS.

FIA-00003

216-814

K & E 10-9155