WALWORTH COUNTY
SURVEYING & MAPPING
LAKE GENEVA, WISCONSIN

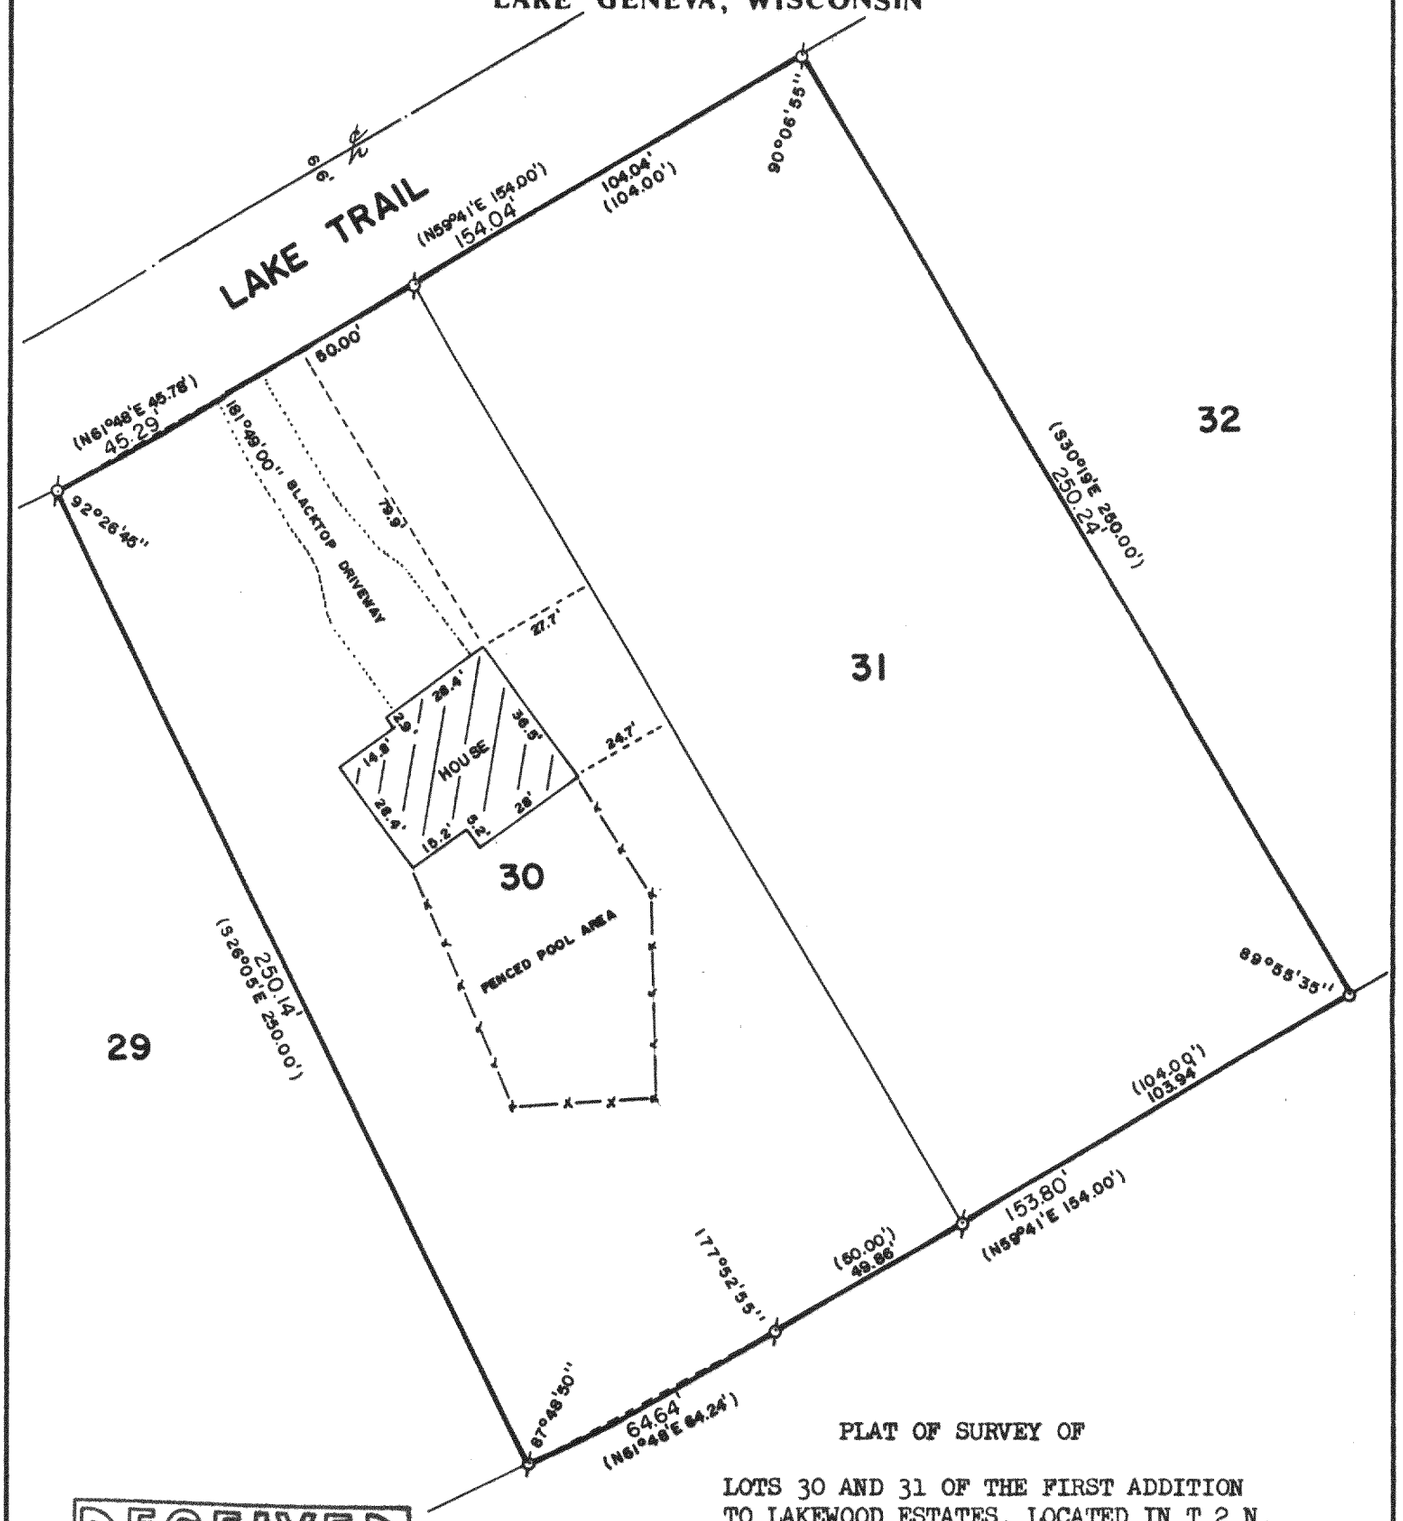

RECEIVED
JUN 17 [redacted]

PLAT OF SURVEY OF

LOTS 30 AND 31 OF THE FIRST ADDITION TO LAKEWOOD ESTATES, LOCATED IN T 2 N, R 16 E, WALWORTH COUNTY, WISCONSIN.

ORDERED BY: COLDWELL BANKER
GENEVA LAKES AREA REALTORS
838 MAIN STREET
LAKE GENEVA, WISCONSIN
53147

SCALE: 1"=40'

⌀ -IRON PIPE FOUND
o -IRON ROD PLACED
()-RECORDED AS

I, ROBERT M. BAERENWALD, DO HEREBY CERTIFY THAT I HAVE SURVEYED THE PROPERTY HEREON DESCRIBED ACCORDING TO THE OFFICIAL RECORDS AND THAT THE PLAT HEREON IS A CORRECT REPRESENTATION OF THE PROPERTY LINES TO THE BEST OF MY KNOWLEDGE AND BELIEF.

Robert M Baerenwald
ROBERT M. BAERENWALD
WISCONSIN REGISTERED LAND SURVEYOR, S-1508

April 2, 1988
DATE JOB NO. 1454

NOTE: THIS IS NOT A CERTIFIED COPY UNLESS SEALED.

FLEA-10, FLEA-11

216-1021