



ORDERED BY THE ESTATE OF SUSAN RITA
C/O JOSEPH JOHNSON
1205 SHERMAN ROAD
NORTHBROOK, IL 60062

FARRIS, HANSEN & ASSOCIATES, INC.
ENGINEERING - ARCHITECTURE - SURVEYING
7 RIDGWAY COURT P.O. BOX 437
ELKHORN, WISCONSIN 53121
OFFICE: (262) 723-2098 FAX: (262) 723-5886


REVISIONS

NO.	DATE	DESCRIPTION
1	11-03-2009	AS SHOWN

PROJECT NO.
8033

DATE:
11-03-2009

SHEET NO.
1 OF 1

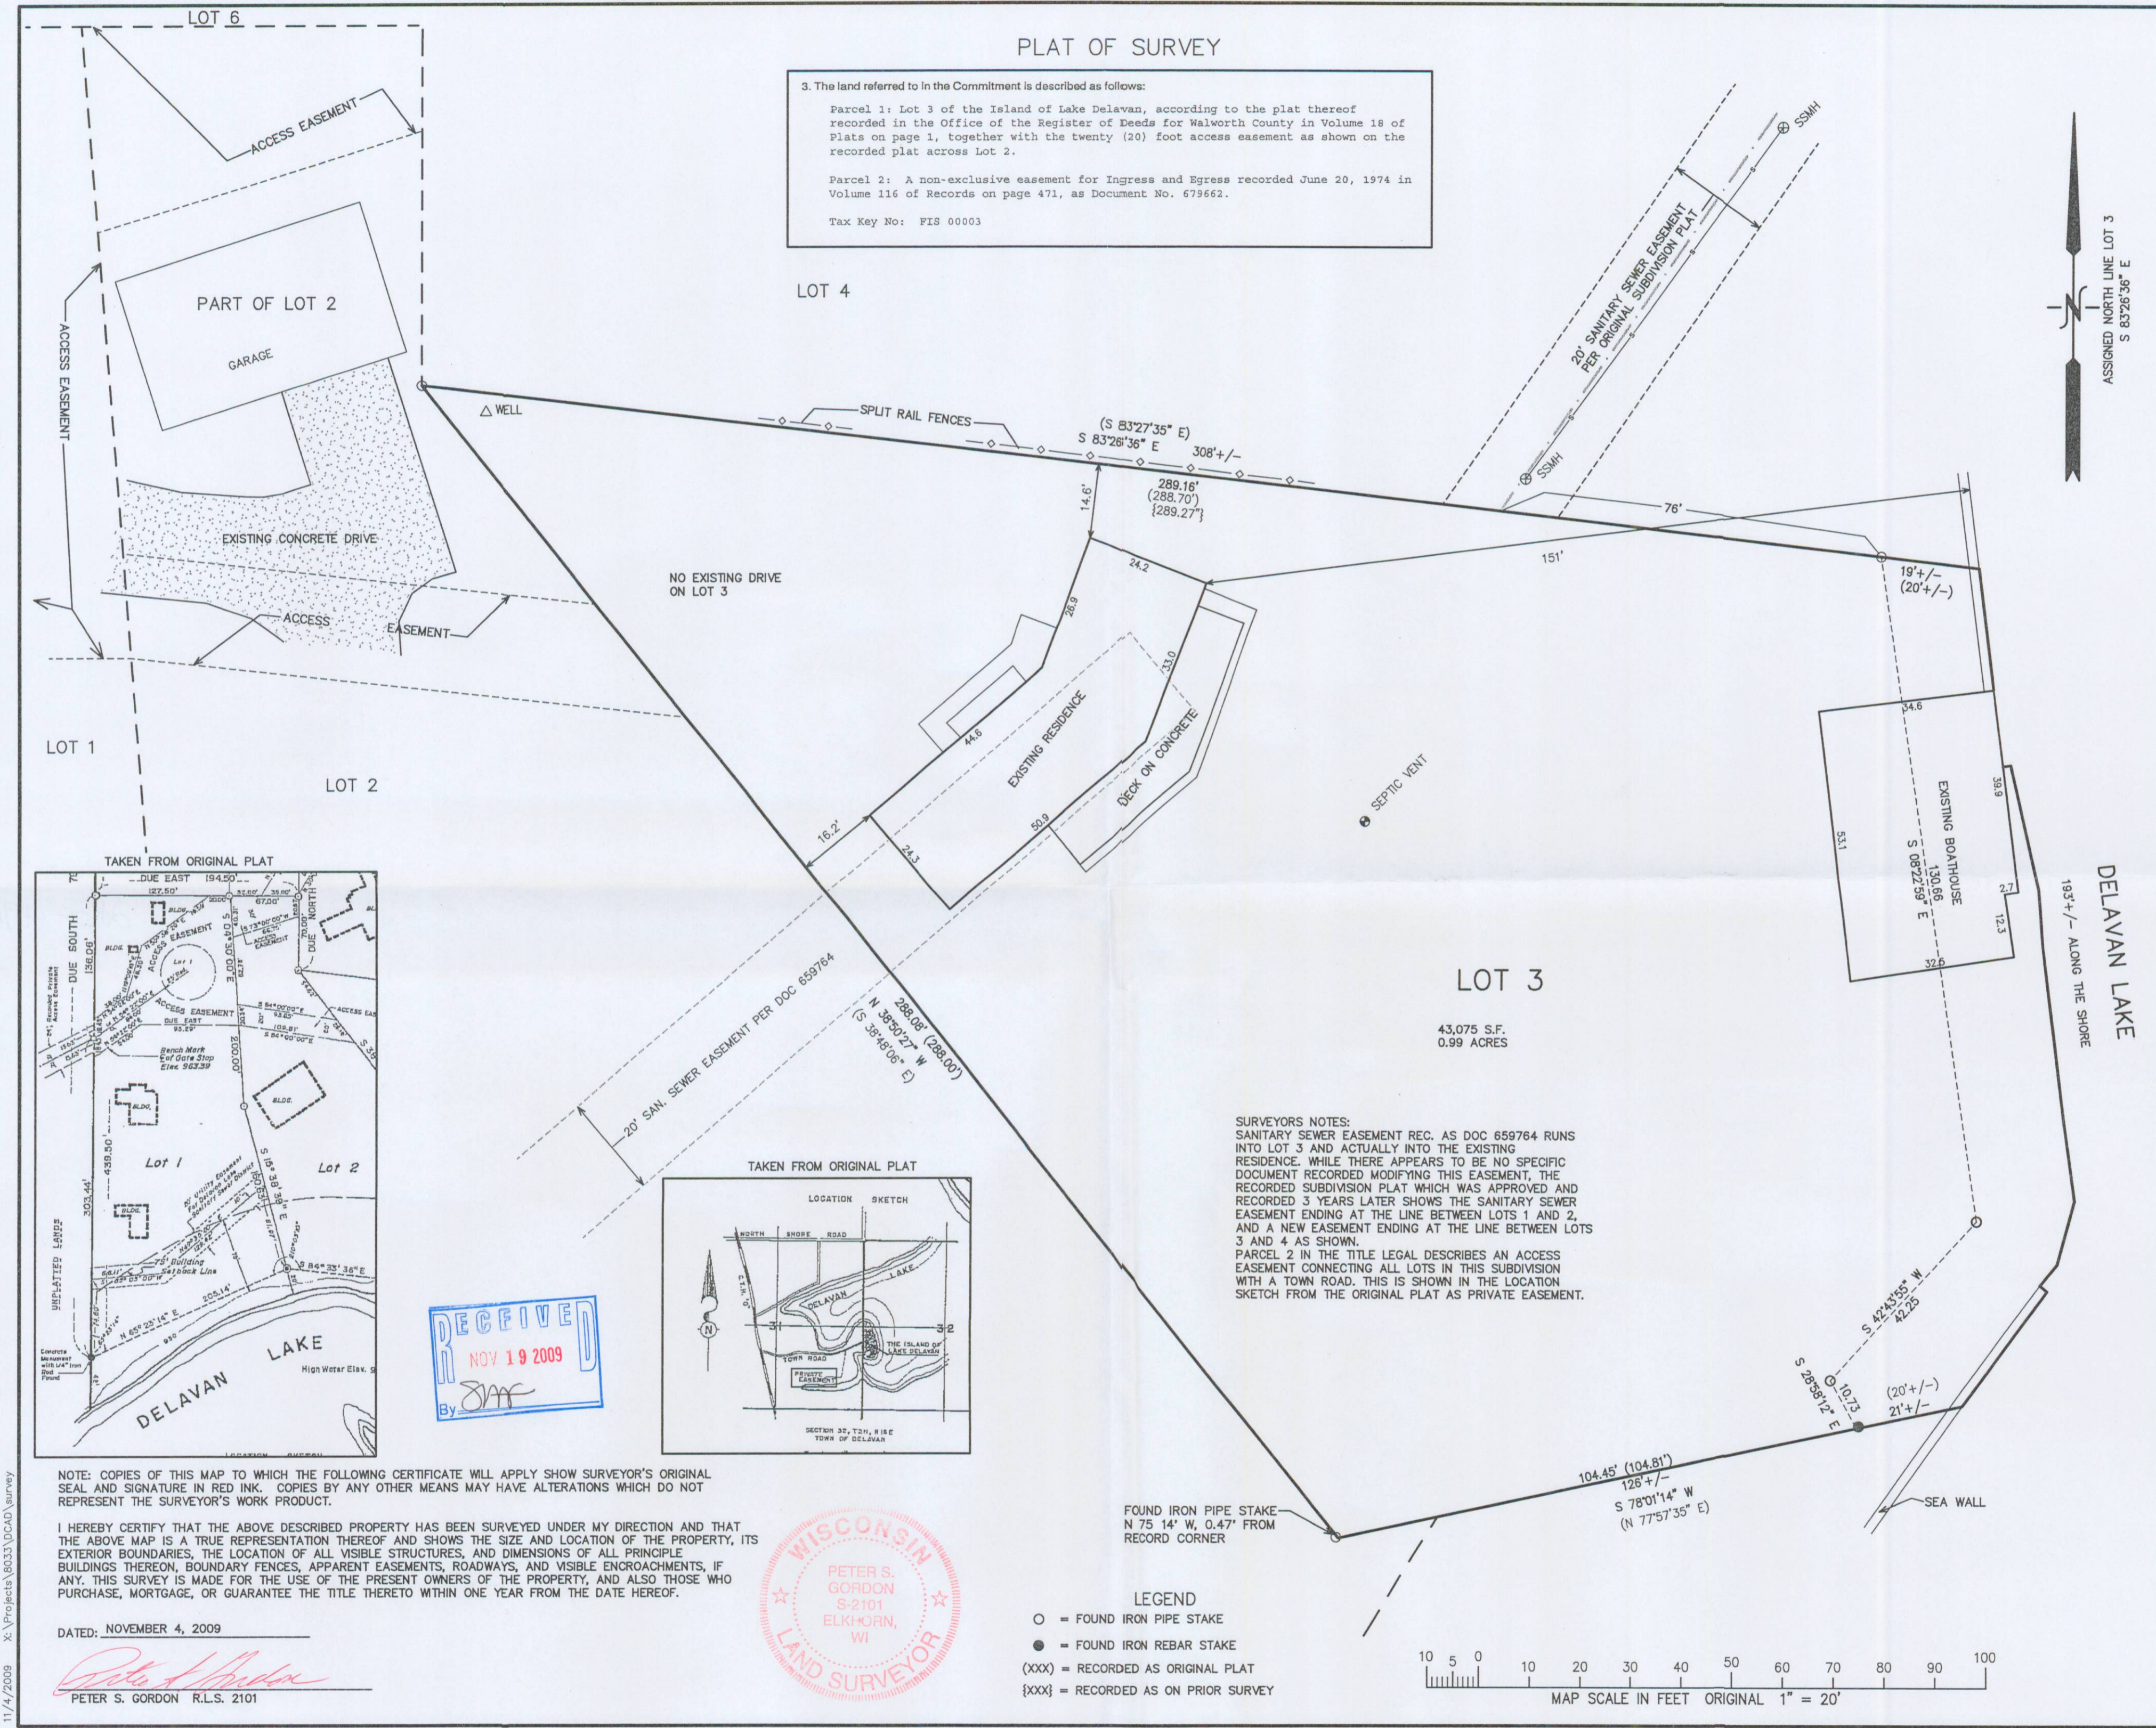

11/4/2009 X:\Projects\8033\DCAD\survey

NOV 02 2009

FIS-3

216-4706