PLAT OF SURVEY
-OF-

LOT 5 OF THE SUBDIVISION OF LOT 1 OF METTOWEE, A SUBDIVISION SITUATED IN THE TOWNSHIP OF DELAVAN, WALWORTH COUNTY, WISCONSIN. ALSO ALL THAT PART OF LOT 6 OF SAID SUBDIVISION OF LOT 1 OF METTOWEE WHICH IS DESCRIBED AS FOLLOWS: BEGINNING AT THE MOST SOUTHERLY CORNER OF THE ABOVE DESCRIBED LOT 5; THENCE SOUTHEASTERLY AND PRODUCING THE SOUTHWEST LINE OF SAID LOT 5 TO A STAKE ON THE EAST LINE OF SAID LOT 6 ABOUT 539.5 FEET SOUTH OF THE SOUTHEAST CORNER OF SAID LOT 2 OF SAID SUBDIVISION OF LOT 1 OF METTOWEE, THENCE NORTH ON THE EAST LINE OF LOT 6, 179.8 FEET MORE OR LESS TO A POINT WHERE THE NORTHEAST LINE OF SAID LOT 5 PRODUCED SOUTHEASTERLY WOULD INTERSECT THE EAST LINE OF SAID LOT 6; THENCE NORTHWESTERLY TO THE MOST EASTERLY CORNER OF SAID LOT 5; THENCE SOUTHWESTERLY ALONG THE SOUTHEAST LINE OF SAID LOT 5, 100 FEET TO THE PLACE OF BEGINNING.

SURVEY FOR: GNP REALTY PARTNERS

SURVEY LOCATION: 2921 SOUTH SHORE DRIVE

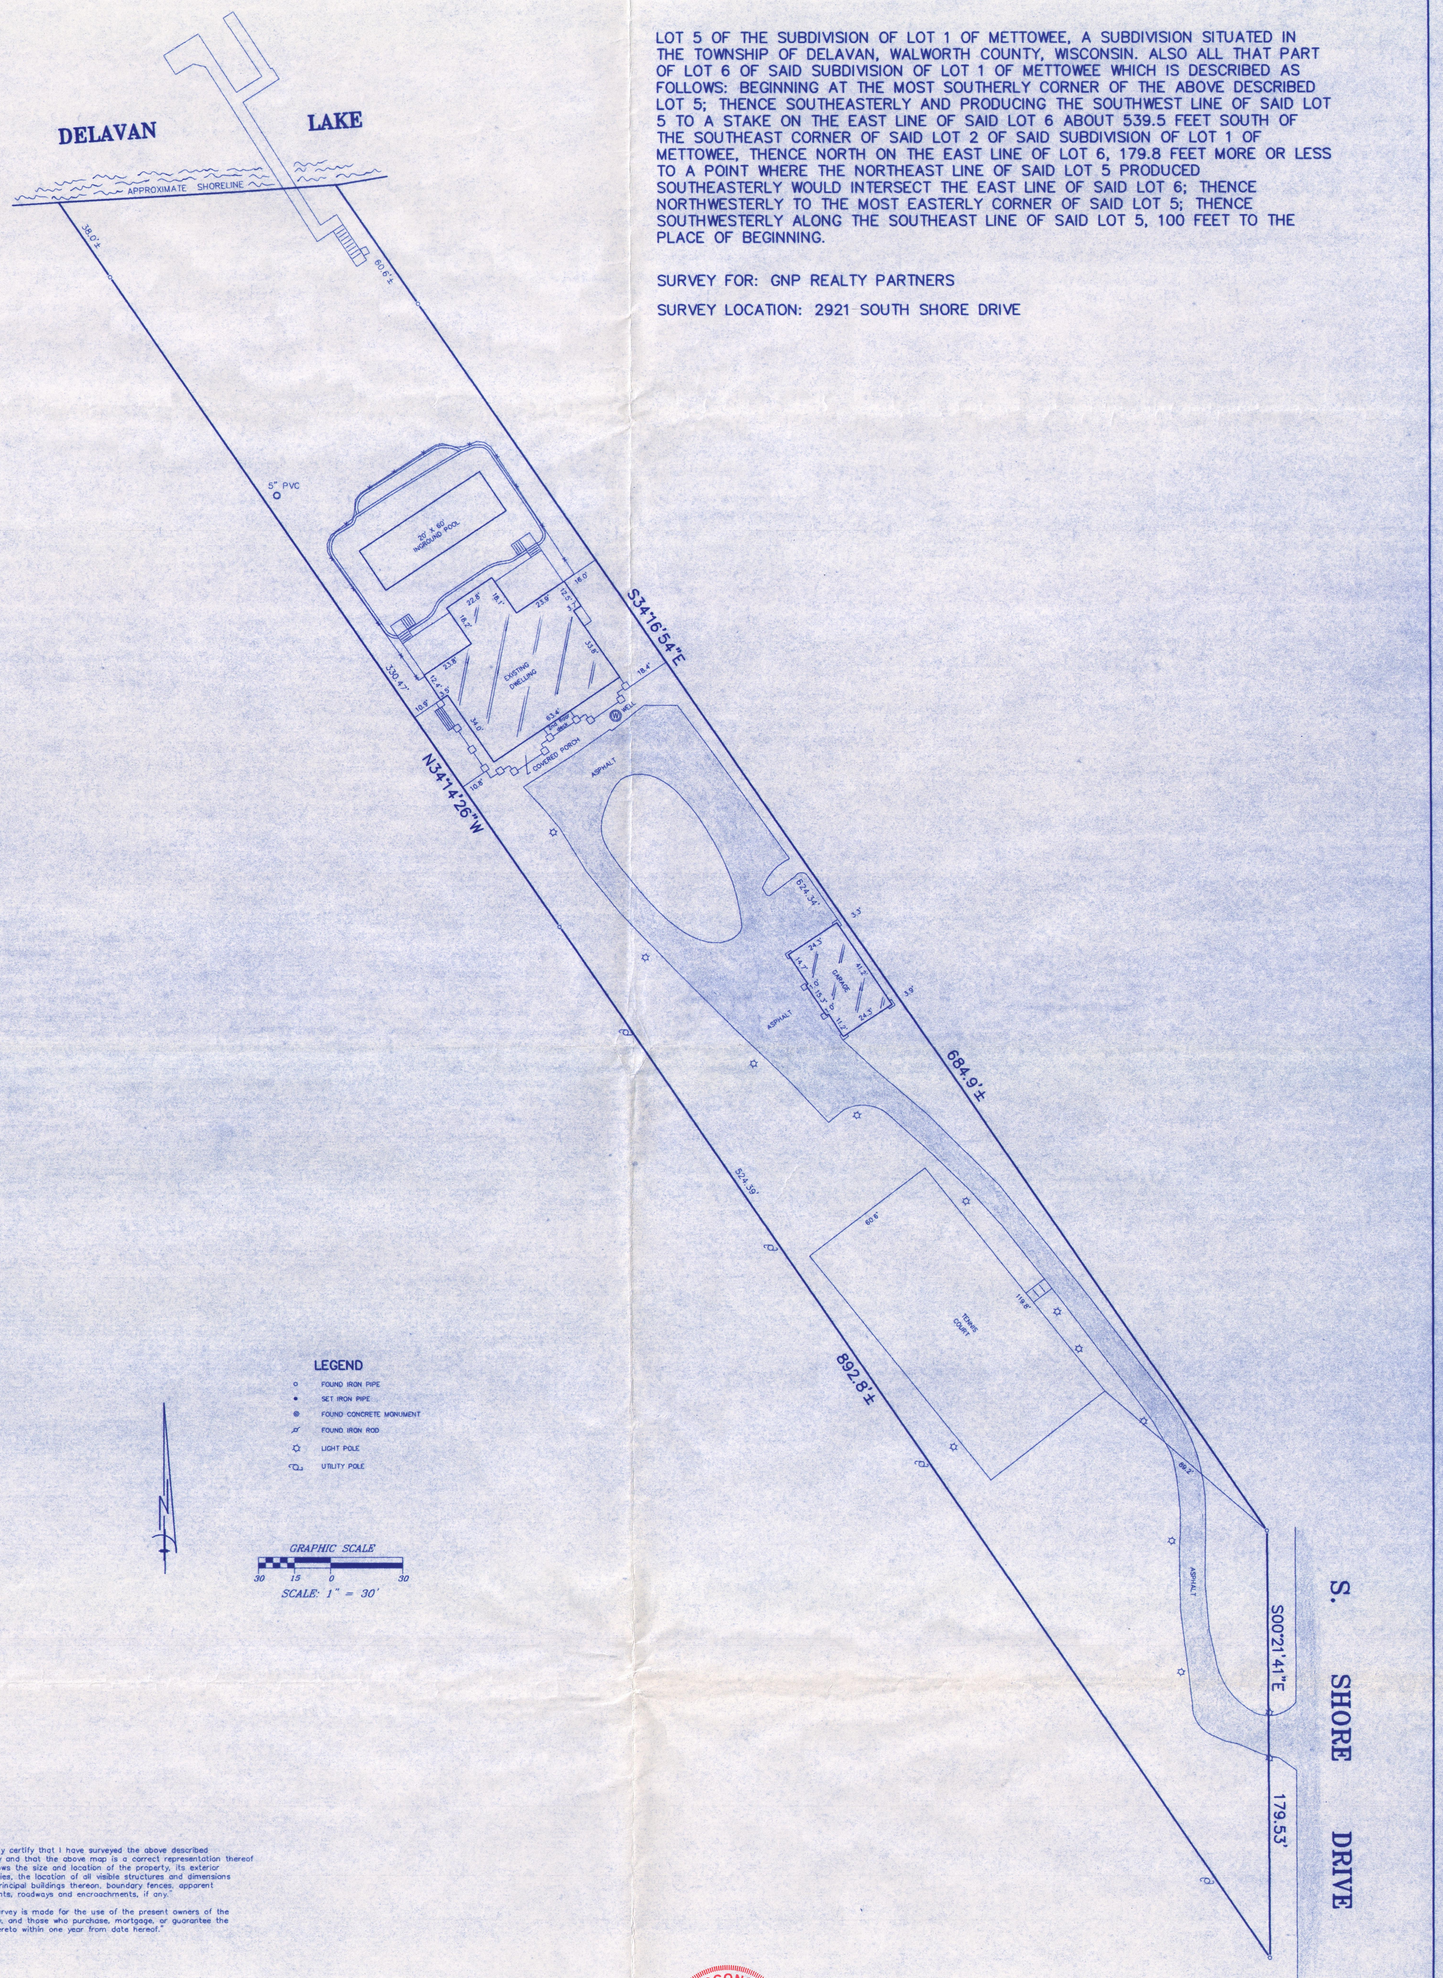

"I hereby certify that I have surveyed the above described property and that the above map is a correct representation thereof and shows the size and location of the property, its exterior boundaries, the location of all visible structures and dimensions of all principal buildings thereon, boundary fences, apparent easements, roadways and encroachments, if any."

"This survey is made for the use of the present owners of the property, and those who purchase, mortgage, or guarantee the title thereto within one year from date hereof."

WISCONSIN
ROBERT J. WETZEL
S-1778
BURLINGTON, WI
LAND SURVEYOR

THIS IS NOT AN ORIGINAL PRINT UNLESS THIS SEAL IS RED.

Robert J. Wetzel
ROBERT J. WETZEL S-1778

RECEIVED
JUN 6 2013
By

B.W. SURVEYING, INC.
412 N. PINE STREET
BURLINGTON, WI 53105
(262)-767-0225

DRAWN BY:	bw/rw	DATE:	MAY 30, 2012
CHECKED BY:	bw/rw	DRAWING NO.:	8466D1
JOB NO.:	8466	SHEET	1 OF 1

FMT 1-6

216-5022