




PORTION OF LOT 13 IN BARNS AND VON SUESSMILCH'S SUBDIVISION

LOCATED IN PART OF THE NW 1/4 OF THE SW 1/4 AND THE SW 1/4 OF THE NW 1/4 OF SECTION 33, TOWN 2 NORTH, RANGE 16 EAST, TOWN OF DELAVAN, WALWORTH COUNTY, WISCONSIN

A strip of land 75 feet in width off the Southwesterly side of Lot 13 in Barnes and Von Suessmilch's Subdivision in the Town of Delavan, Walworth County, Wisconsin.
LEGAL DESCRIPTION PER CHICAGO TITLE INSURANCE COMPANY COMMITMENT NO. WA-20851 DATED 2/23/2022.

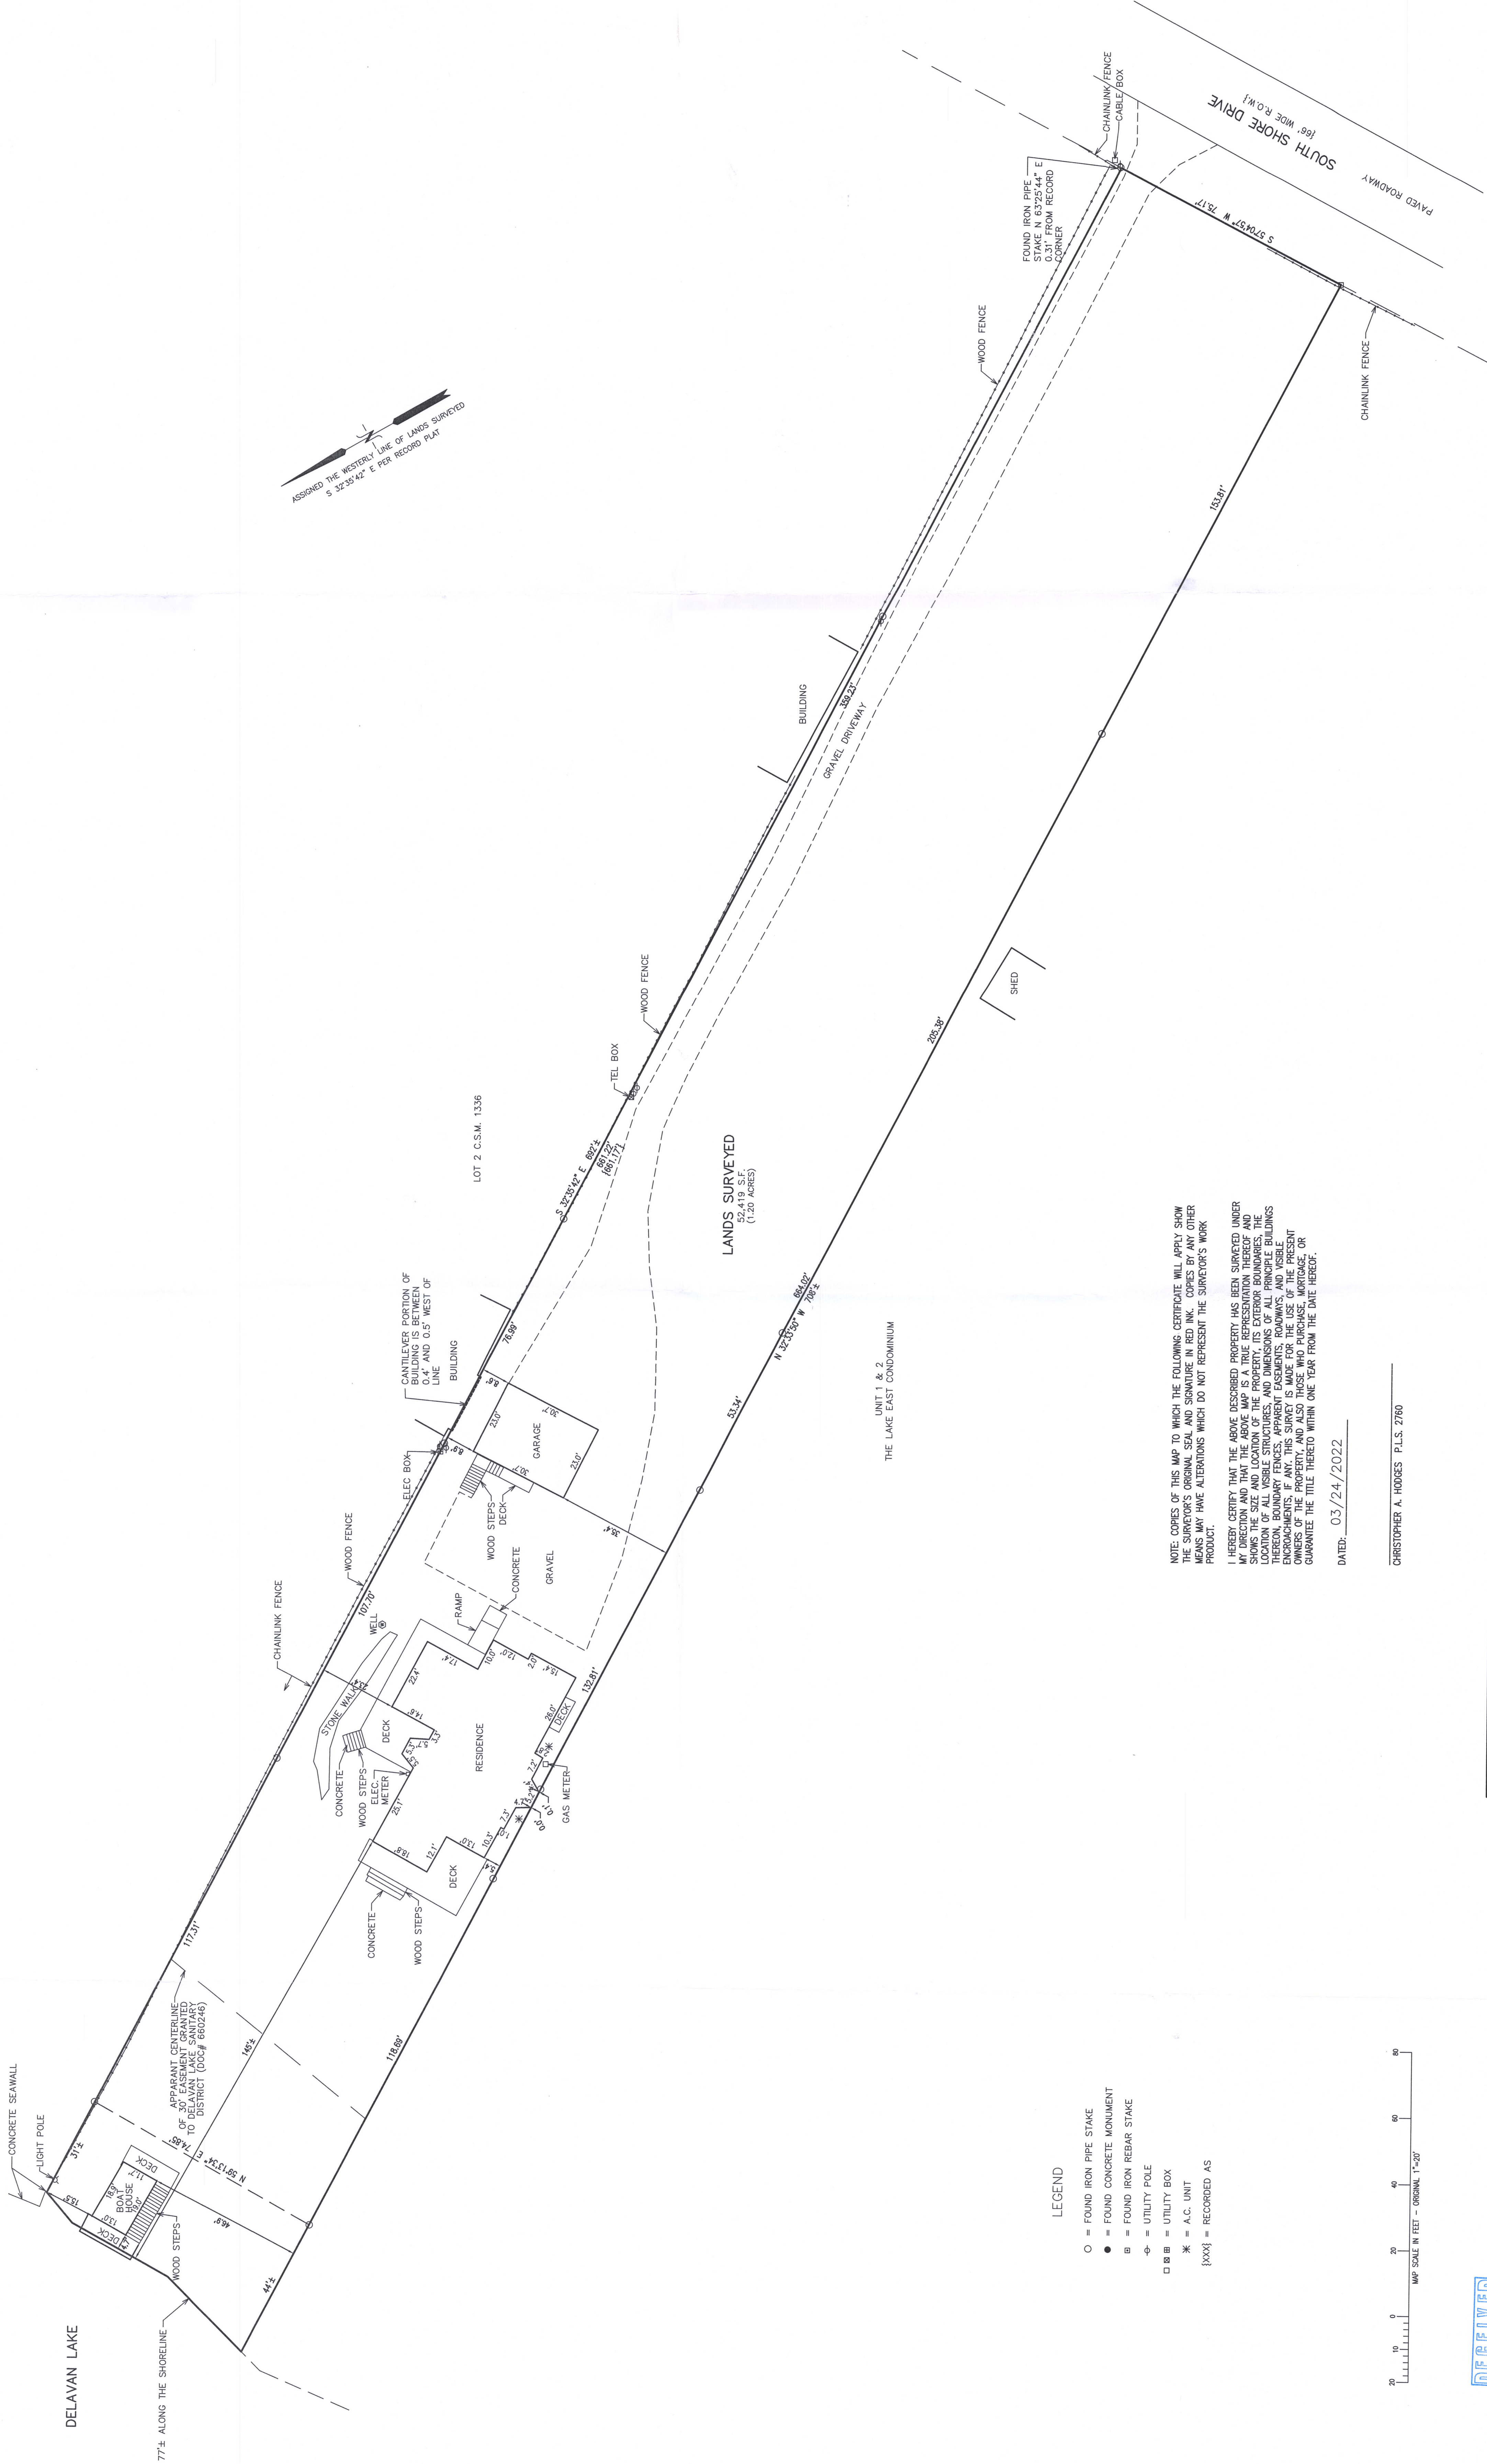

- LEGEND
- O = FOUND IRON PIPE STAKE
 - = FOUND CONCRETE MONUMENT
 - ⊗ = FOUND IRON REBAR STAKE
 - ⊕ = UTILITY POLE
 - ⊙ = UTILITY BOX
 - * = A.C. UNIT
 - {xxx} = RECORDED AS

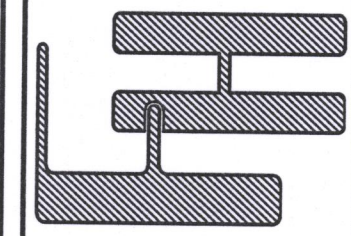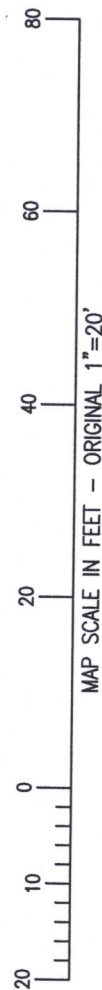

TITLE SURVEY
3489 SOUTH SHORE DRIVE
DELAVAN, WISCONSIN

— WORK ORDERED BY —
MIKE BRADY
1503 EAST EMMERSON LANE
MOUNT PROSPECT, ILLINOIS 60056

FARRIS, HANSEN & ASSOCIATES, INC.
ENGINEERING — ARCHITECTURE — SURVEYING
7 RIDGWAY COURT P.O. BOX 437
ELKHORN, WISCONSIN 53121
OFFICE: (262) 723-2098 FAX: (262) 723-5886

PROJECT NO.
10646
DATE
03/09/2022
SHEET NO.
1 OF 1

216-5920

APA-7