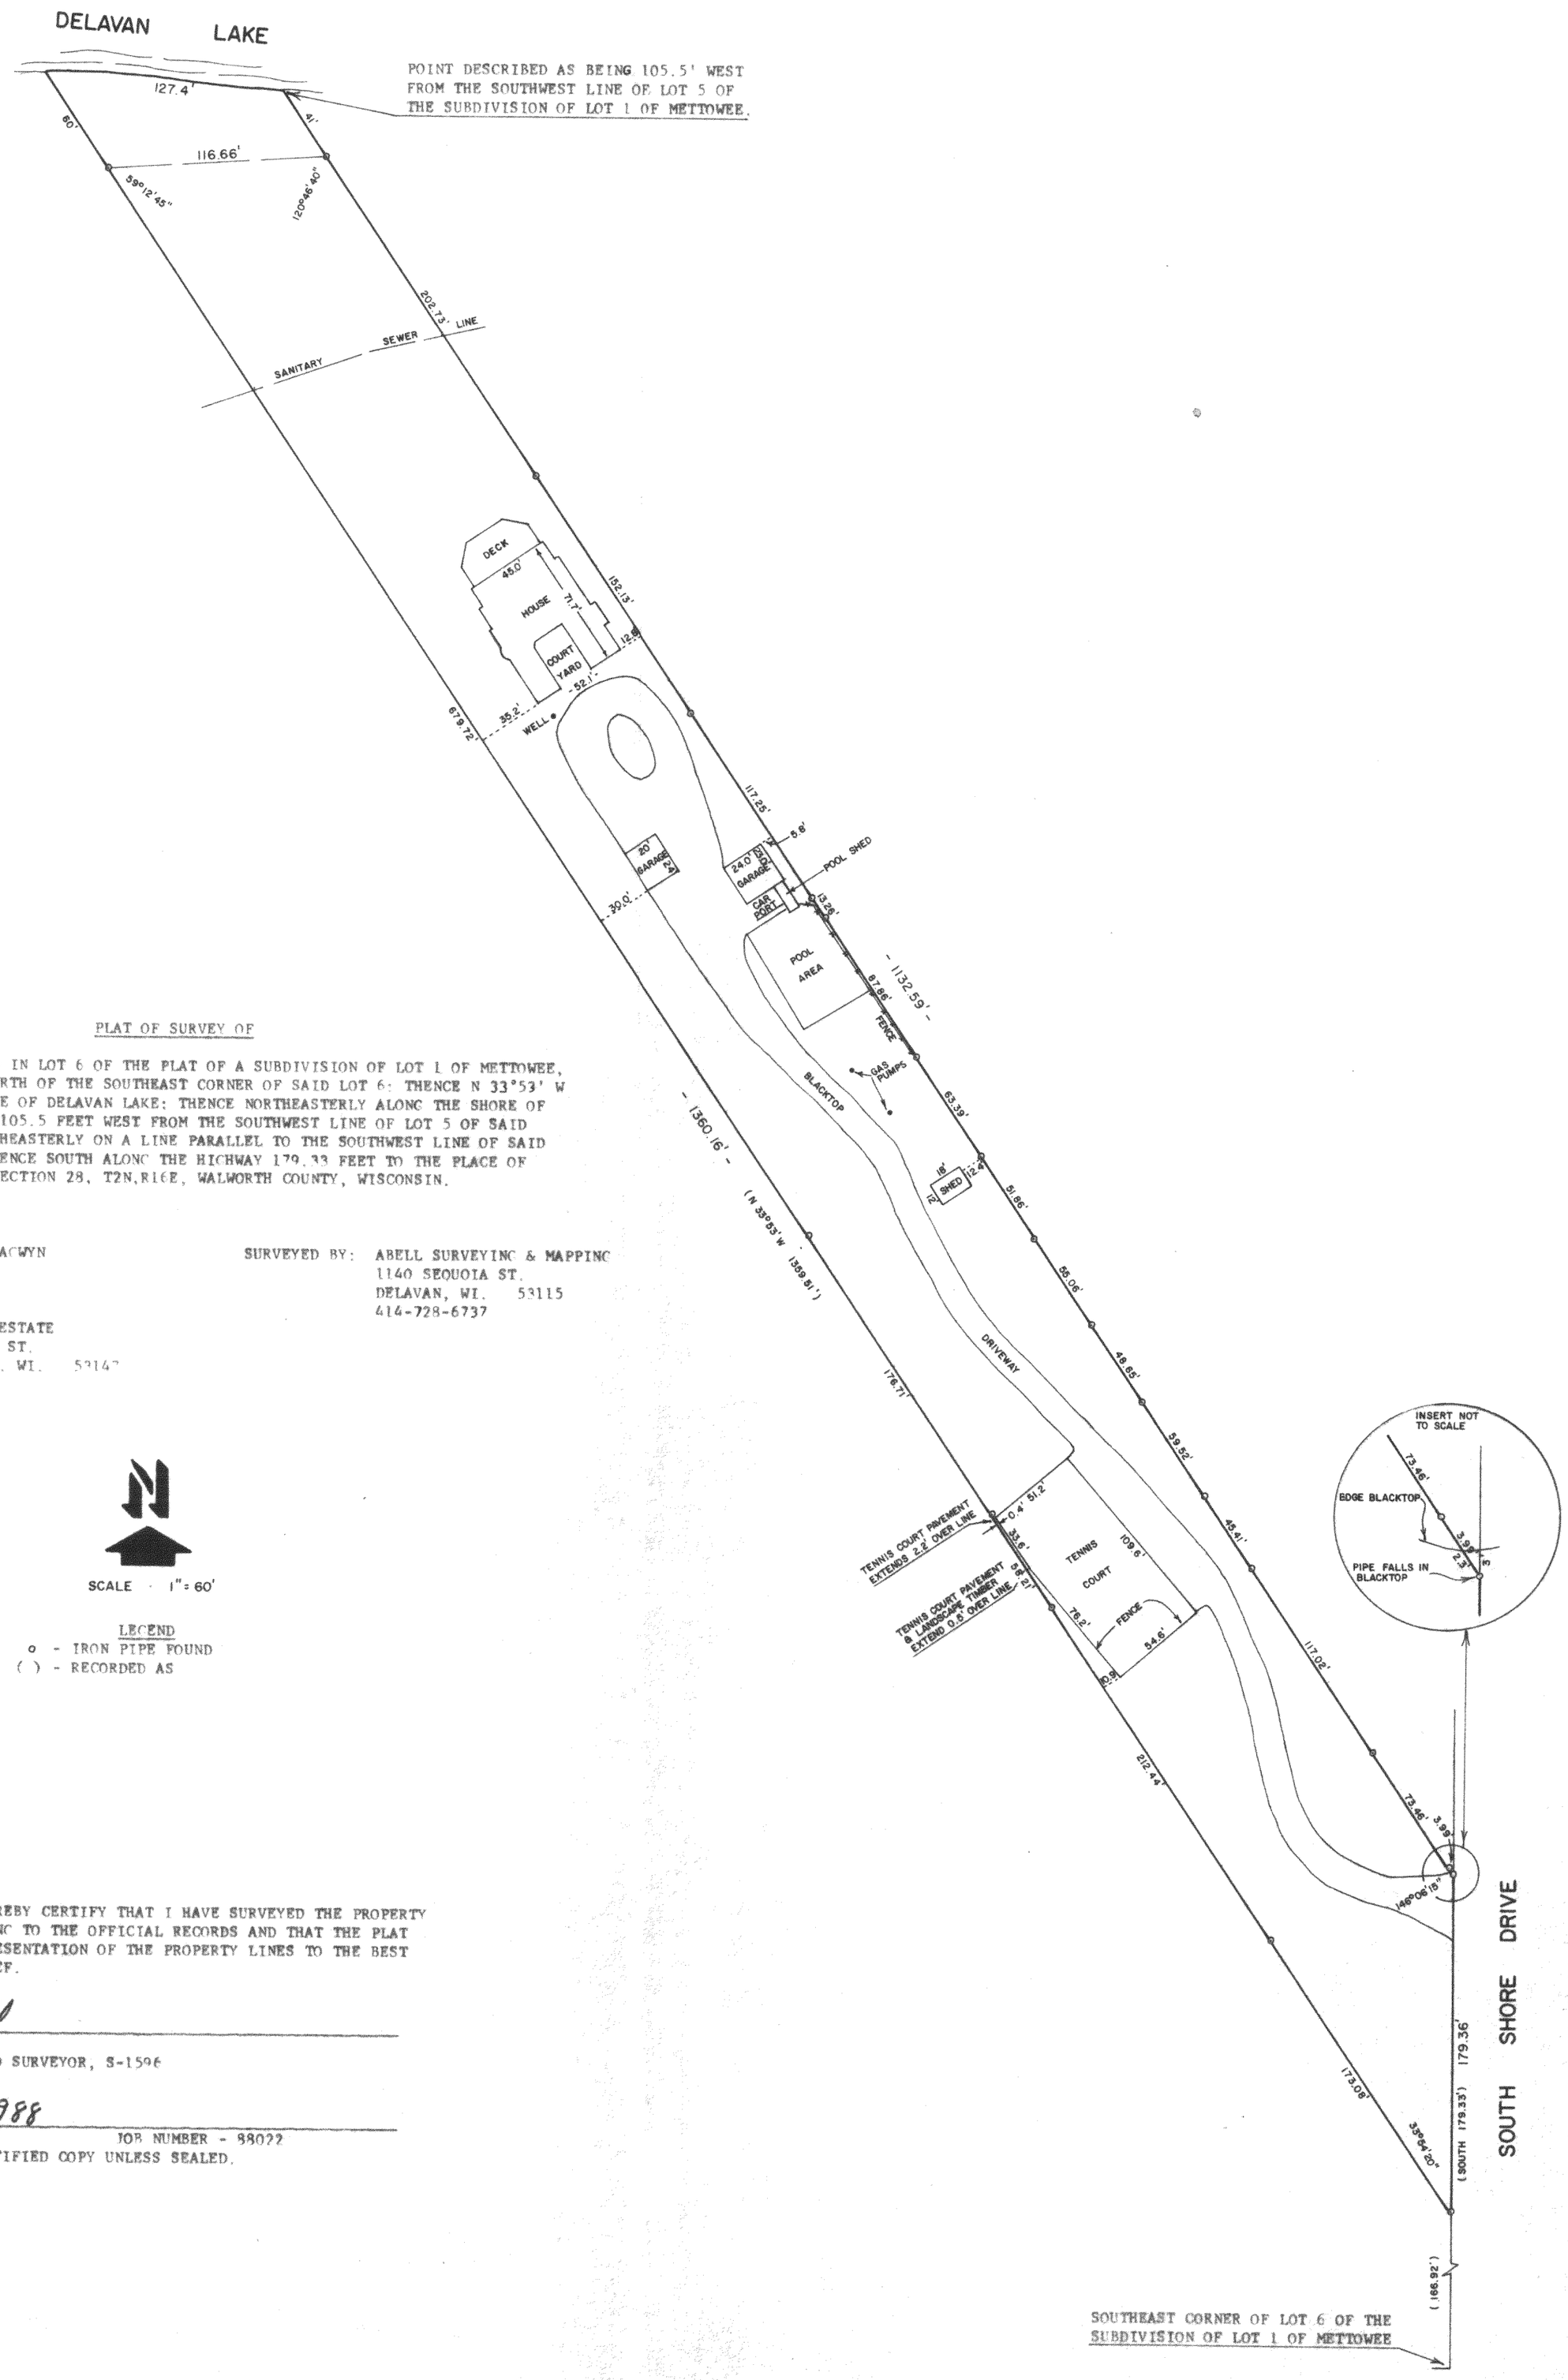

PLAT OF SURVEY OF

A PARCEL OF LAND LOCATED IN LOT 6 OF THE PLAT OF A SUBDIVISION OF LOT 1 OF METTOWEE, BEGINNING 166.92 FEET NORTH OF THE SOUTHEAST CORNER OF SAID LOT 6; THENCE N 33°53' W 1359.51 FEET TO THE SHORE OF DELAVAN LAKE; THENCE NORTHEASTERLY ALONG THE SHORE OF DELAVAN LAKE TO A POINT 105.5 FEET WEST FROM THE SOUTHWEST LINE OF LOT 5 OF SAID SUBDIVISION; THENCE SOUTHEASTERLY ON A LINE PARALLEL TO THE SOUTHWEST LINE OF SAID LOT 5 TO THE HIGHWAY; THENCE SOUTH ALONG THE HIGHWAY 179.33 FEET TO THE PLACE OF BEGINNING. LOCATED IN SECTION 28, T2N,R16E, WALWORTH COUNTY, WISCONSIN.

OWNER: IRENE E. LONZE ZAGWYN

ORDERED BY: KEEFE REAL ESTATE
704 W. MAIN ST.
LAKE GENEVA, WI. 53147

SURVEYED BY: ABELL SURVEYING & MAPPING
1140 SEQUOIA ST.
DELAVAN, WI. 53115
414-728-6737

RECEIVED
APR 7 '88

SCALE - 1" = 60'

LEGEND
o - IRON PIPE FOUND
( ) - RECORDED AS

I, DAVID F. ABELL, DO HEREBY CERTIFY THAT I HAVE SURVEYED THE PROPERTY HEREON DESCRIBED ACCORDING TO THE OFFICIAL RECORDS AND THAT THE PLAT HEREON IS A CORRECT REPRESENTATION OF THE PROPERTY LINES TO THE BEST OF MY KNOWLEDGE AND BELIEF.

David F. Abell
DAVID F. ABELL
WISCONSIN REGISTERED LAND SURVEYOR, S-1596

March 14, 1988
DATE JOB NUMBER - 88022

NOTE: THIS IS NOT A CERTIFIED COPY UNLESS SEALED.

FMT 1-8

216-1005