ABELL
SURVEYING & MAPPING

DELAVAN, WISCONSIN 53115
414-728-6737

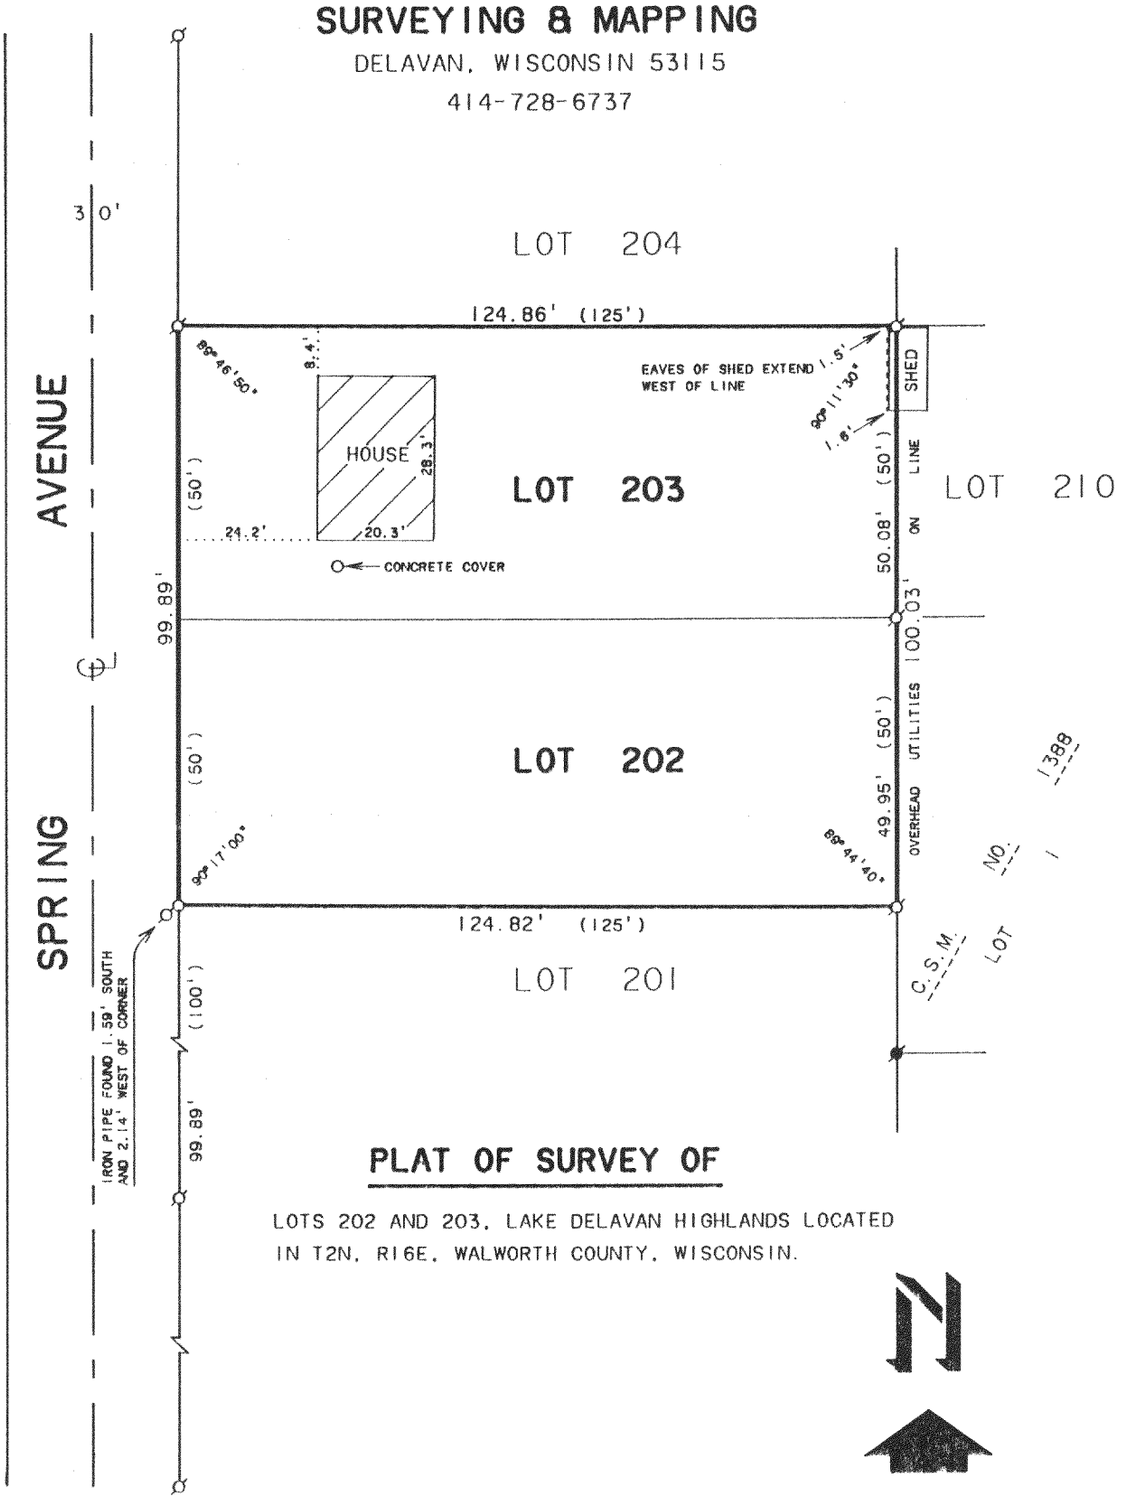

PLAT OF SURVEY OF

LOTS 202 AND 203, LAKE DELAVAN HIGHLANDS LOCATED IN T2N, R16E, WALWORTH COUNTY, WISCONSIN.

SCALE 1"=30'

LEGEND

- ⌀ - IRON PIPE FOUND
- ● - IRON ROD FOUND
- O - IRON PIPE SET
- ( )-RECORDED AS

RECEIVED
NOV 19 1991
dg

ORDERED BY: CHARLES TOWNSEND
1839 GRANT STREET
EVANSTON, IL. 60201

I, DAVID F. ABELL, DO HEREBY CERTIFY THAT I HAVE SURVEYED THE PROPERTY HEREON DESCRIBED ACCORDING TO THE OFFICAL RECORDS AND THAT THE PLAT HEREON IS A CORRECT REPRESENTATION OF THE PROPERTY LINES TO THE BEST OF MY KNOWLEDGE AND BELIEF.

David F. Abell

DAVID F. ABELL
WISCONSIN REGISTERED LAND SURVEYOR, S-1596

August 22, 1991
DATE

JOB NUMBER - 91173

NOTE: THIS IS NOT A CERTIFIED COPY UNLESS SEALED.

216-1470

FLAD- 154