


DUNHAM SURVEYING, S.C.
 SURVEYING & SUBDIVIDING
 DELAVAN, WISCONSIN 53115

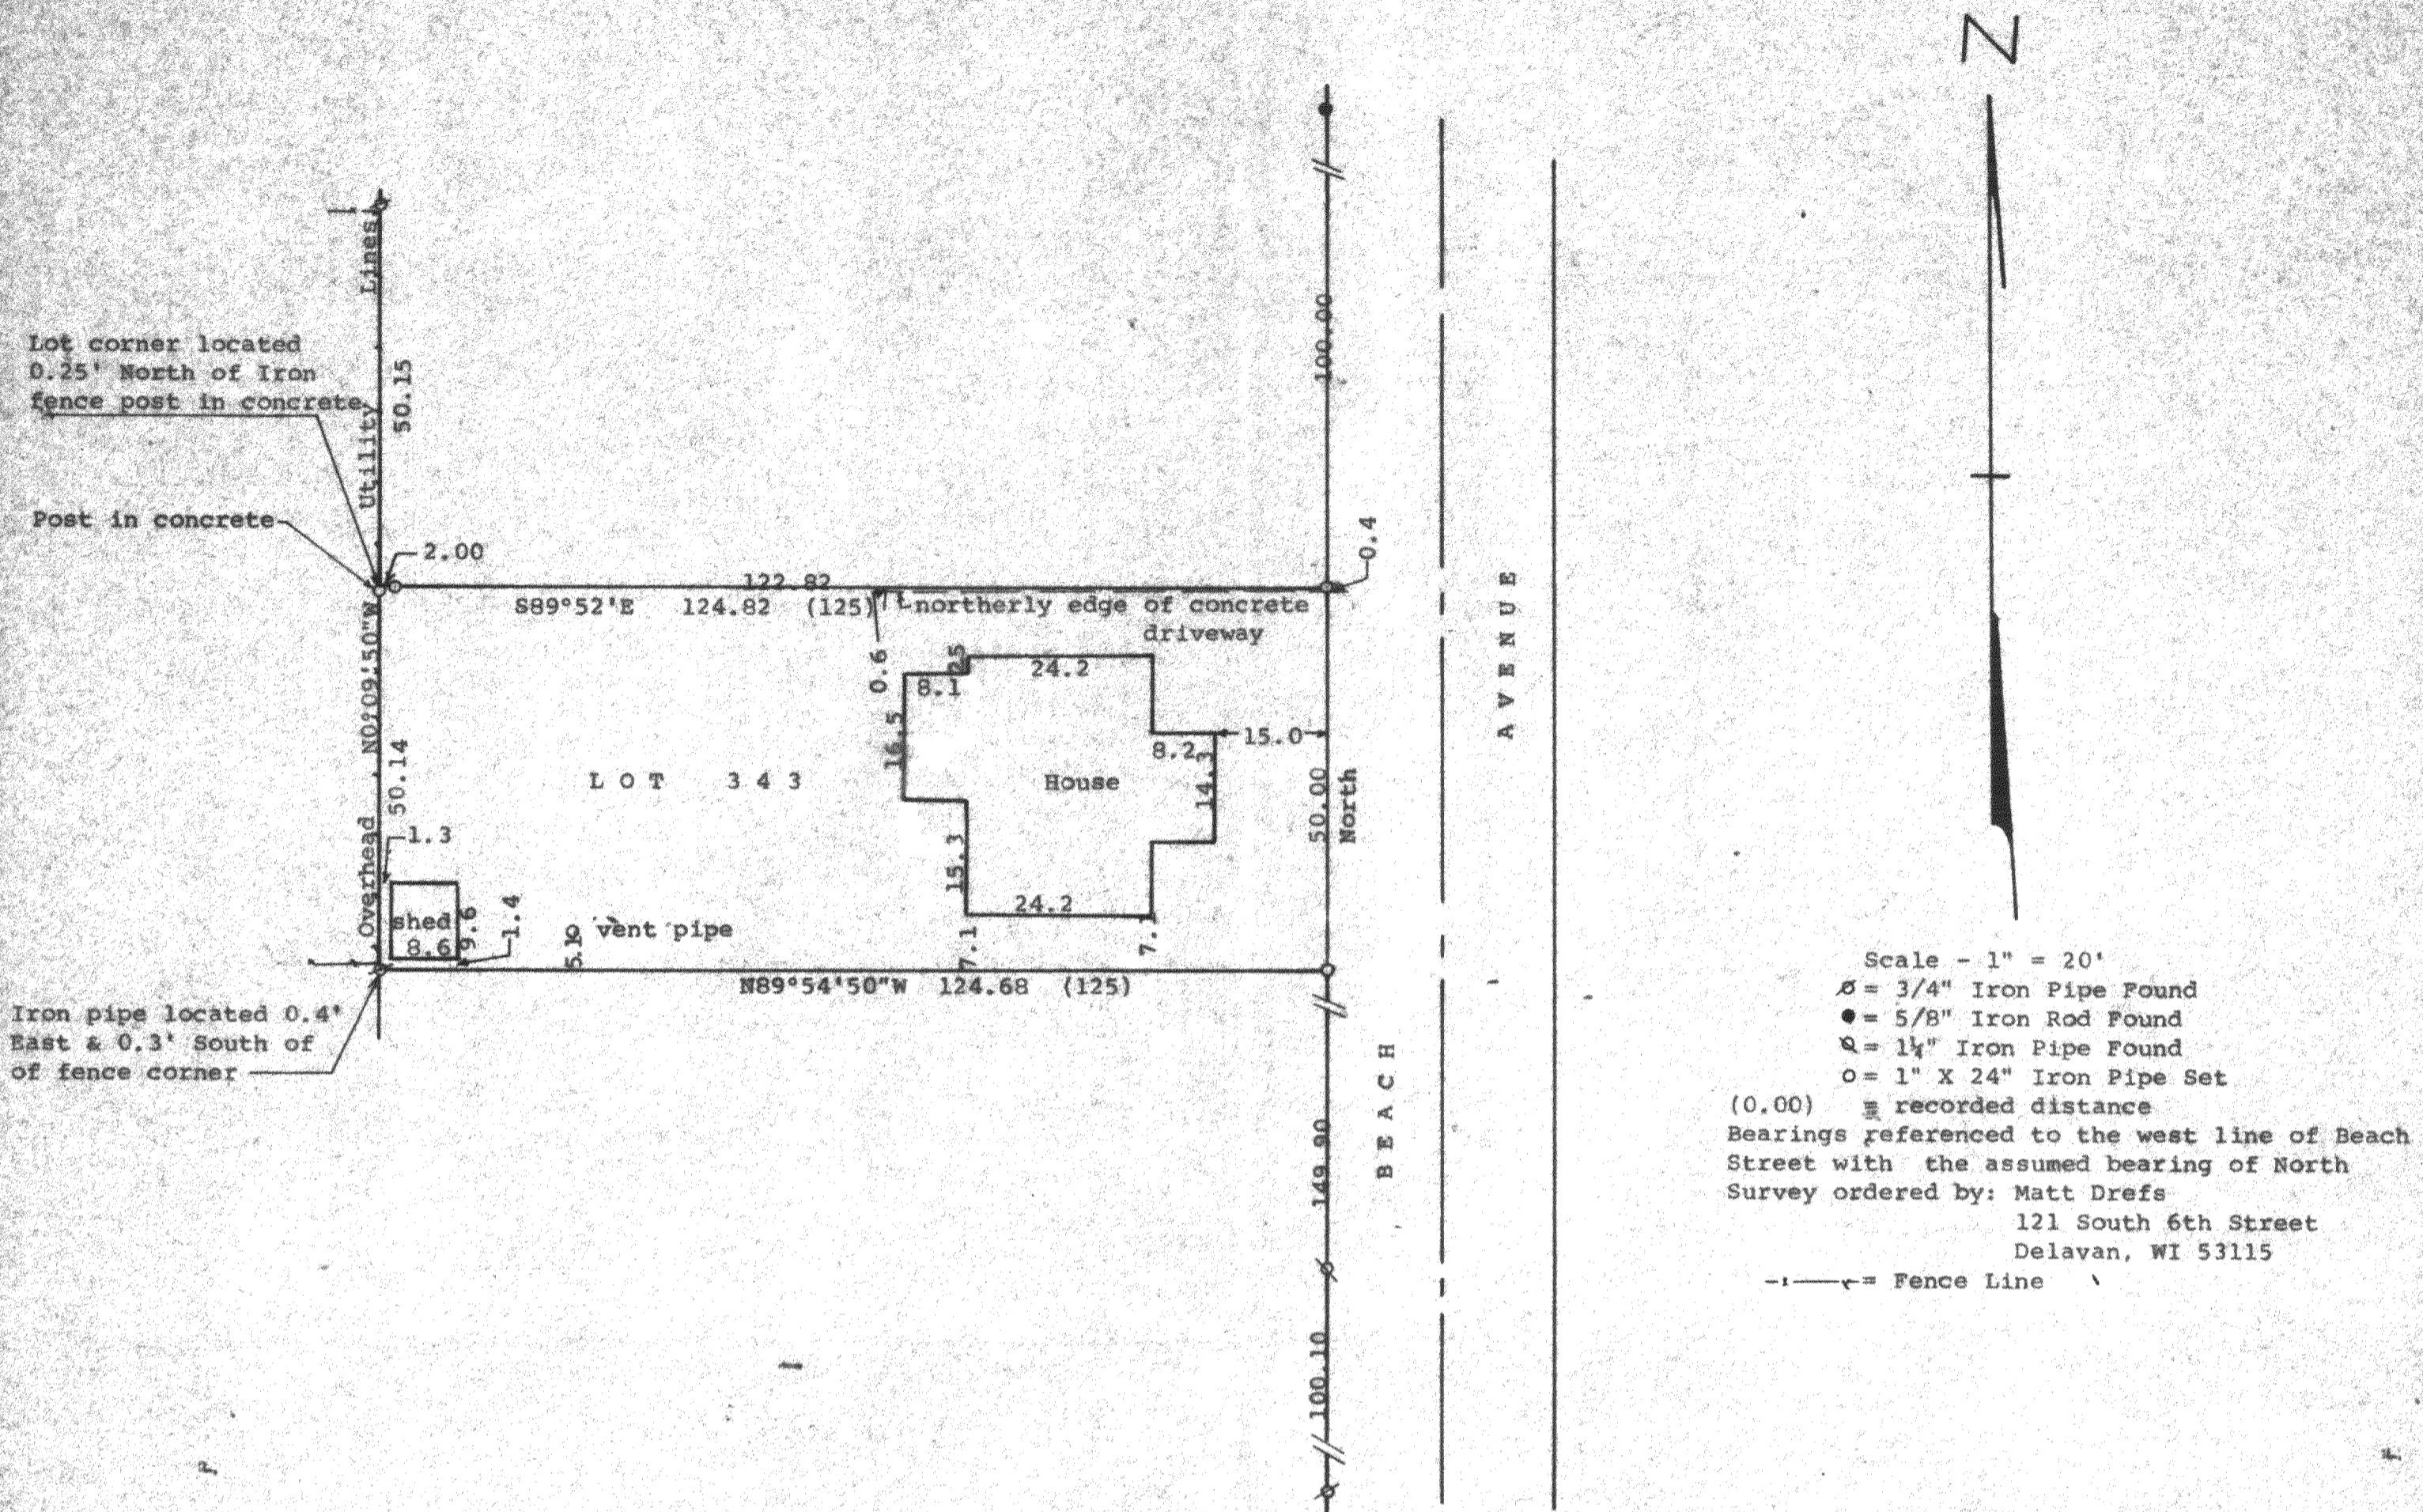

N

Scale - 1" = 20'
 ⌀ = 3/4" Iron Pipe Found
 ● = 5/8" Iron Rod Found
 ○ = 1 1/4" Iron Pipe Found
 ○ = 1" X 24" Iron Pipe Set
 (0.00) = recorded distance
 Bearings referenced to the west line of Beach Street with the assumed bearing of North
 Survey ordered by: Matt Drefs
 121 South 6th Street
 Delavan, WI 53115
 - - - - - Fence Line

STATE OF WISCONSIN)
 COUNTY OF WALWORTH) SS

I, George T. Dunham, Surveyor, certify that I have surveyed the property described as follows:
 Lot 343 in Lake Delavan Highlands, a subdivision located in Section 31, T 2 N, R 16 E, Walworth County, Wisconsin, and that the plat shown hereon is a correct representation thereof and shows the size and location of the property, its exterior boundaries, the location of all visible structures and dimensions of all principal buildings thereon, boundary fences, apparent easements, roadways and visible encroachments, if any, and that I have surveyed the property hereon described, according to the official records, to the best of my knowledge and belief.
 August 16, 1991

George T. Dunham
 George T. Dunham, Surveyor

