DUNHAM SURVEYING, S.C.

SURVEYING & SUBDIVIDING
DELAVAN, WISCONSIN 53115

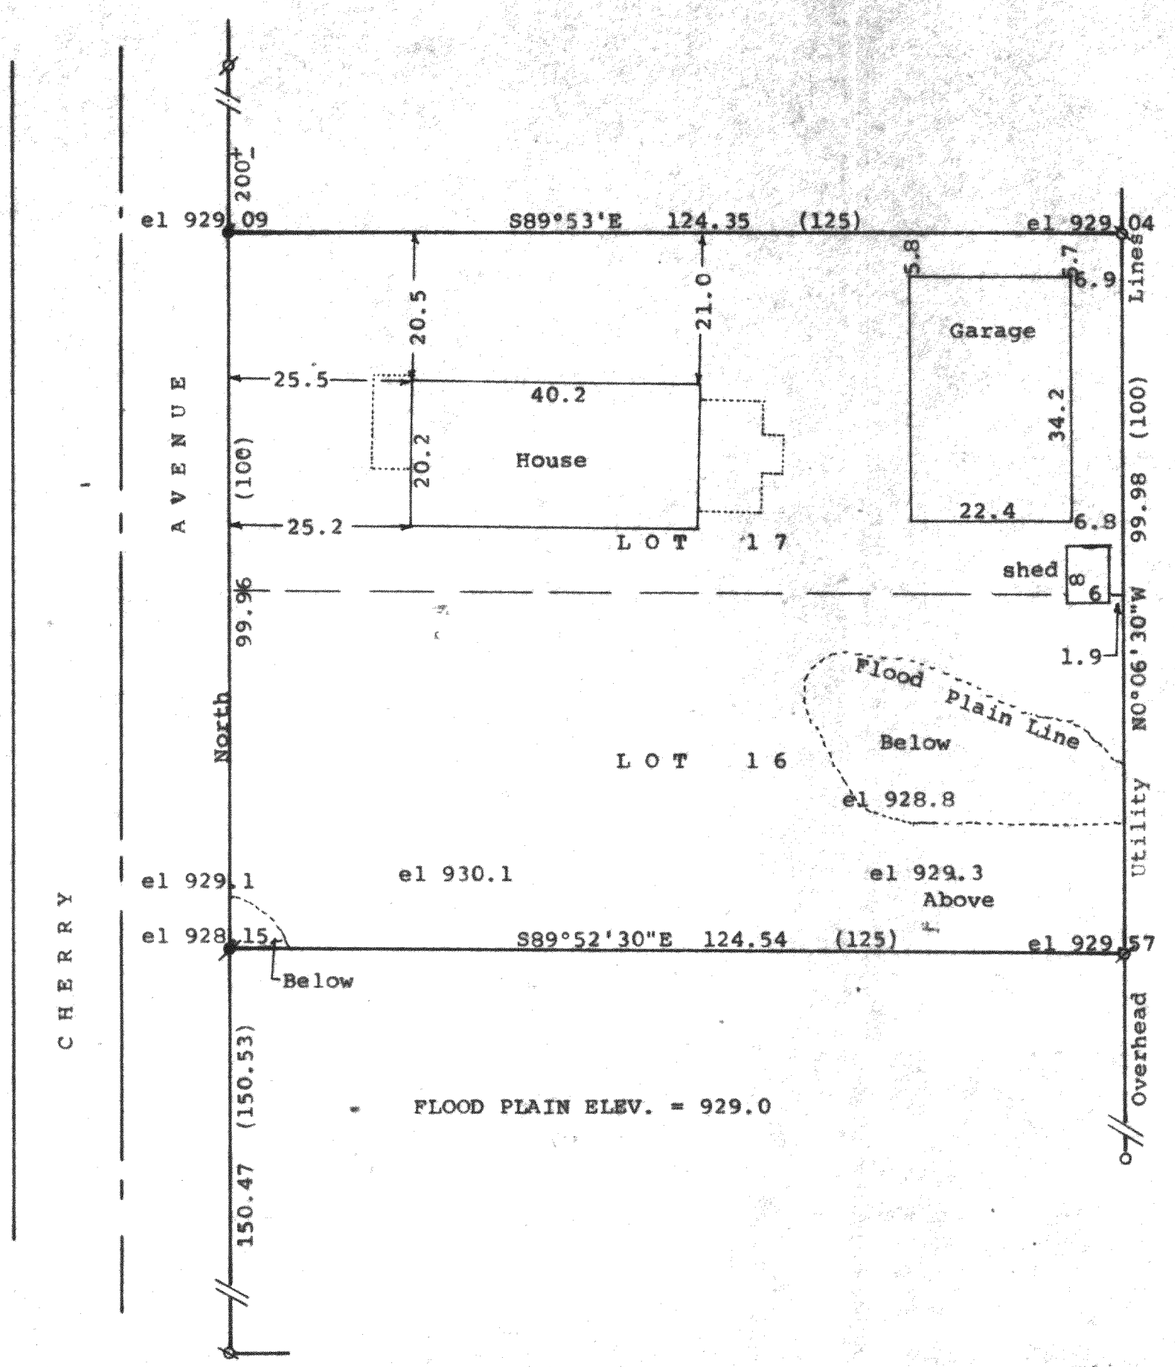

Scale - 1" = 20'
⌀ = 1¼" Iron Pipe Found
○ = 1" Iron Pipe Found
⌀ = 3/4" Iron Pipe Found
⌀ = 1¼" X 24" Iron Pipe Set
● = 1" X 24" Iron Pipe Set
(0.00) = recorded distance
Bearings referenced to the east line of Cherry Avenue with the assumed bearing of North
Survey ordered by:
Ed Brien
Lake Delavan Highlands
Delavan, WI 53115

STATE OF WISCONSIN)
COUNTY OF WALWORTH) SS

I, George T. Dunham, Surveyor, certify that I have surveyed the property described as follows:

Lots 16 and 17 in Lake Delavan Highlands, a subdivision located in the Southeast ¼ of Section 31, T 2 N, R 16 E. Walworth County, Wisconsin, and that the plat shown hereon is a correct representation thereof and shows the size and location of the property, its exterior boundaries, the location of all visible structures and dimensions of all principal buildings thereon, boundary fences, apparent easements, roadways and visible encroachments, if any, and that I have surveyed the property hereon described, according to the official records, to the best of my knowledge and belief.

August 19, 1992
Updated to show elevations
Sept. 8, 1992
Revised Sept. 16, 1992

George T. Dunham, Surveyor

WISCONSIN
GEORGE T. DUNHAM
S-306
DELAVAN WIS.
LAND SURVEYOR

RECEIVED
FEB 11 1993

GMB 1020

216-1686

FLAD-14
FLAD-15