WALWORTH COUNTY
SURVEYING & MAPPING
727 HENRY STREET
LAKE GENEVA, WISCONSIN
414-248-0505

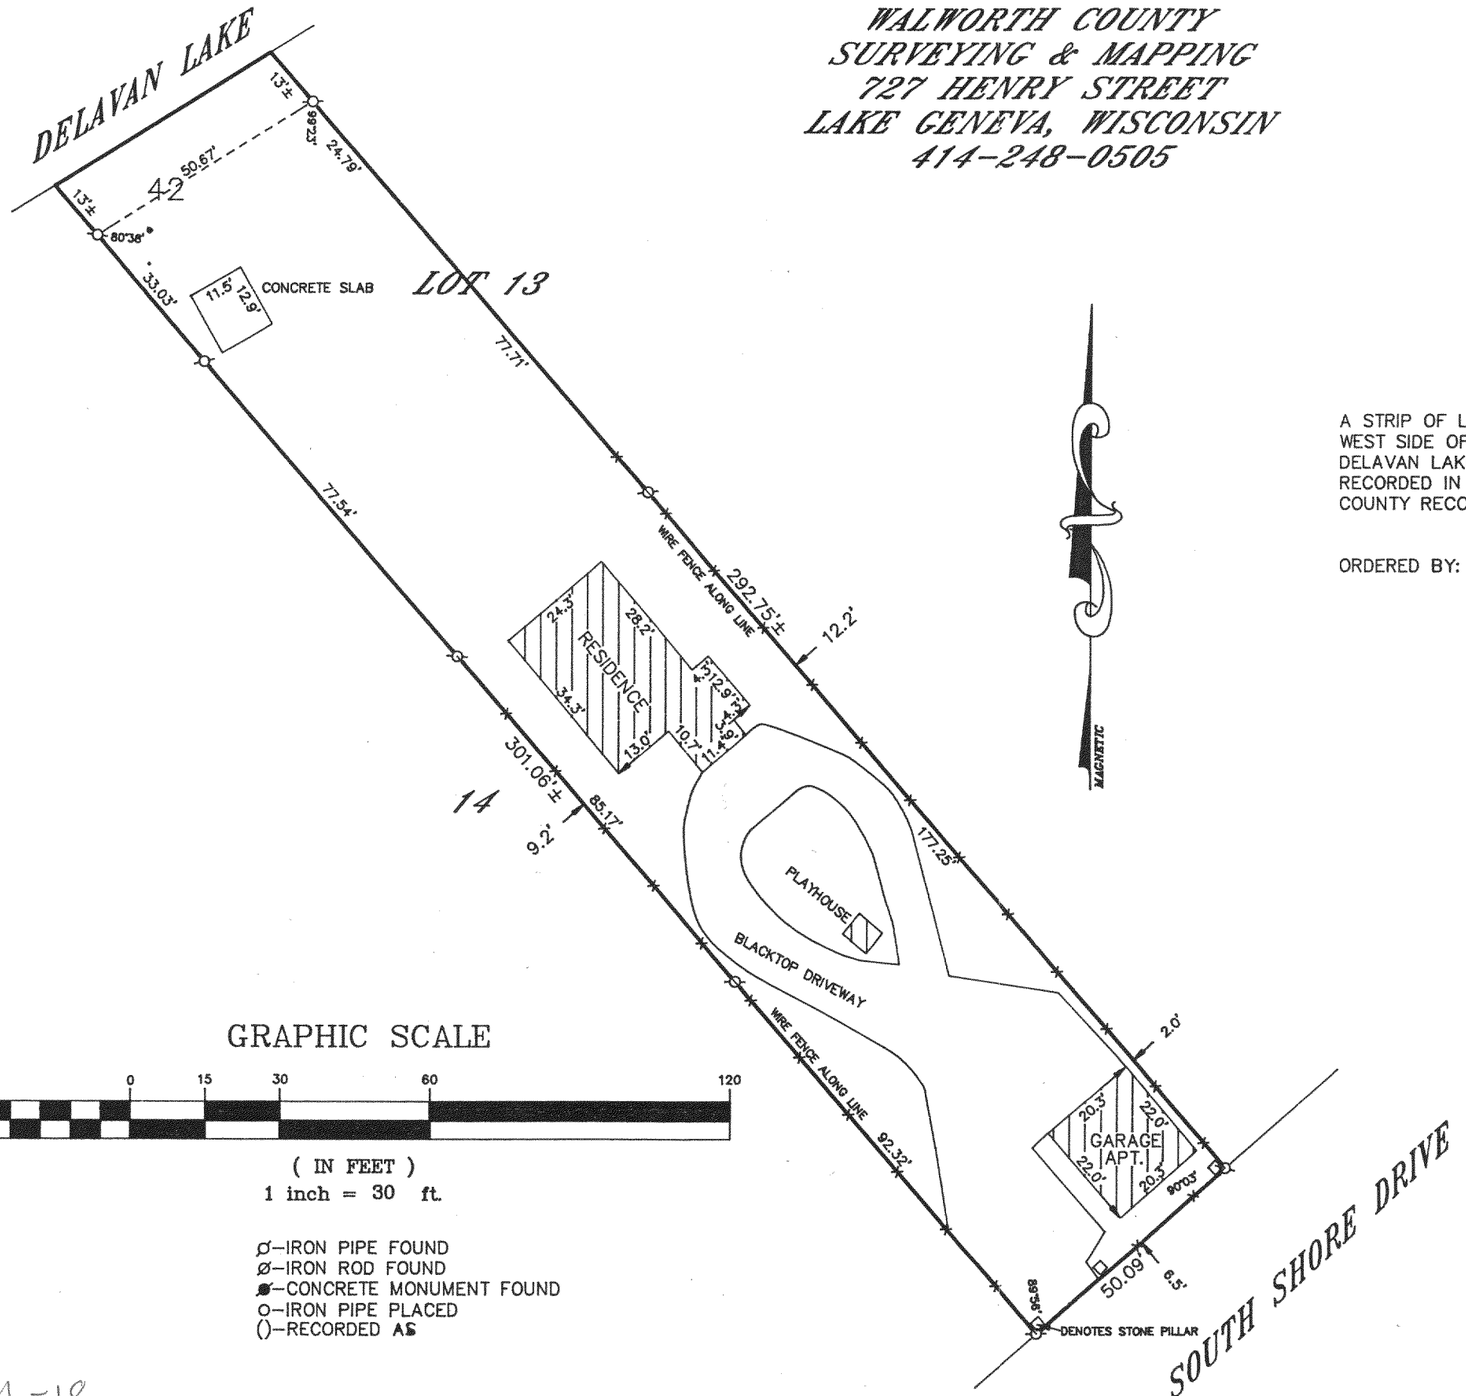

GRAPHIC SCALE

30 0 15 30 60 120

(IN FEET)
1 inch = 30 ft.

ø—IRON PIPE FOUND
ø—IRON ROD FOUND
●—CONCRETE MONUMENT FOUND
o—IRON PIPE PLACED
()—RECORDED AS

FHA-18

PLAT OF SURVEY OF

A STRIP OF LAND FIFTY (50) FEET IN WIDTH OFF THE ENTIRE WEST SIDE OF LOT THIRTEEN (13), IN HARRINGTON SUBDIVISION, DELAVAN LAKE, WALWORTH COUNTY, WISCONSIN, AS PER PLAT RECORDED IN VOLUME 6 OF PLATS, PAGES 80 AND 81, WALWORTH COUNTY RECORDS.

ORDERED BY: COLDWELL BANKER
GENEVA LAKES AREA REALTORS
838 MAIN STREET
LAKE GENEVA, WISCONSIN
53147

RECEIVED
JUN 9 1993

I HEREBY CERTIFY THAT I HAVE SURVEYED THE ABOVE DESCRIBED PROPERTY AND THAT THE ABOVE MAP IS A TRUE REPRESENTATION THEREOF AND SHOWS THE SIZE AND LOCATION OF THE PROPERTY, ITS EXTERIOR BOUNDARIES, THE LOCATION OF ALL VISIBLE STRUCTURES AND DIMENSIONS OF ALL PRINCIPAL BUILDINGS THEREON, BOUNDARY FENCES, APPARENT EASEMENTS, ROADWAYS AND VISIBLE ENCROACHMENTS, IF ANY, TO THE BEST OF MY KNOWLEDGE AND BELIEF.

THIS SURVEY IS MADE FOR THE USE OF THE PRESENT OWNERS OF THE PROPERTY AND ALSO THOSE WHO PURCHASE, MORTGAGE OR GUARANTEE THE TITLE THERETO WITHIN ONE (1) YEAR FROM DATE HEREOF.

Robert M. Baerenwald

ROBERT M. BAERENWALD
WISCONSIN REGISTERED LAND SURVEYOR, S-1508

April 6, 1993
DATE JOB NO. 3771

NOTE: THIS IS NOT A CERTIFIED COPY UNLESS SEALED.

216-1777