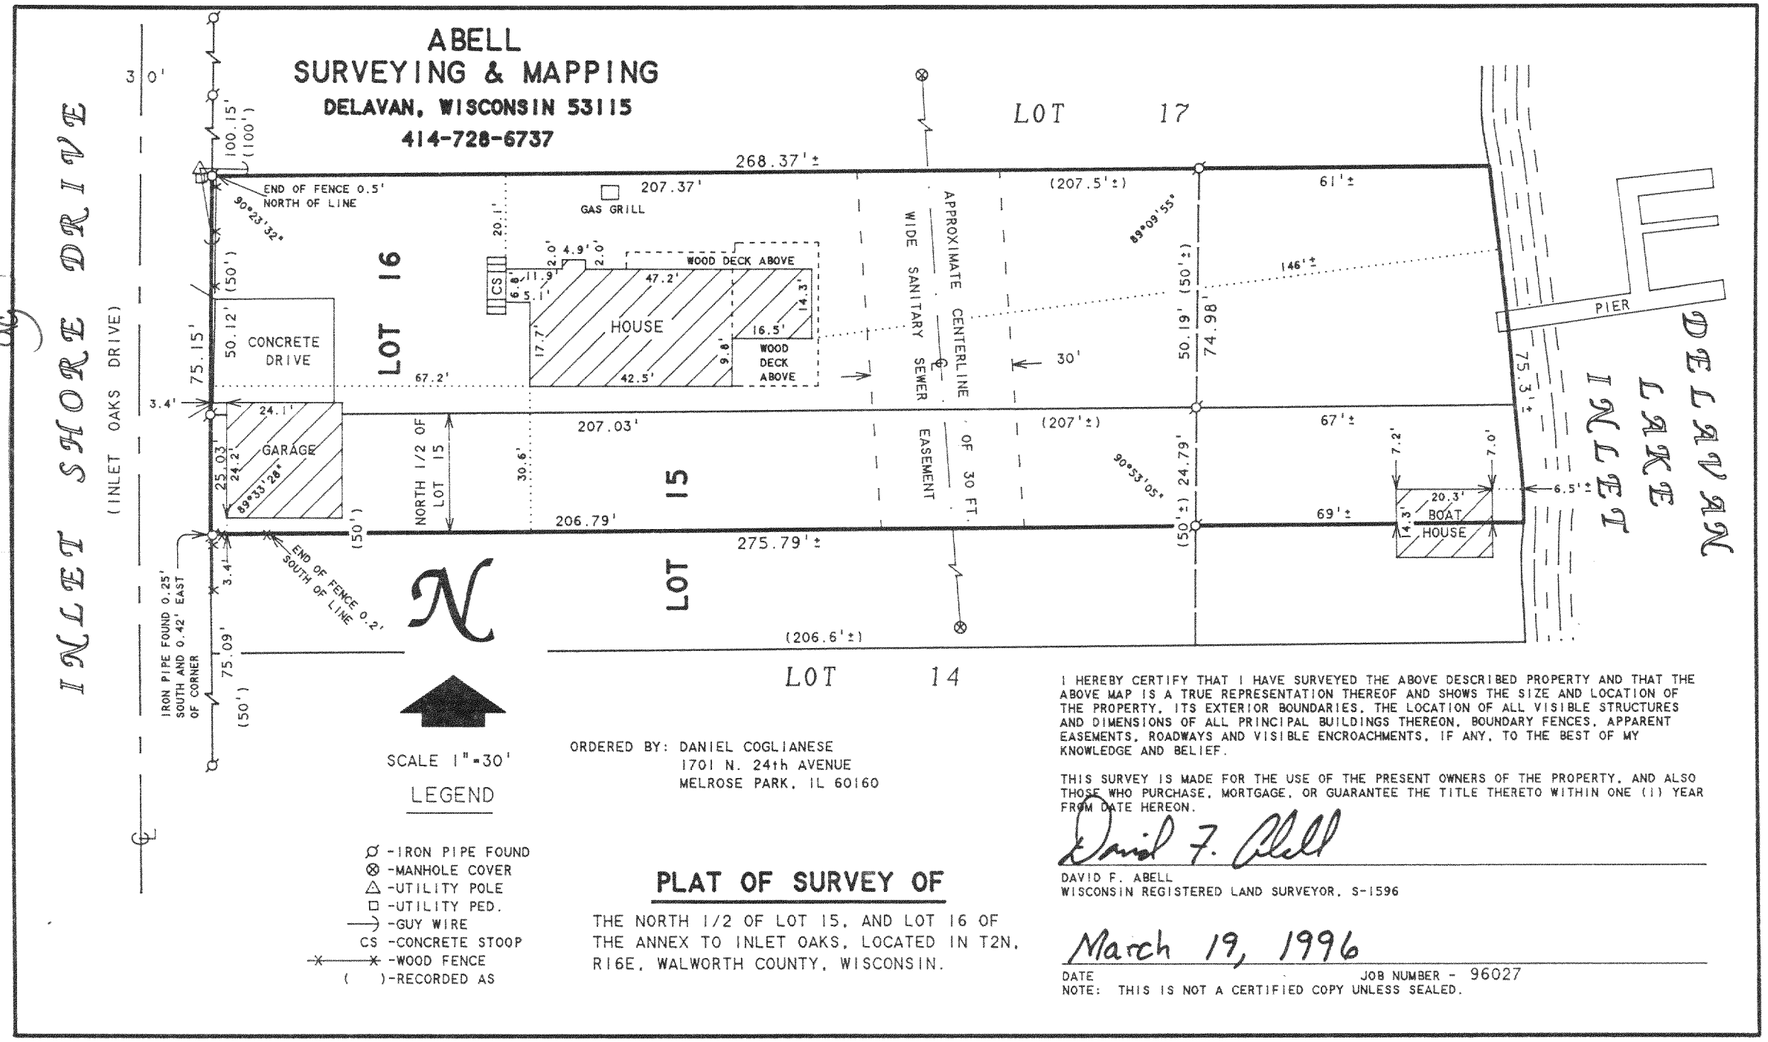

RECEIVED
JUL 23 1996

FIA-14A 216-2318