THE HARRINGTON SUBDIVISION
LOT 10

ABELL
SURVEYING & MAPPING
1140 SEQUOIA STREET • DELAVAN, WISCONSIN 53115
414-728-6737

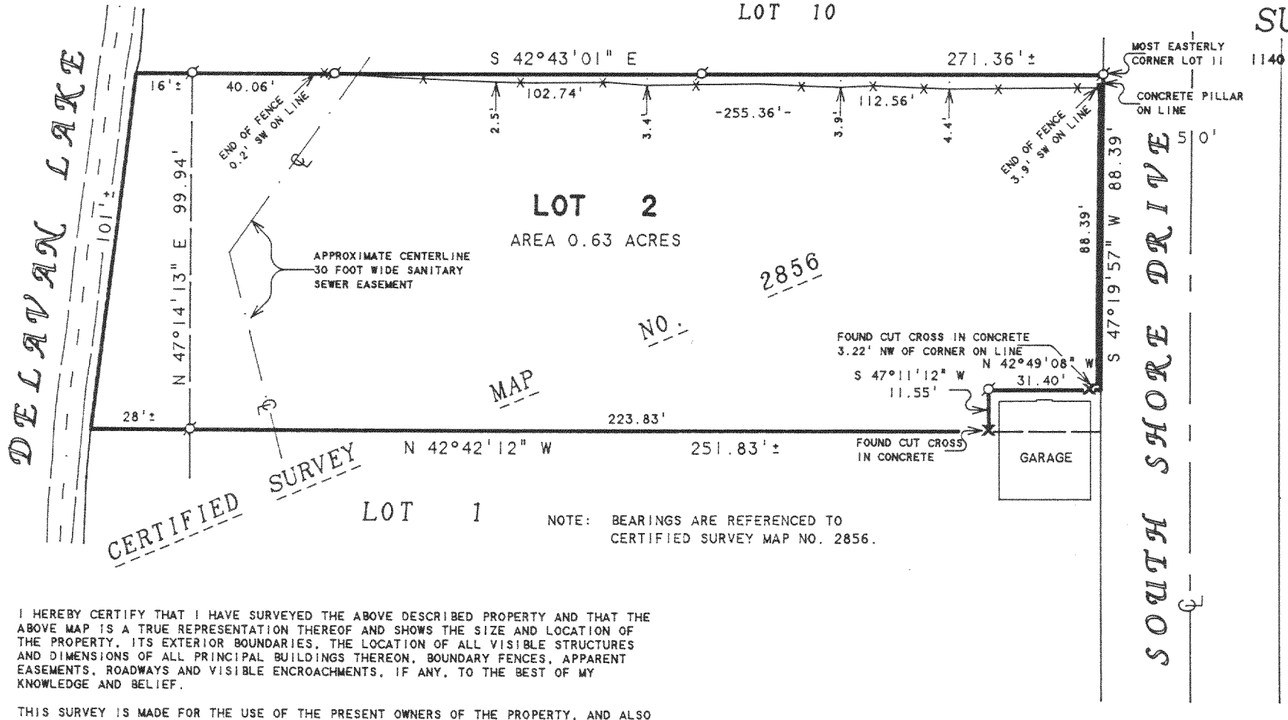


NOTE: BEARINGS ARE REFERENCED TO CERTIFIED SURVEY MAP NO. 2856.

SCALE 1"=20'

LEGEND

- -IRON PIPE FOUND
- -WOOD FENCE
- -CUT CROSS IN CONCRETE FOUND

ORDERED BY: THE RAULAND AGENCY
P.O. BOX 159
WALWORTH, WI. 53184

I HEREBY CERTIFY THAT I HAVE SURVEYED THE ABOVE DESCRIBED PROPERTY AND THAT THE ABOVE MAP IS A TRUE REPRESENTATION THEREOF AND SHOWS THE SIZE AND LOCATION OF THE PROPERTY, ITS EXTERIOR BOUNDARIES, THE LOCATION OF ALL VISIBLE STRUCTURES AND DIMENSIONS OF ALL PRINCIPAL BUILDINGS THEREON, BOUNDARY FENCES, APPARENT EASEMENTS, ROADWAYS AND VISIBLE ENCROACHMENTS, IF ANY, TO THE BEST OF MY KNOWLEDGE AND BELIEF.

THIS SURVEY IS MADE FOR THE USE OF THE PRESENT OWNERS OF THE PROPERTY, AND ALSO THOSE WHO PURCHASE, MORTGAGE, OR GUARANTEE THE TITLE THERETO WITHIN ONE (1) YEAR FROM DATE HEREON.

David F. Abell

DAVID F. ABELL
WISCONSIN REGISTERED LAND SURVEYOR, S-1596

June 10, 1997

DATE JOB NUMBER - 96134

NOTE: THIS IS NOT A CERTIFIED COPY UNLESS SEALED.

## PLAT OF SURVEY OF

LOT 2, CERTIFIED SURVEY MAP NO. 2856, LOCATED IN THE NORTHWEST 1/4 OF SECTION 27, T2N, R[illegible] WALWORTH COUNTY, WISCONSIN.

RECEIVED
1997

FA-2856-2
216-2416