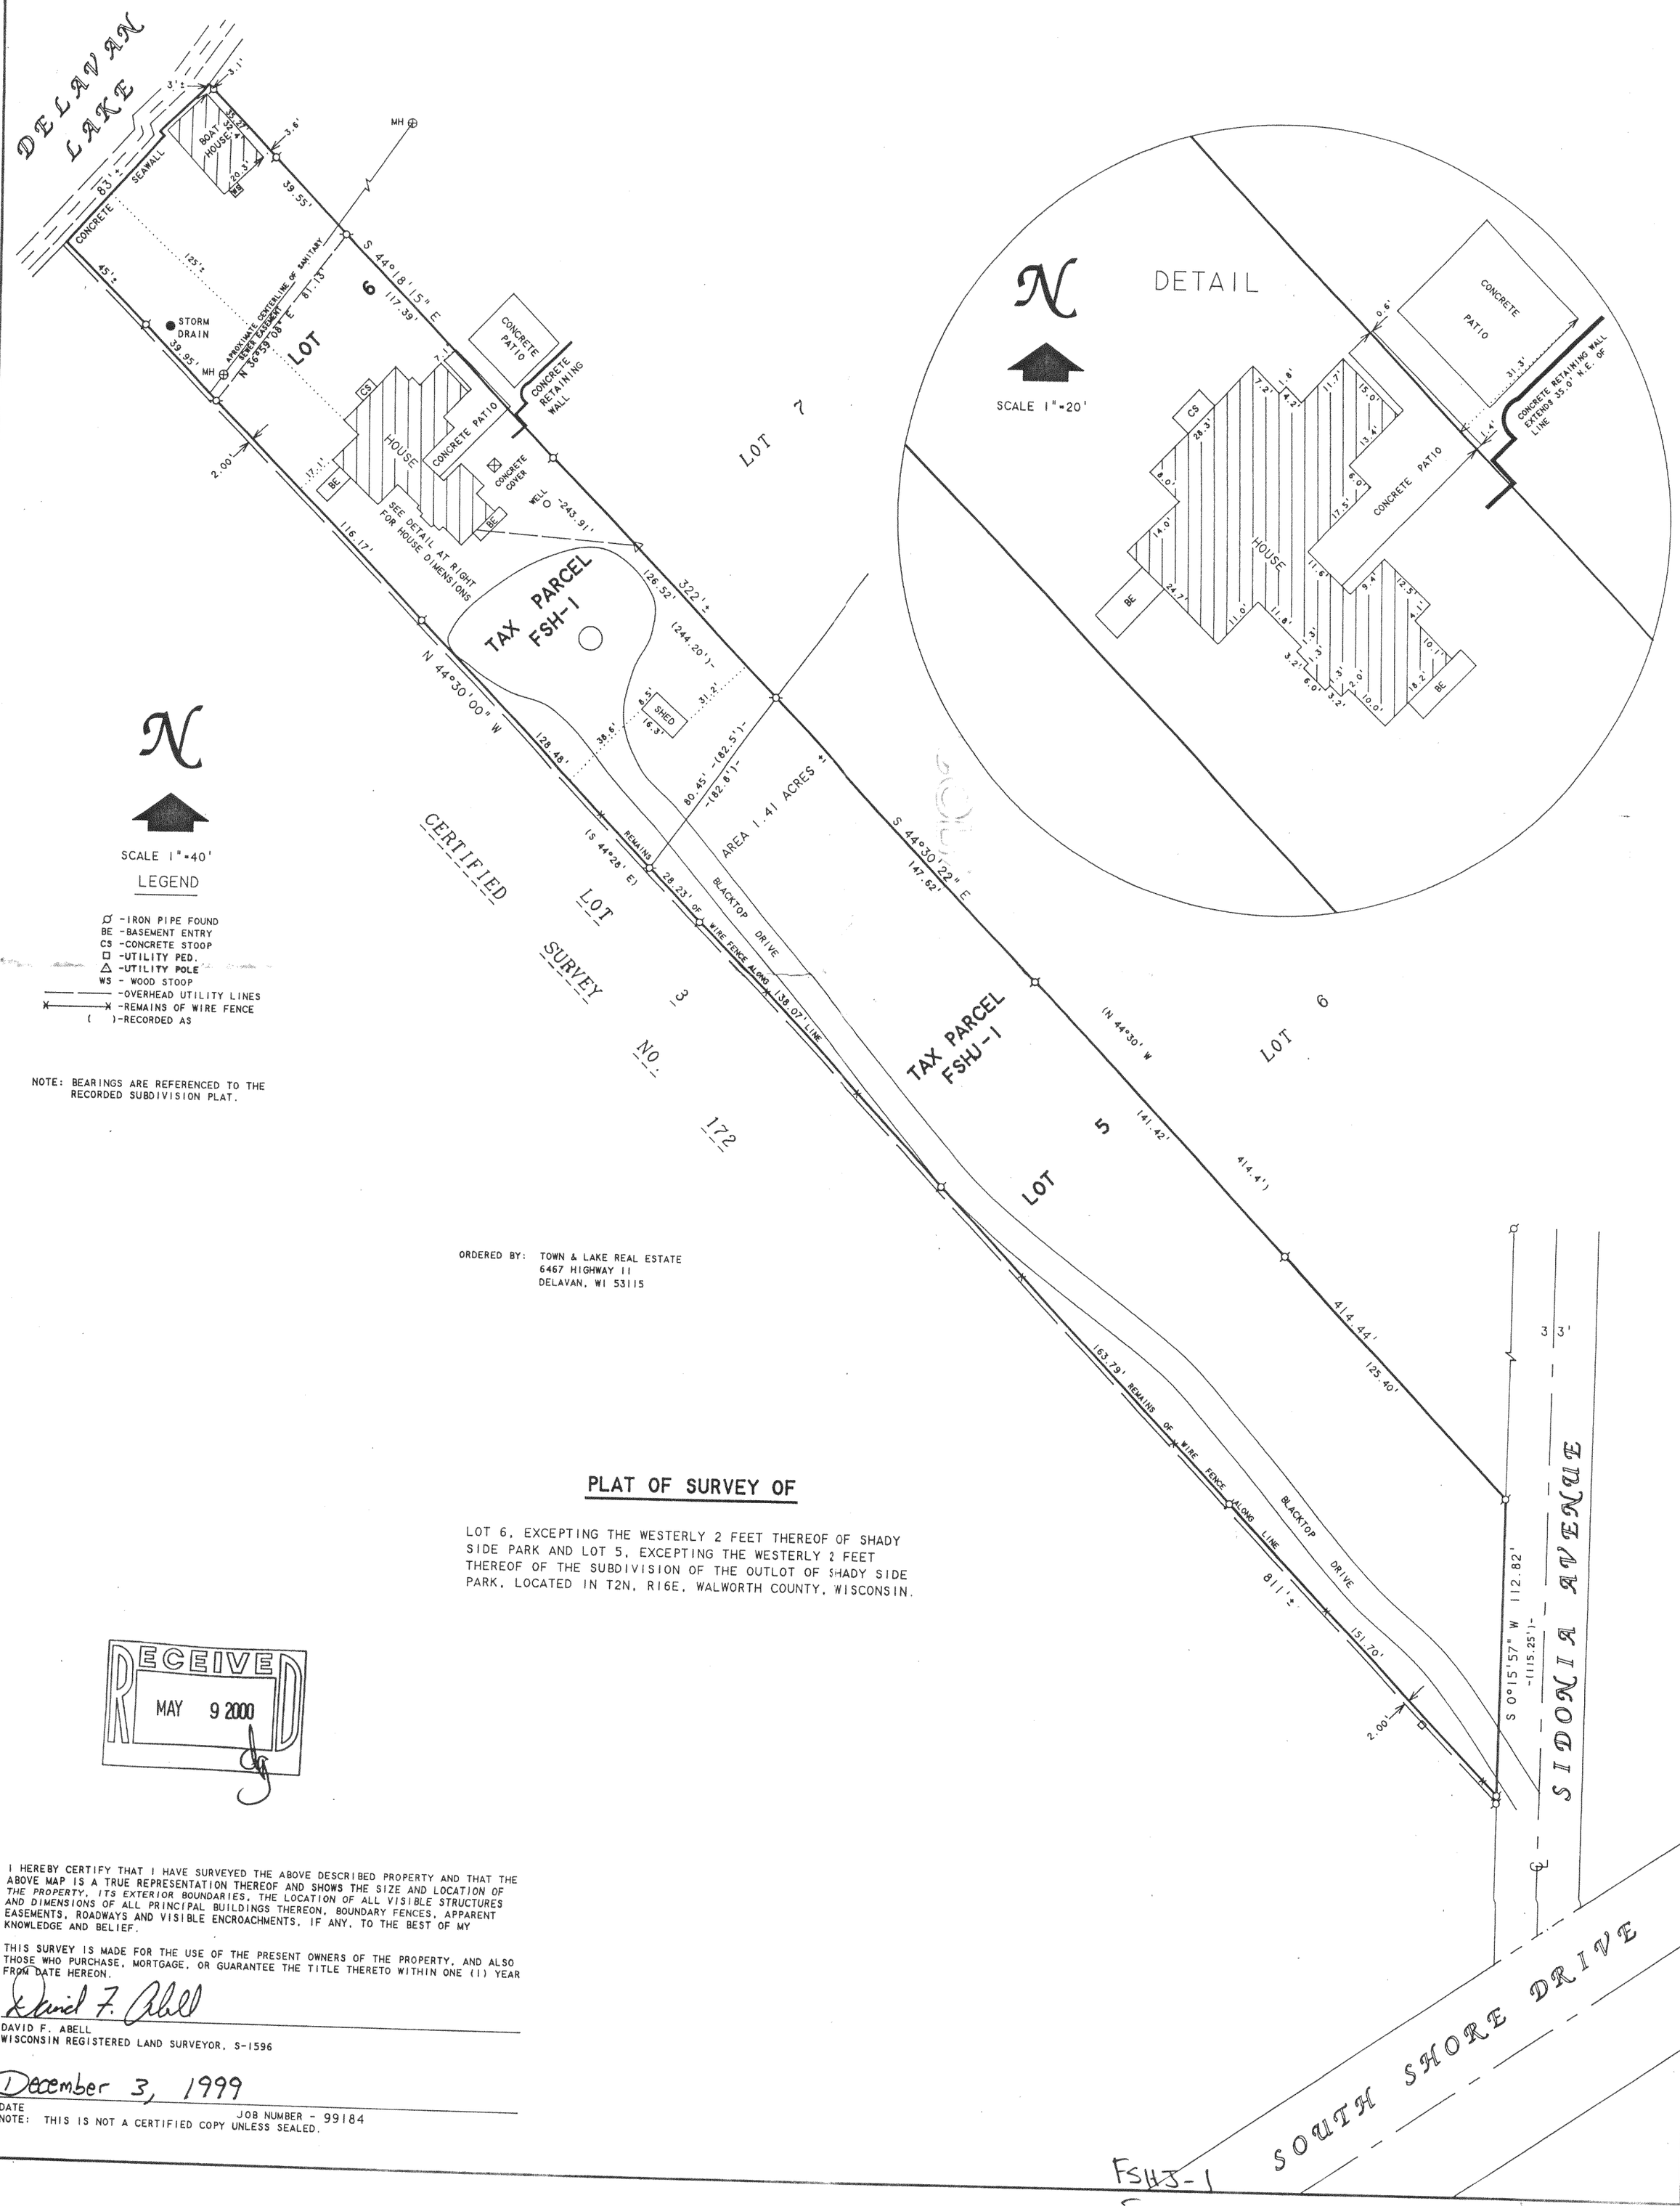ABELL
SURVEYING & MAPPING
1140 SEQUOIA STREET · DELAVAN, WISCONSIN 53115
262-728-6737