ABELL
SURVEYING & MAPPING
1140 SEQUOIA STREET · DELAVAN, WISCONSIN 53115
262-728-6737

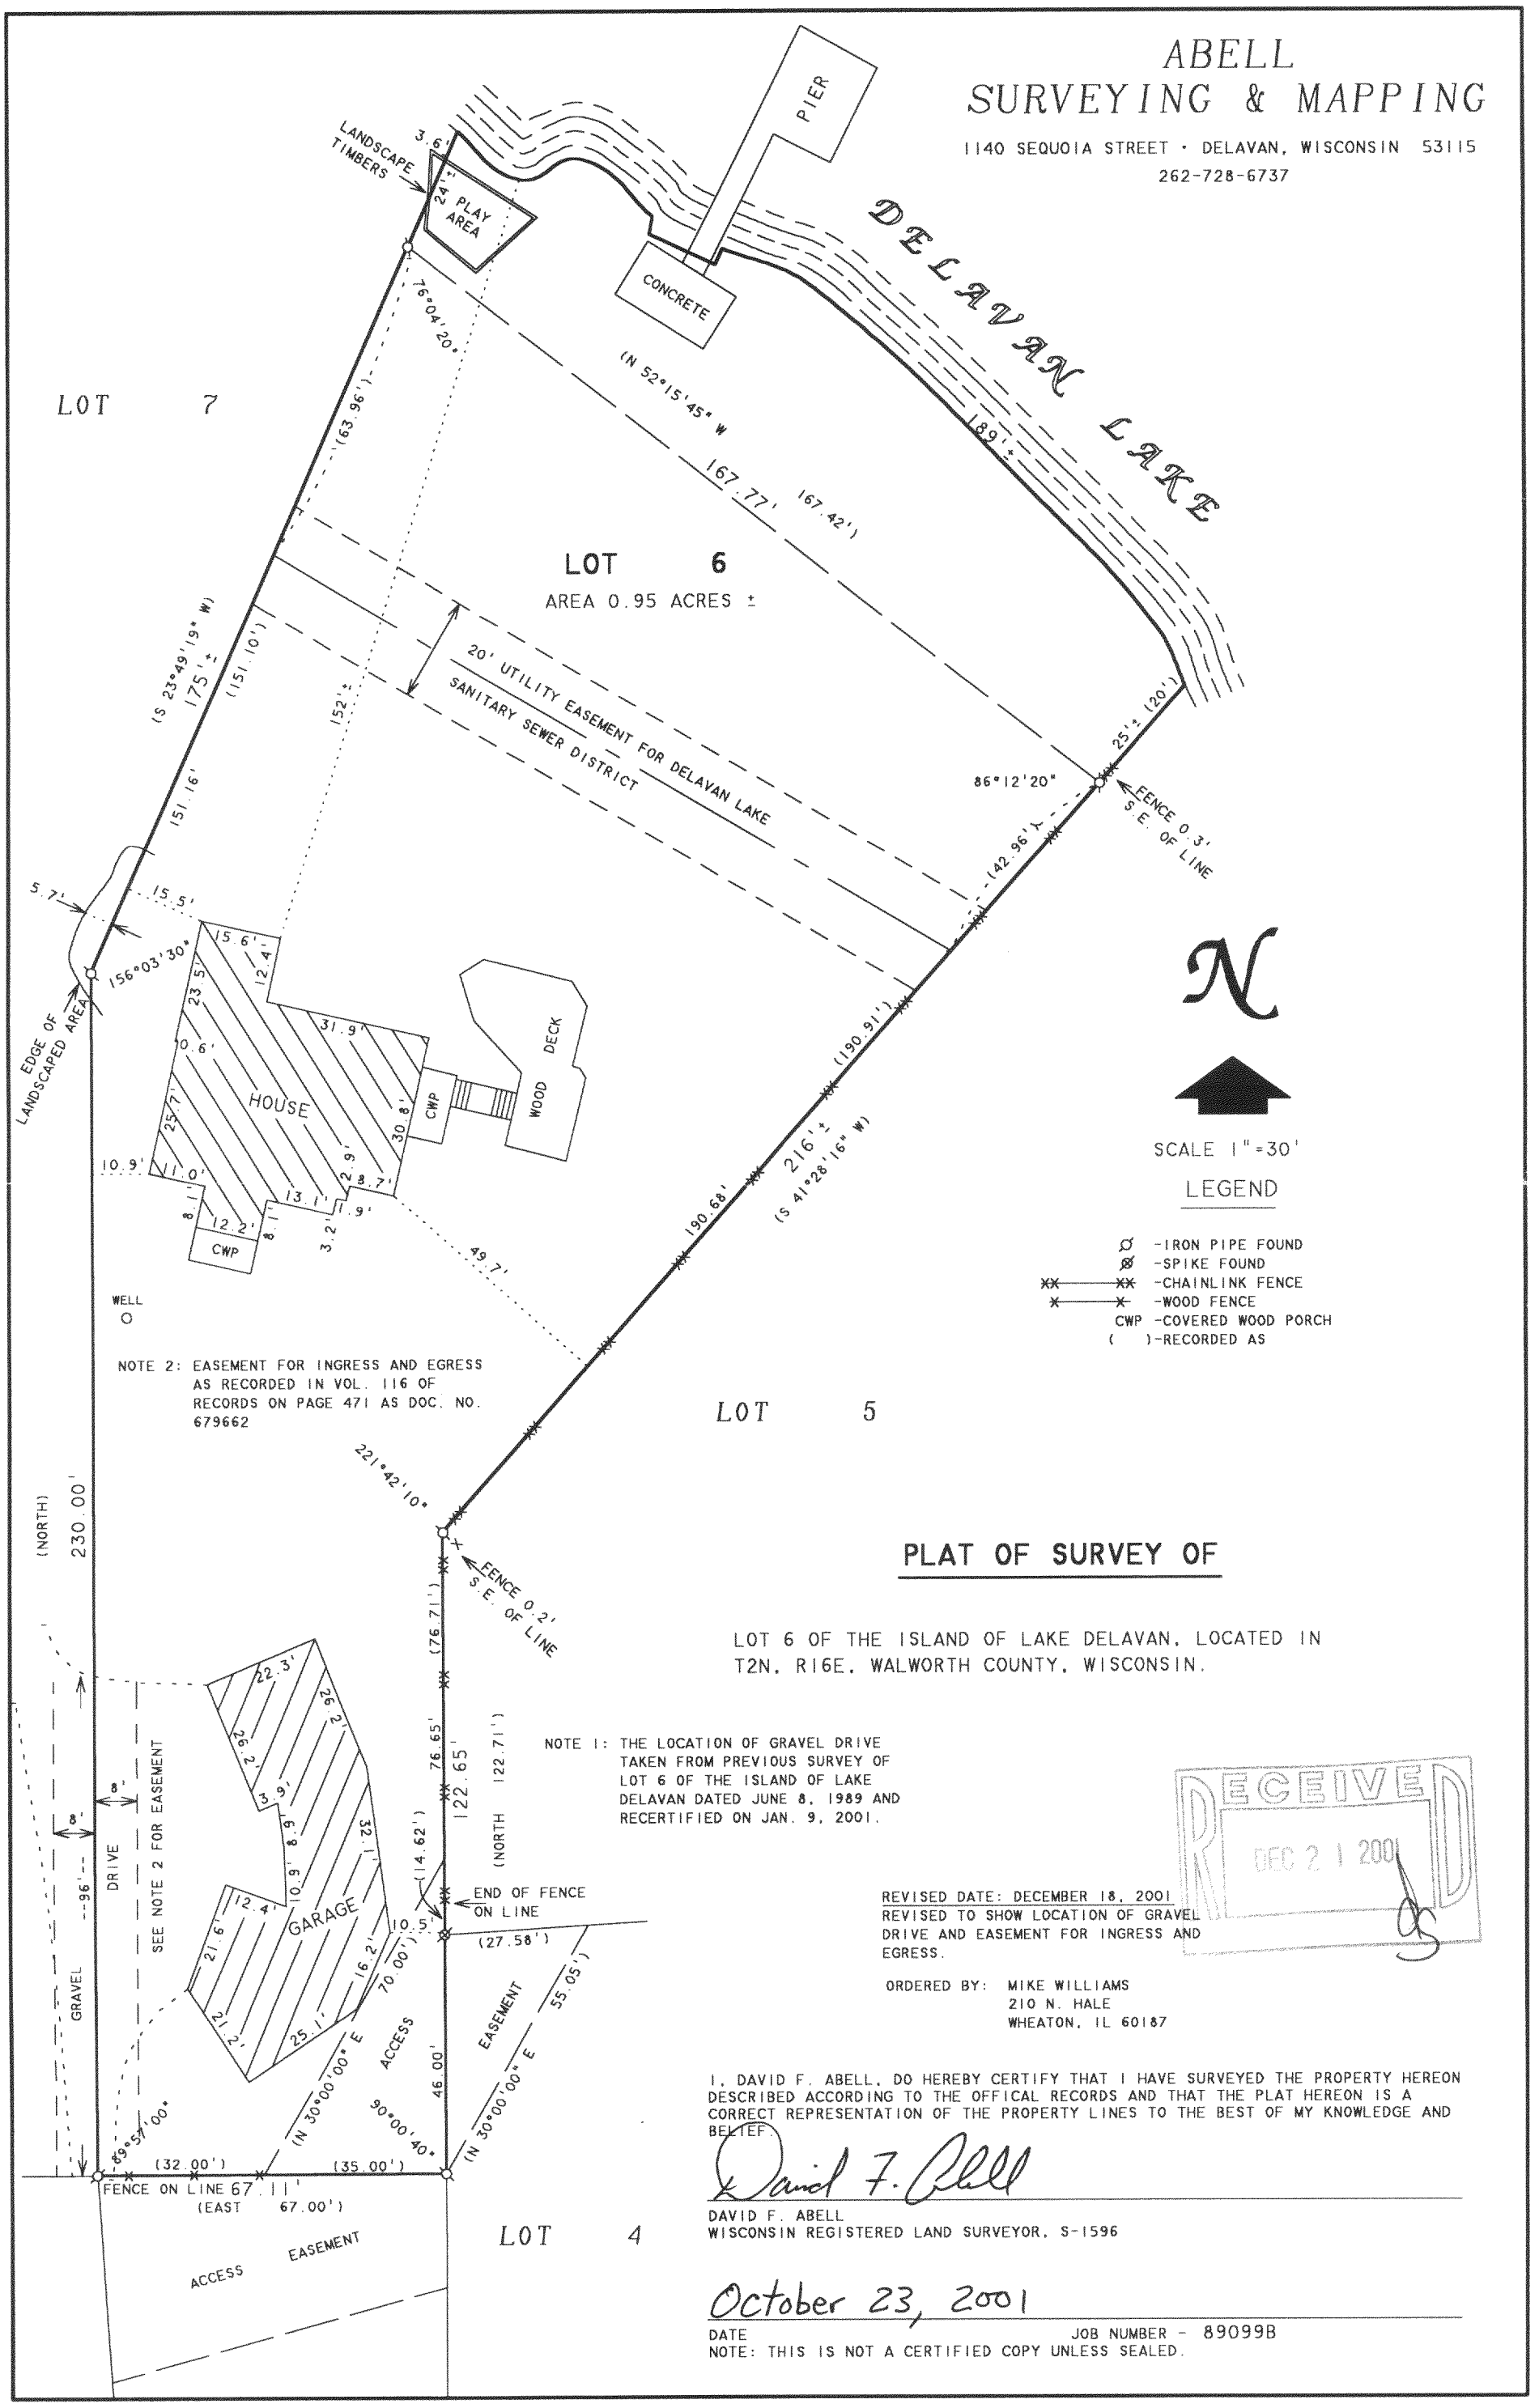

PLAT OF SURVEY OF

LOT 6 OF THE ISLAND OF LAKE DELAVAN, LOCATED IN T2N, R16E, WALWORTH COUNTY, WISCONSIN.

NOTE 1: THE LOCATION OF GRAVEL DRIVE TAKEN FROM PREVIOUS SURVEY OF LOT 6 OF THE ISLAND OF LAKE DELAVAN DATED JUNE 8, 1989 AND RECERTIFIED ON JAN. 9, 2001.

RECEIVED DEC 21 2001

REVISED DATE: DECEMBER 18, 2001
REVISED TO SHOW LOCATION OF GRAVEL DRIVE AND EASEMENT FOR INGRESS AND EGRESS.

ORDERED BY: MIKE WILLIAMS
210 N. HALE
WHEATON, IL 60187

I, DAVID F. ABELL, DO HEREBY CERTIFY THAT I HAVE SURVEYED THE PROPERTY HEREON DESCRIBED ACCORDING TO THE OFFICAL RECORDS AND THAT THE PLAT HEREON IS A CORRECT REPRESENTATION OF THE PROPERTY LINES TO THE BEST OF MY KNOWLEDGE AND BELIEF.

David F. Abell

DAVID F. ABELL
WISCONSIN REGISTERED LAND SURVEYOR, S-1596

October 23, 2001

DATE JOB NUMBER - 89099B

NOTE: THIS IS NOT A CERTIFIED COPY UNLESS SEALED.

FIS-6 216-3106