ABELL
SURVEYING & MAPPING

1140 SEQUOIA STREET • DELAVAN, WISCONSIN 53115
262-728-6737

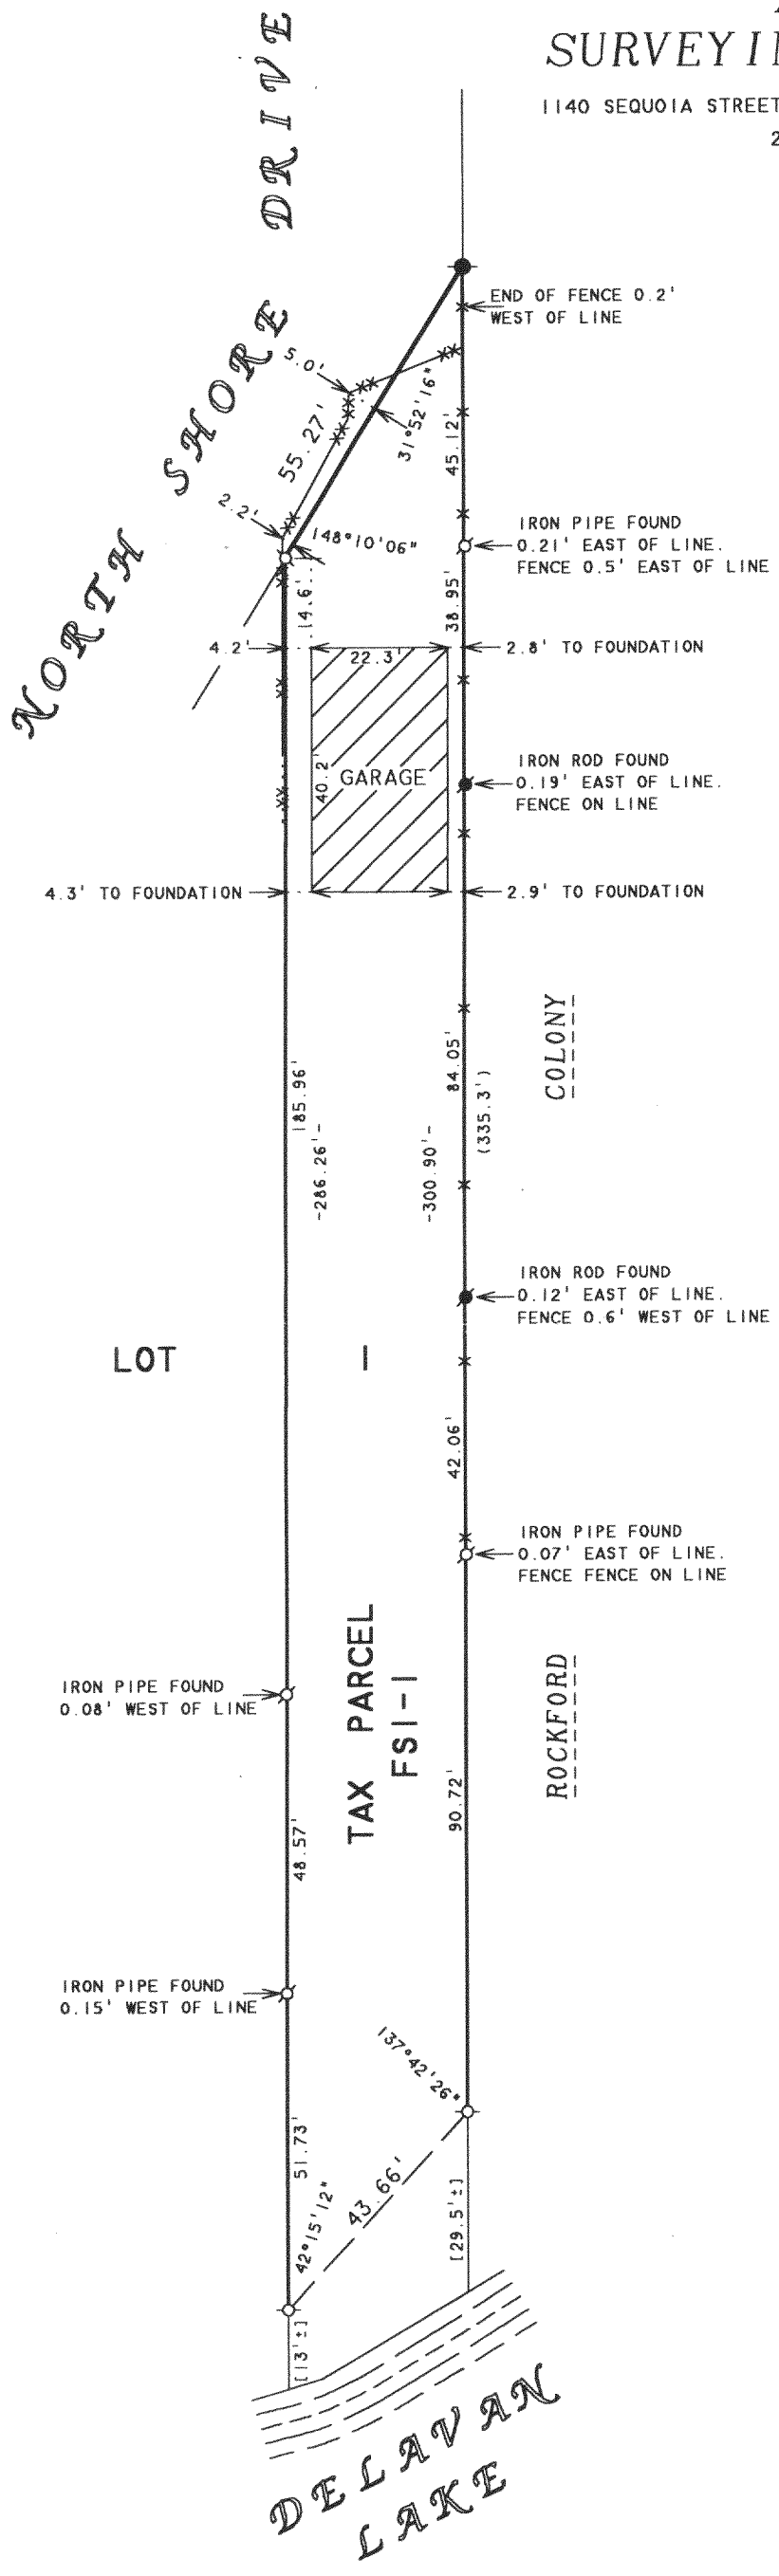

N

SCALE 1"=30'

LEGEND

- -IRON PIPE FOUND
- -IRON ROD FOUND
- -CONCRETE MONUMENT FOUND
- -WIRE FENCE
- -WOOD FENCE
- [ ]-AS SHOWN ON EXISTING SURVEY RECORDS
- ( )-RECORDED AS

NOTE: THE INTENT OF THIS SUREVY IS TO SHOW THE LOCATION OF THE GARAGE ONLY.

PLAT OF SURVEY OF

PART OF THE EAST 1/2 OF LOT 1 OF SIDON SUBDIVISION, LOCATED IN FRACTIONAL SECTION 28, T2N, R16E, WALWORTH COUNTY, WISCONSIN.

MAR 2 3 2005

I, DAVID F. ABELL, DO HEREBY CERTIFY THAT I HAVE SURVEYED THE PROPERTY HEREON DESCRIBED ACCORDING TO THE OFFICAL RECORDS AND THAT THE PLAT HEREON IS A CORRECT REPRESENTATION OF THE PROPERTY LINES TO THE BEST OF MY KNOWLEDGE AND BELIEF.

David F. Abell

DAVID F. ABELL
WISCONSIN REGISTERED LAND SURVEYOR, S-1596

ORDERED BY: DON HOLST
2504 NORTH SHORE DRIVE
DELAVAN, WI 53115

February 8, 2005
DATE

JOB NUMBER - 05007

NOTE: THIS IS NOT A CERTIFIED COPY UNLESS SEALED.

FSI 00001

2Ke-3970