PLAT OF SURVEY

LOT 22 OF SUMMIT MEADOWS SUBDIVISION

LOCATED IN PART OF ALL 1/4'S OF THE NW 1/4, SECTION 31, TOWN 2 NORTH RANGE 16 EAST, WALWORTH COUNTY, WISCONSIN

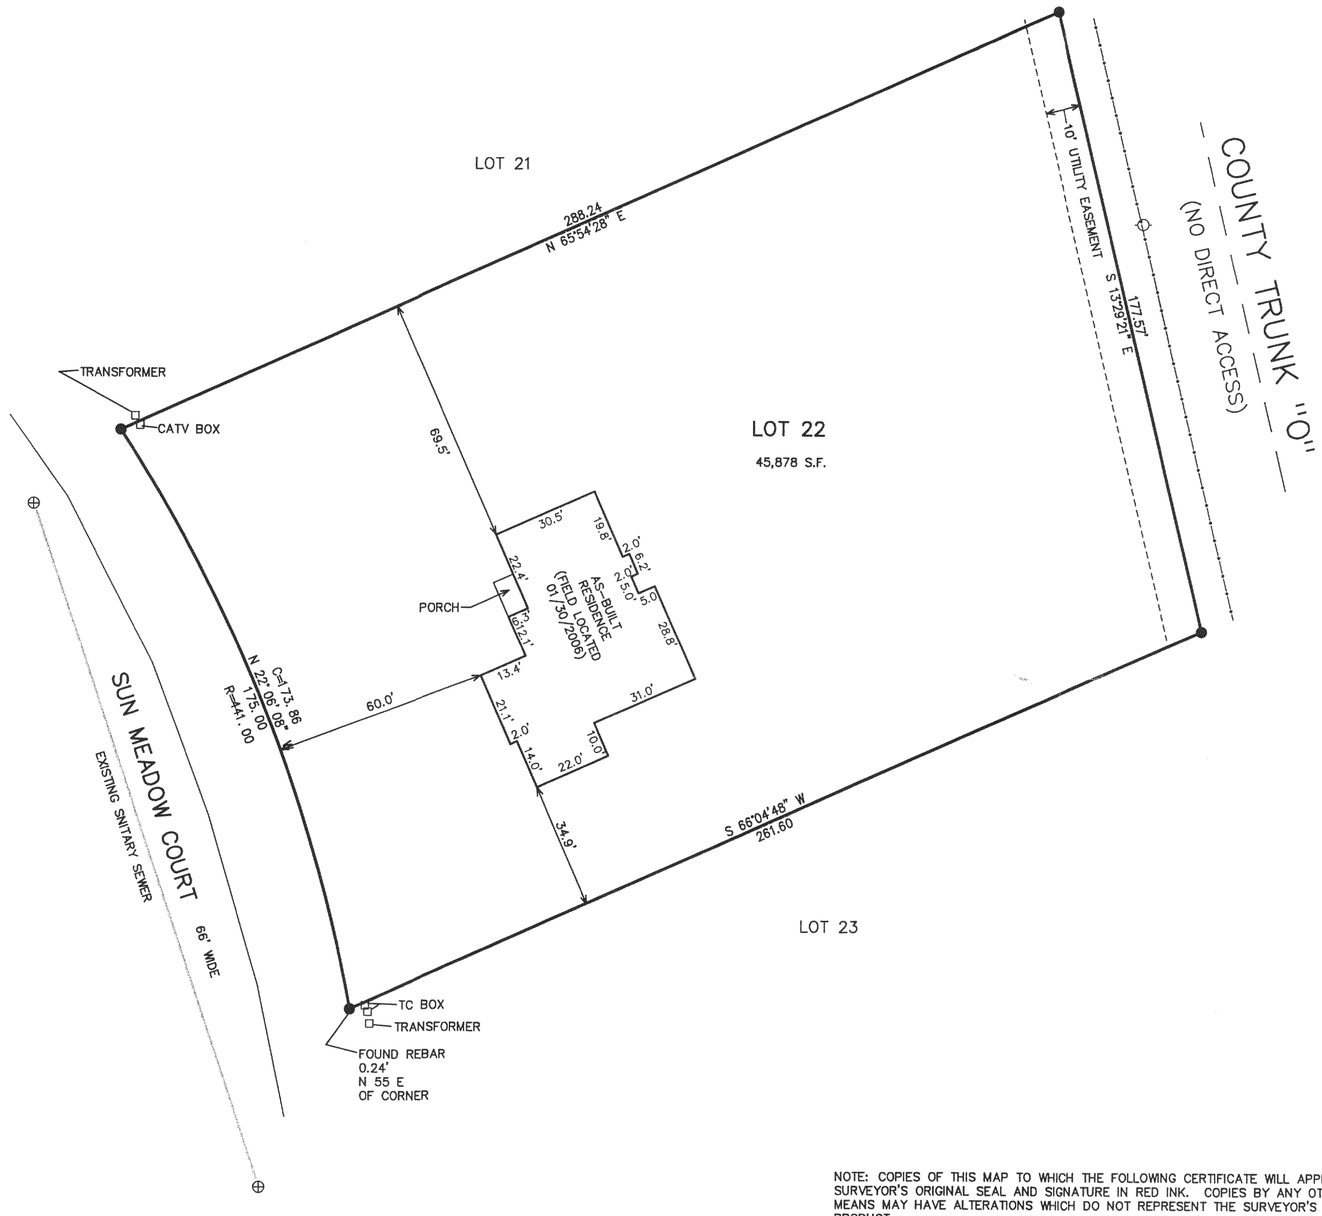

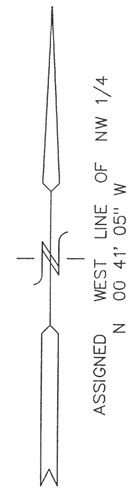

30 15 0 10 20 30 40 50 60 70 80 90 100

MAP IN SCALE FEET

SCALE: 1" = 30'

NOTE: COPIES OF THIS MAP TO WHICH THE FOLLOWING CERTIFICATE WILL APPLY SHOW SURVEYOR'S ORIGINAL SEAL AND SIGNATURE IN RED INK. COPIES BY ANY OTHER MEANS MAY HAVE ALTERATIONS WHICH DO NOT REPRESENT THE SURVEYOR'S WORK PRODUCT.

I HEREBY CERTIFY THAT THE ABOVE DESCRIBED PROPERTY HAS BEEN SURVEYED UNDER MY DIRECTION AND THAT THE ABOVE MAP IS A TRUE REPRESENTATION THEREOF AND SHOWS THE SIZE AND LOCATION OF THE PROPERTY, ITS EXTERIOR BOUNDARIES, THE LOCATION OF ALL VISIBLE STRUCTURES, AND DIMENSIONS OF ALL PRINCIPLE BUILDINGS THEREON, BOUNDARY FENCES, APPARENT EASEMENTS, ROADWAYS, AND VISIBLE ENCROACHMENTS, IF ANY. THIS SURVEY IS MADE FOR THE USE OF THE PRESENT OWNERS OF THE PROPERTY, AND ALSO THOSE WHO PURCHASE, MORTGAGE, OR GUARANTEE THE TITLE THERETO WITHIN ONE YEAR FROM THE DATE HEREOF.

DATED: JULY 5, 2005

PETER S. GORDON R.L.S. 2101

REVISED 10-11-2005
TO SHOW SIZE & LOCATION OF PROPOSED RESIDENCE

REVISED 01-31-2006
TO SHOW SIZE & LOCATION OF AS-BUILT RESIDENCE

LEGEND

● = FOUND IRON REBAR STAKE

RECEIVED
FEB 24

PLAT OF SURVEY

WORK ORDERED BY:
CRAIG & JULIE LODAHL
PO BOX 249
DELAVAN, WI. 53115

FARRIS, HANSEN & ASSOCIATES, INC.
Engineering, Architecture, Surveying
7 Ridgway Court P.O. Box 437
ELKHORN, WISCONSIN 53121
Office: (414) 723-2098
Fax: (414) 723-5886

REVISIONS

PROJECT NO. 3477-22
DATE: 07-05-05
SHEET NO. 1 OF 1

FSM-22

216-4167