



PLAT OF SURVEY

LOT 1 CSM 1930
LOCATED IN THE SW 1/4 SECTION 23
TOWN 2 NORTH, RANGE 16 EAST
WALWORTH COUNTY, WISCONSIN


Lot 1 of Certified Survey Map No. 1930 recorded in Volume 9 of Certified Survey Maps on page 145 as Document No. 192770 on April 17, 1990; specifically excepting from the conveyance herein the Real Estate "Dedicated to the public as shown and depicted on Lot 1 of Certified Survey Map No. 1930, being the South 27.09 feet of Lot 1 of Certified Survey Map No. 1930. Said land being in the Town of Delavan, County of Walworth, State of Wisconsin.
FOR INFORMATIONAL PURPOSES ONLY:
Property Address: 5560 State Road 50, Delavan, WI 53115
Tax Key Number: FA193000001

WORK ORDERED BY:
TONY COLETTI
101 EVERGREEN PARKWAY
ELKHORN, WI. 53121

FARRIS, HANSEN & ASSOCIATES, INC.
ENGINEERING - ARCHITECTURE - SURVEYING
7 RIDGWAY COURT P.O. BOX 437
ELKHORN, WISCONSIN 53121
OFFICE: (262) 723-2098 FAX: (262) 723-5886

REVISIONS

PROJECT NO.
8597
DATE:
06-19-2012
SHEET NO.
1 OF 1

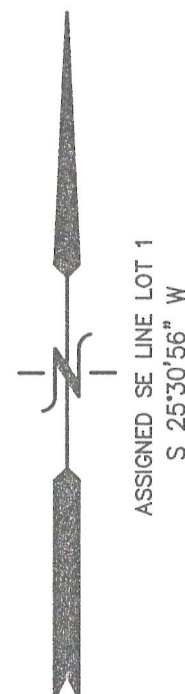

100 90 80 70 60 50 40 30 20 10 0 50 100
MAP SCALE IN FEET ORIGINAL 1" = 40'

NOTE: FOUND HOLE IN PAVEMENT 1.5" DIA. METAL DETECTED INSIDE HOLE; SHOT HOLE LOCATION AS SHOWN WHICH AGREES WITHIN 0.13' OF RECORD PIPE POSITION.

LOT 4 LAKE PRAIRIE SUBDIVISION

STATE TRUNK HIGHWAY "50"

SANITARY MANHOLE

(S 59°39'30" E 200.00')
200.17'
S 59°38'35" E
192.26'

10' UTIL EASE-
20' SAN. SEWER EASE-
EXISTING SAN. SEWER LINE

(N 25°30'56" E 454.61')
N 25°29'19" E
454.48'

BRICK WALK
FENCED DUMPSTER AREA
FENCE 2' NW
OF LINE

PAVEMENT

PAVEMENT

CONCRETE ENTRY





































UTIL METERS

AC UNIT

CONCRETE ENTRY



































GAS METER

EXISTING HOTEL

EXISTING HOTEL

CANOPY ENTRY

EXISTING PAVED PARKING

EXISTING PAVED PARKING

NO ACCESS

EXISTING PAVED PARKING

EXISTING PAVED PARKING

LIGHT POST












































































