


THE OAKS OF DELAVAN LAKE, A SUBDIVISION  
LOT 12 OF THE OAKS OF DELAVAN LAKE, A SUBDIVISION

A REDIVISION OF LOTS 2, 3, AND 4 OF CERTIFIED SURVEY MAP NO. 1907  
LOCATED IN PART OF THE SOUTHEAST 1/4 OF THE SOUTHWEST 1/4 OF SECTION 21,  
TOWN 2 NORTH, RANGE 16 EAST, TOWN OF DELAVAN, WALWORTH COUNTY, WISCONSIN

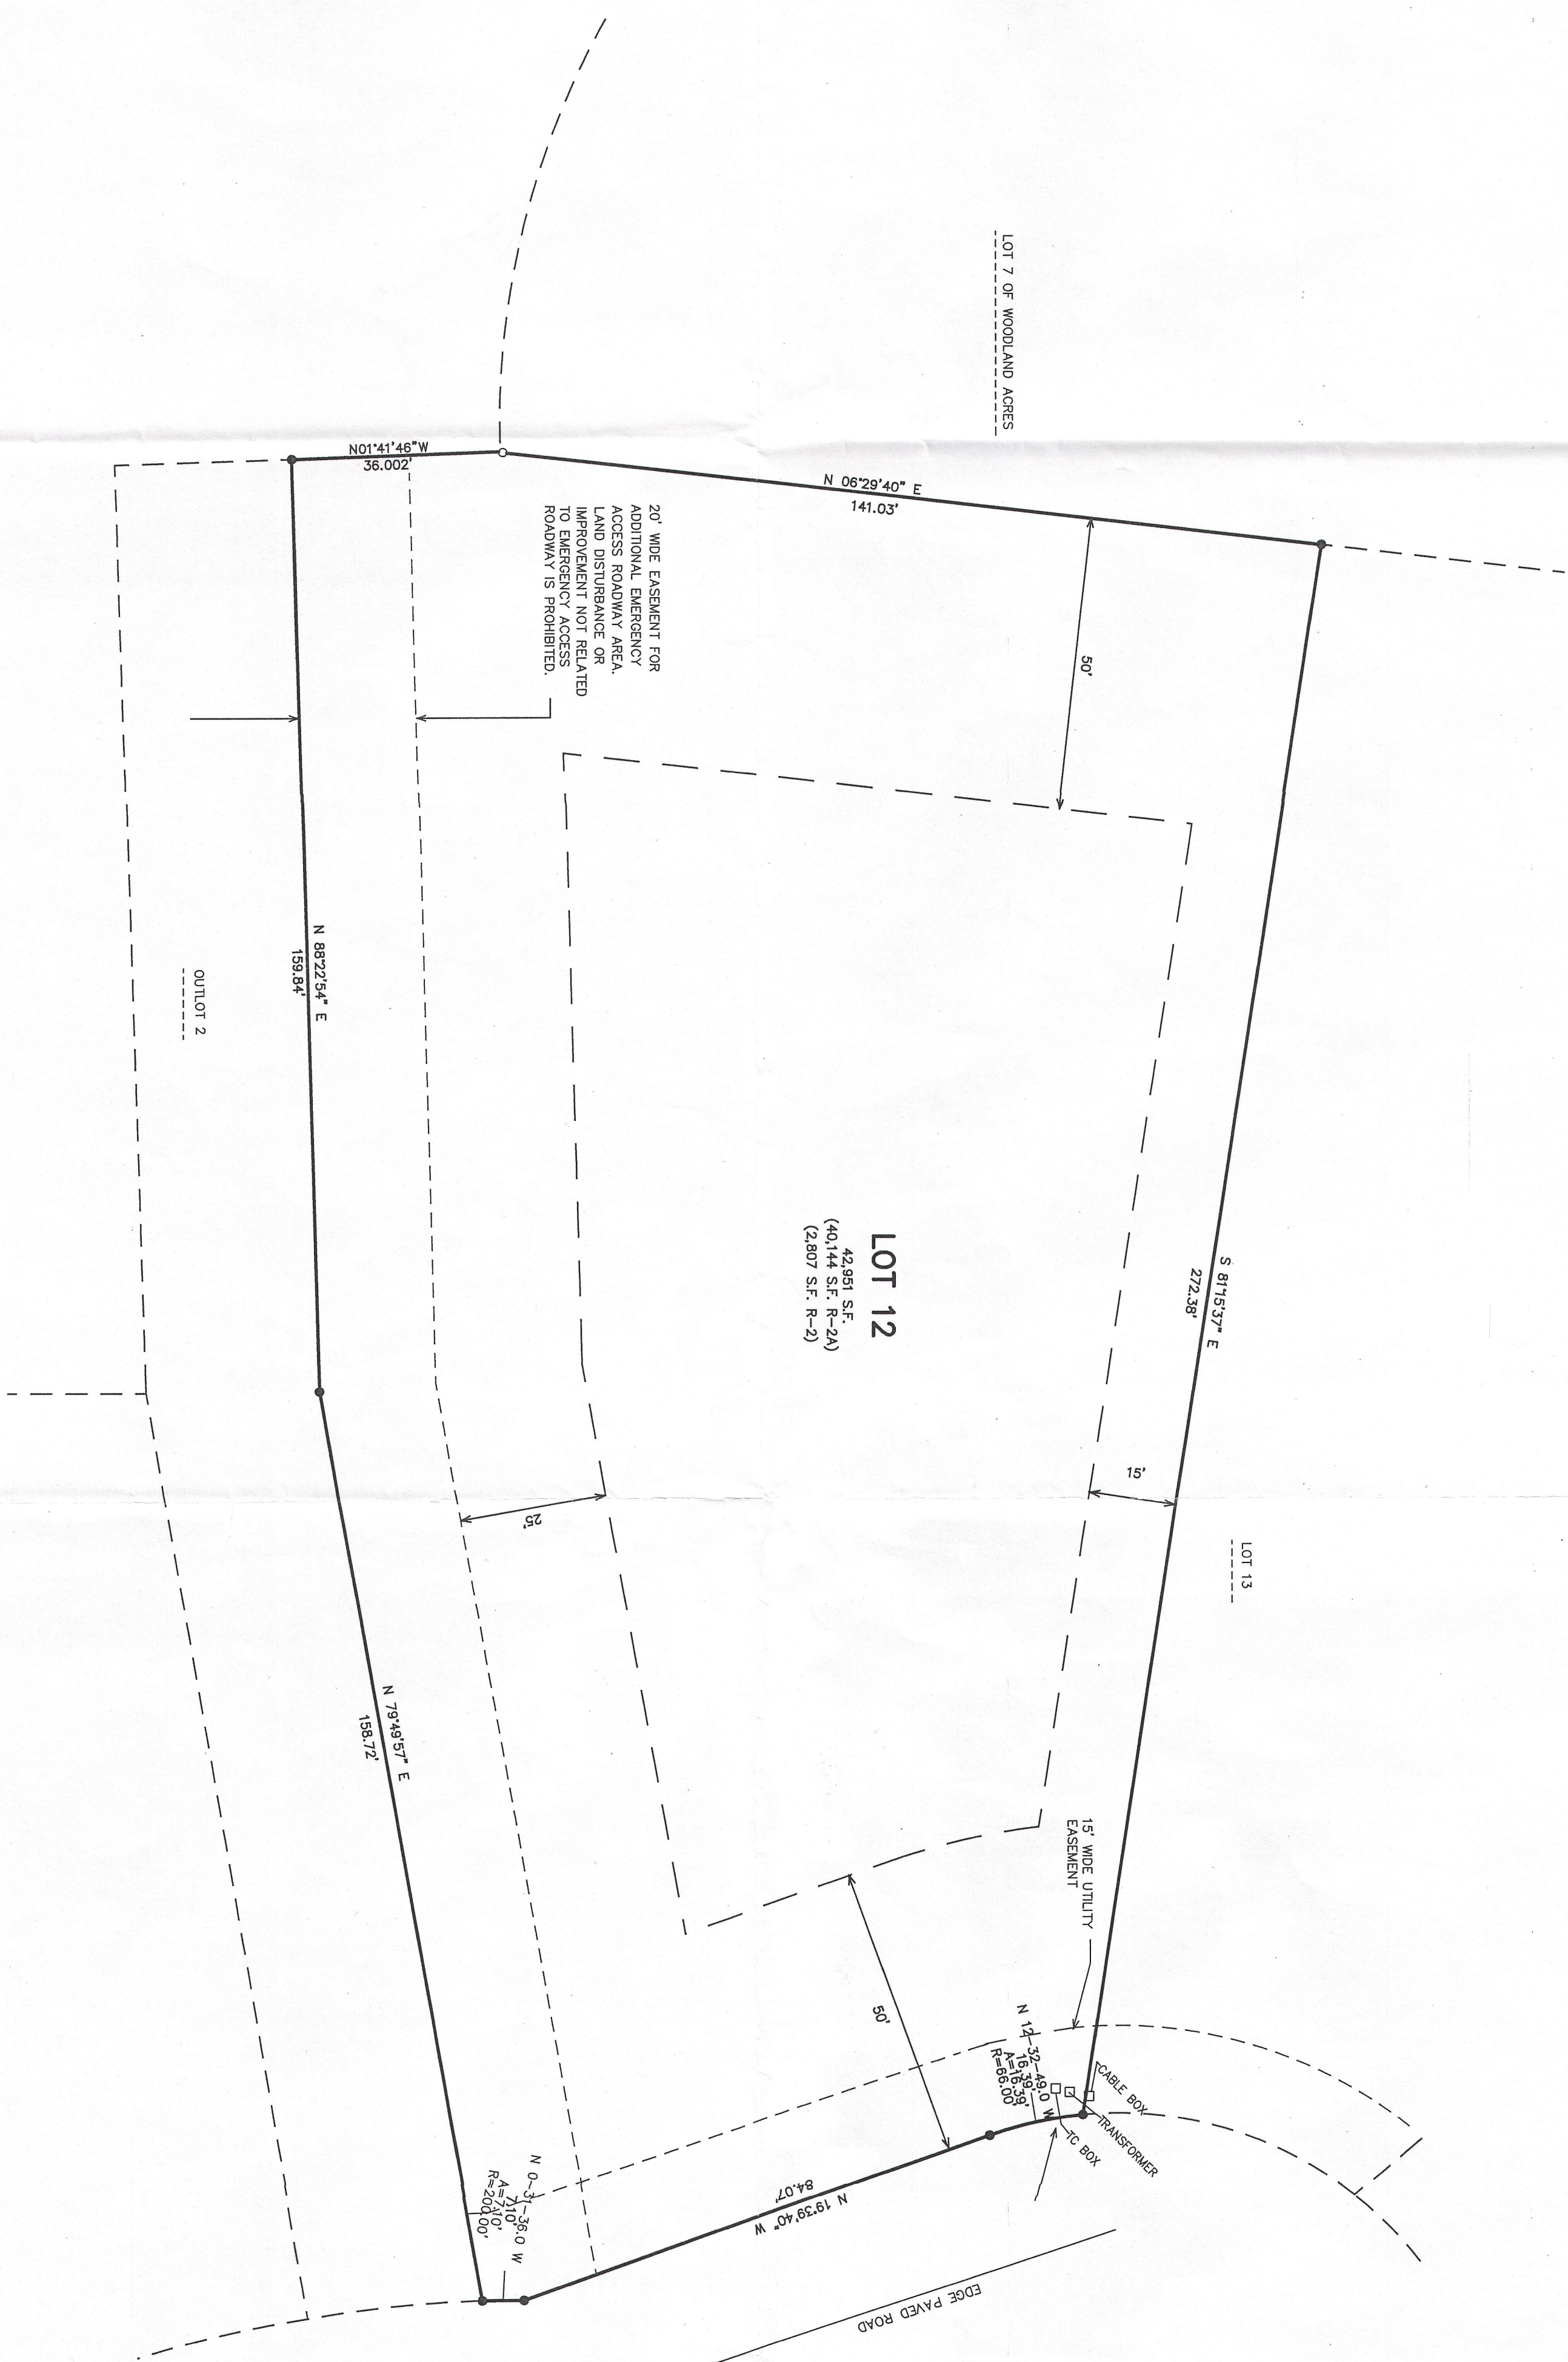




OAK VALLEY CIRCLE

NOTE:  
ROW GRANT RECORDED IN VOL. 618 OF DEEDS, PAGE 141, DOC. 569398B  
DOES NOT AFFECT THE SUBJECT LOT.  
THIS ONLY AFFECTS THE NORTH 40 FEET OF LINN ROAD TO ALLOW  
UNDERGROUND CABLES.

LEGEND

- = FOUND IRON PIPE STAKE, 1 3/8" O.D.
- = FOUND IRON REBAR STAKE, 3/4" DIA.

(XXX) = RECORDED AS ON ORIGINAL SUBDIVISION PLAT

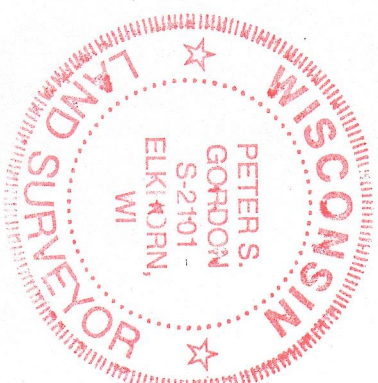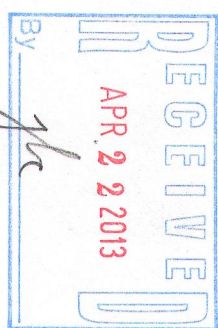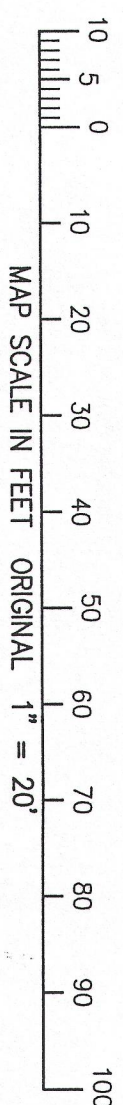




DATED: MAY 30, 2006

RESURVEYED: 04-11-2013

WALTER S. GORDON

DATED: MAY 30, 2008 RESURVEYED 04-11-2013


RESURVEYED 04-11-2013

PETER S. GORDON

**FARRIS, HANSEN & ASSOCIATES, INC.**  
ENGINEERING — ARCHITECTURE — SURVEYING  
7 RIDGWAY COURT P.O. BOX 437  
ELKHORN, WISCONSIN 53121  
OFFICE: (262) 723-2098 FAX: (262) 723-5886

— WORK ORDERED BY —  
KURT KEIKHAFFER  
KEIKHAFFER BROS., LLC  
2466 LLEFEBER AVENUE  
WAUWATOSA, WI 53213

PLAT OF SURVEY  
LOT 12 OF THE OAKS OF DELAVAN LAKE,  
A SUBDIVISION  
TOWN OF DELAVAN, WALWORTH COUNTY, WISCONSIN

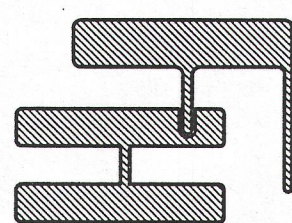

PROJECT NO.	7147.12
DATE	05/30/2008
SHEET NO.	1 OF 1