Plat of Survey

of

Lot 4 in Block Q of Delavan Lake Assembly Grounds,

a subdivision located in the Southeast 1/4 of Section 21, Town 2 North, Range 16 East, Town of Delavan, Walworth County, Wisconsin.

Surveyed for: **Nadine Bahaveolos**
9 S 161 Kearney Road
Downers Grove, Illinois. 60516

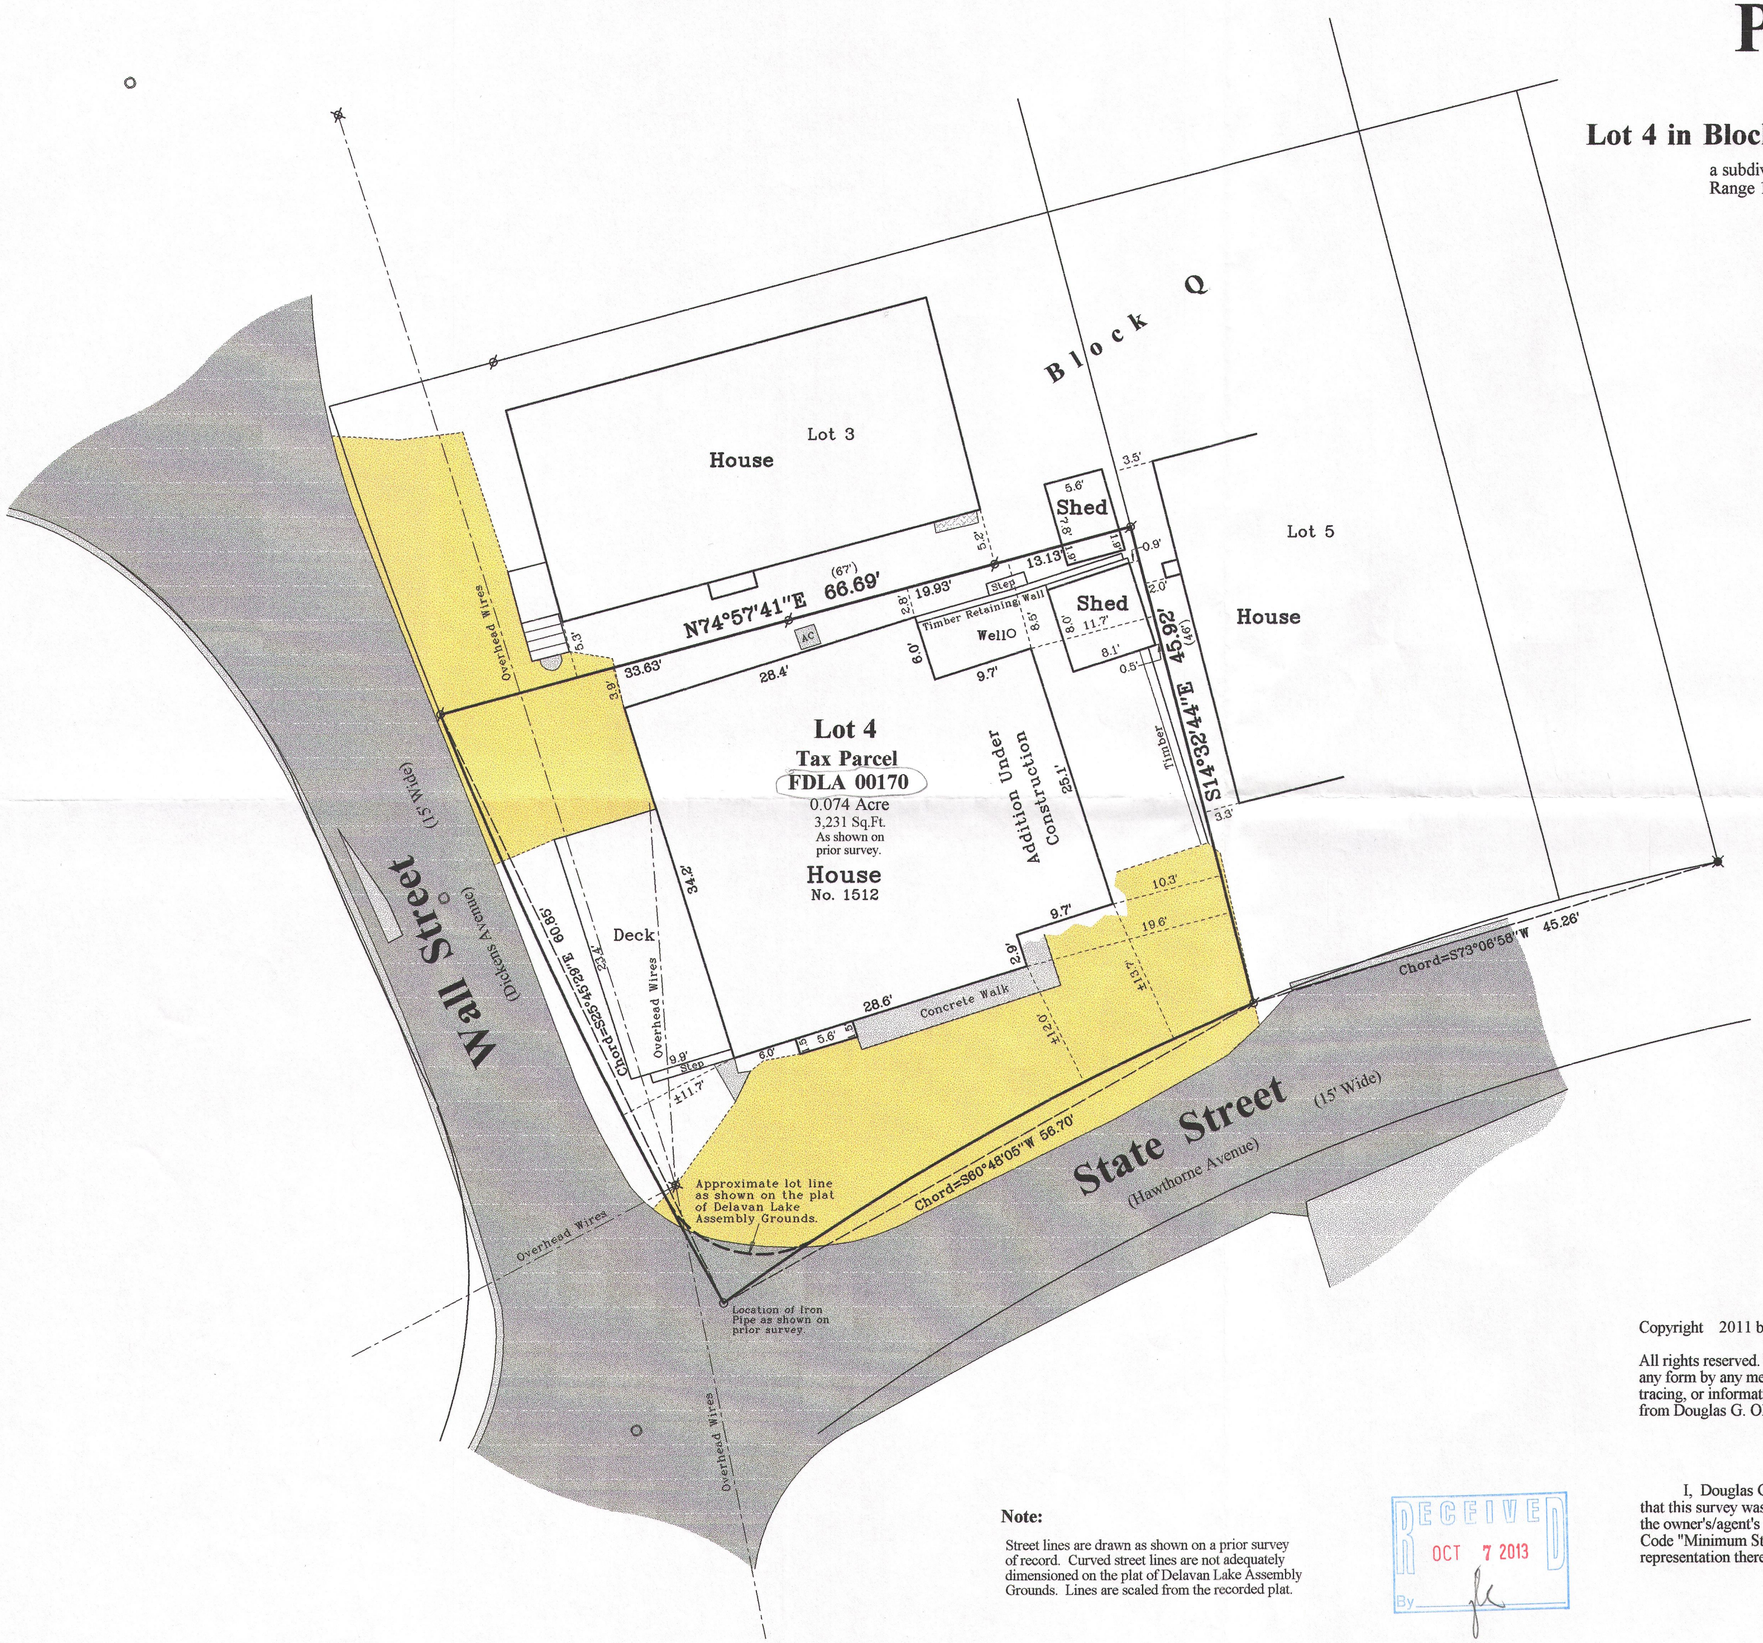

Bearings reference to the Wisconsin State Plane Coordinate System, South Zone.

WISCONSIN
DOUGLAS OLSON
S-2093
ELKHORN, WI
LAND SURVEYOR

Not Certified Unless Stamped in Red.

Notes:

1) This survey plat is not certified unless signed and sealed in red ink.

2) This survey is subject to Wisconsin lien laws. This Plat of Survey is the notice of intent to file lien. Lien waiver required.

Note:

Street lines are drawn as shown on a prior survey of record. Curved street lines are not adequately dimensioned on the plat of Delavan Lake Assembly Grounds. Lines are scaled from the recorded plat.

RECEIVED
OCT 7 2013
By jk

Copyright 2011 by Jensen & Olson Land Surveying, LLC.

All rights reserved. No part of this survey plat may be reproduced or transmitted in any form by any means - graphic, electronic, or mechanical, including photocopying, tracing, or information storage and retrieval systems - without permission in writing from Douglas G. Olson, Jensen & Olson Land Surveying, LLC.

I, Douglas G. Olson, Wisconsin Registered Land Surveyor, do hereby certify that this survey was performed by me, or under my direction in full compliance with the owner's/agent's instructions and Chapter A-E 7 of the Wisconsin Administrative Code "Minimum Standards for Property Surveys"; and that this map is an accurate representation thereof to the best of my knowledge and belief.

Douglas G. Olson
Wisconsin Registered Land Surveyor - 2093

Survey Date: August 31, 2011.
Revisions: No. 1 – Proposed House Addition
No. 2 – Addition under construction

Scale in Feet
1" = 10'
0' 5' 10' 20'

Jensen & Olson Land Surveying, LLC
45 South Wisconsin Street * P.O. Box 322 * Elkhorn, Wisconsin. 53121
Telephone: (262) 723-3434 * Facsimile: (262) 723-8044
Email: jensen.olson@elknet.net

Legend
- Found Iron Pipe
- Found Spike
- Set Spindle
- ( ) Recorded Information
- Utility Pole
- Asphalt Surface
- Concrete Surface
- Gravel Surface
- Pavers

Sheet 1 of 1 Sheets

Drawing Name: Charles-20130816-20130910(Plat.sc)

Job Reference Number
2013.016

2013.016

216-5045