


PREPARED FOR
CORNELIA SAWLE
2329 S. LAKESHORE DRIVE
DELANAV WI. 53115

PLAT OF SURVEY

-OF-


THE SOUTH 1/2 OF THE FOLLOWING DESCRIBED PREMISES : LOT 9 OF HARINGTON
SUBDIVISION, LOCATED IN THE SOUTHEAST 1/4 OF THE NORTHWEST 1/4 OF SECTION 27,
TOWN 2 NORTH, RANGE 16 EAST, WALWORTH COUNTY, WISCONSIN.

LYNCH & ASSOCIATES
ENGINEERING CONSULTANTS, LLC.
5482 S. WESTRIDGE DR.
NEW BERLIN, WI 53151
(262) 248-3697

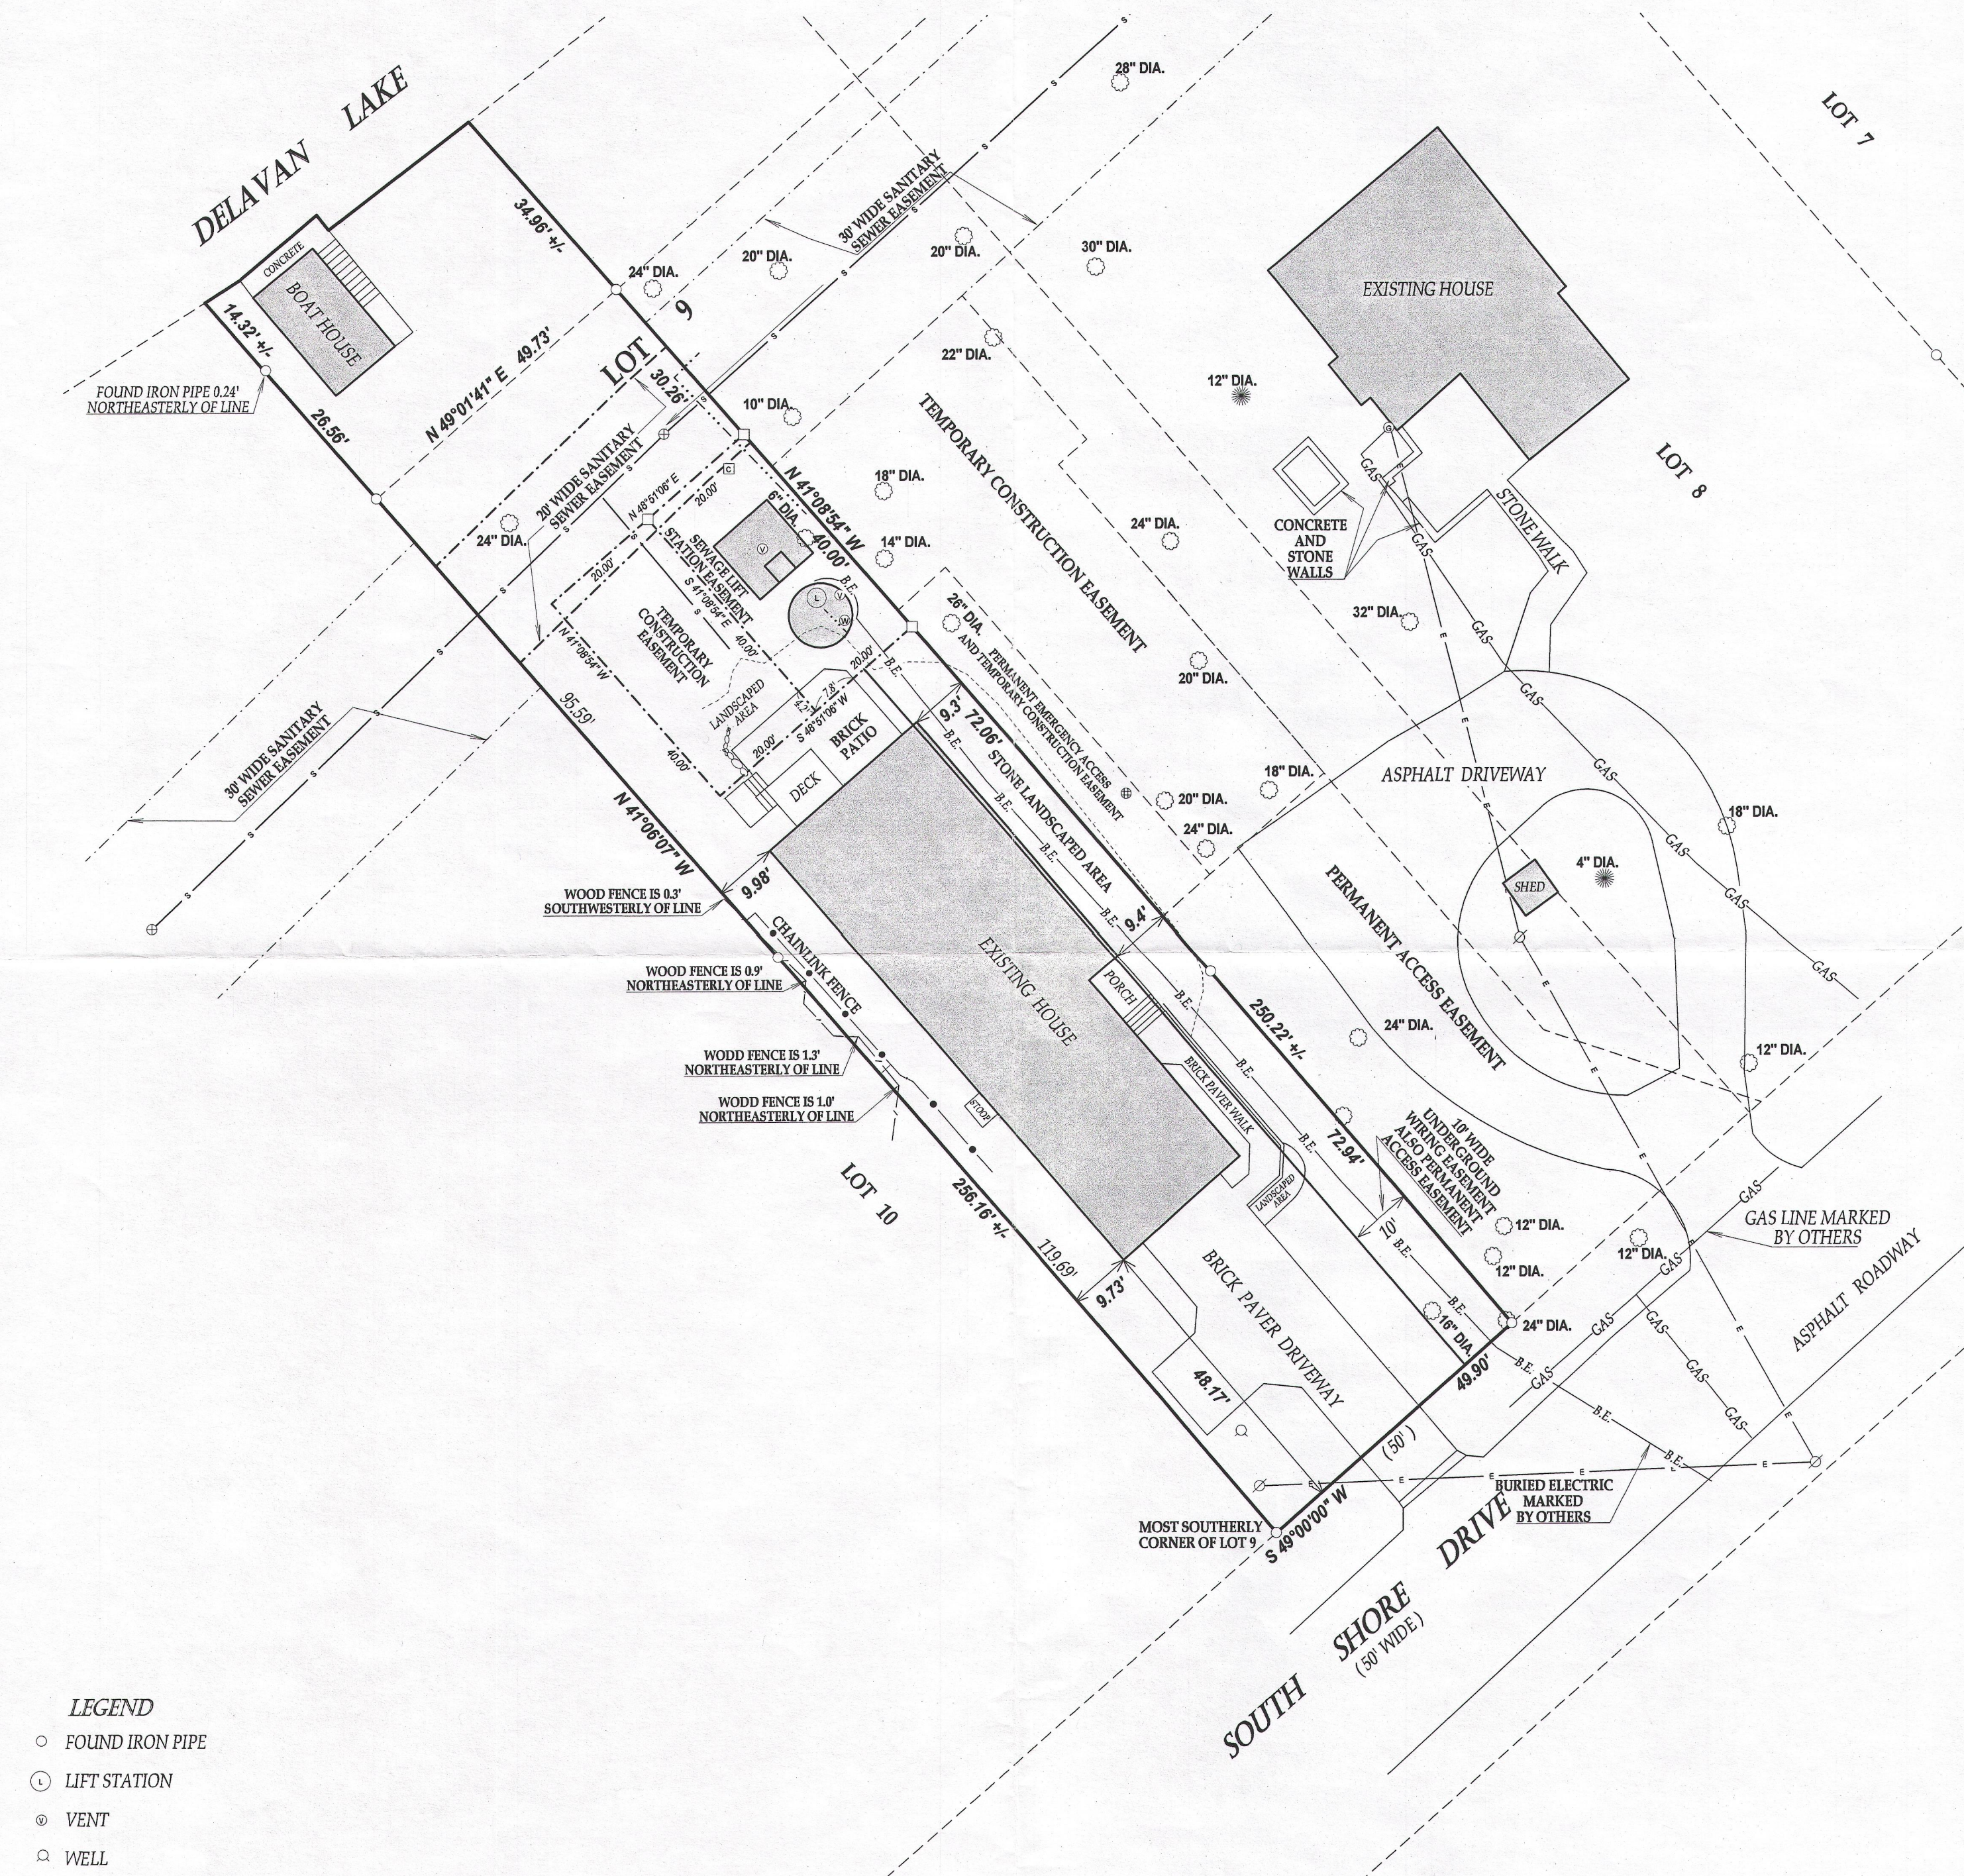

LEGEND

- FOUND IRON PIPE
- ⊙ LIFT STATION
- ⊙ VENT
- ⊙ WELL
- ⊙ WATER VALVE
- ⊕ MANHOLE
- ⊙ UTILITY POLE
- OVERHEAD WIRES
- DECIDUOUS TREE
- CONIFER TREE
- ⊠ CONTROL VALVE (SPRINKLER SYSTEM)
- ⊕ YARD BASIN
- (XX) RECORDED AS


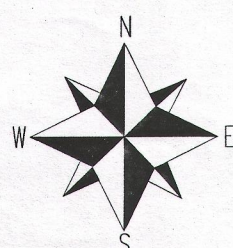


SCALE 1"=20'
BEARINGS REFERENCED TO THE RECORD PLAT

TAX ID # FHA00013
JOB # 14-512

FHA-13

216-5143

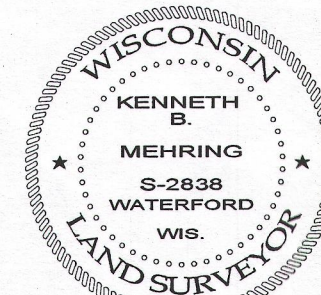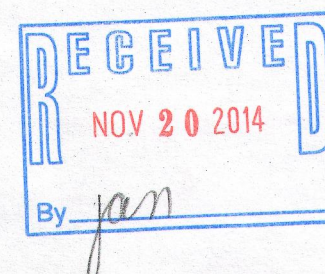

DATED THIS 25th DAY OF MARCH 2014

KENNETH B. MEHRING S - 2838
Wisconsin Registered Land Surveyor
(original if signed in red)

I have surveyed the above-described property and the above map is a true representation thereof and shows the size and location of the property, its exterior boundaries, the location and dimensions of all structures thereon, fences apparent easements and roadways and visible encroachments, if any.

This survey is made for the exclusive use of the present owners of the property, and also those who purchase, mortgage, or insure the title thereto within one (1) year from date hereof; and as to them I warrant the accuracy of said survey map.