


PREPARED FOR
BOB LONG
636 YARDLEY LN.
HOFFMAN ESTATES, IL 60169

PLAT OF SURVEY

-OF-

LOT 12, BLOCK 1 INLET OAKS SUBDIVISION, LOCATED IN TOWN 2 NORTH,
RANGE 16 EAST, TOWN OF DELAVAN, WALWORTH COUNTY, WISCONSIN.

LYNCH & ASSOCIATES
ENGINEERING CONSULTANTS, LLC.
5482 S. WESTRIDGE DR.
NEW BERLIN, WI 53151
(262) 248-3697

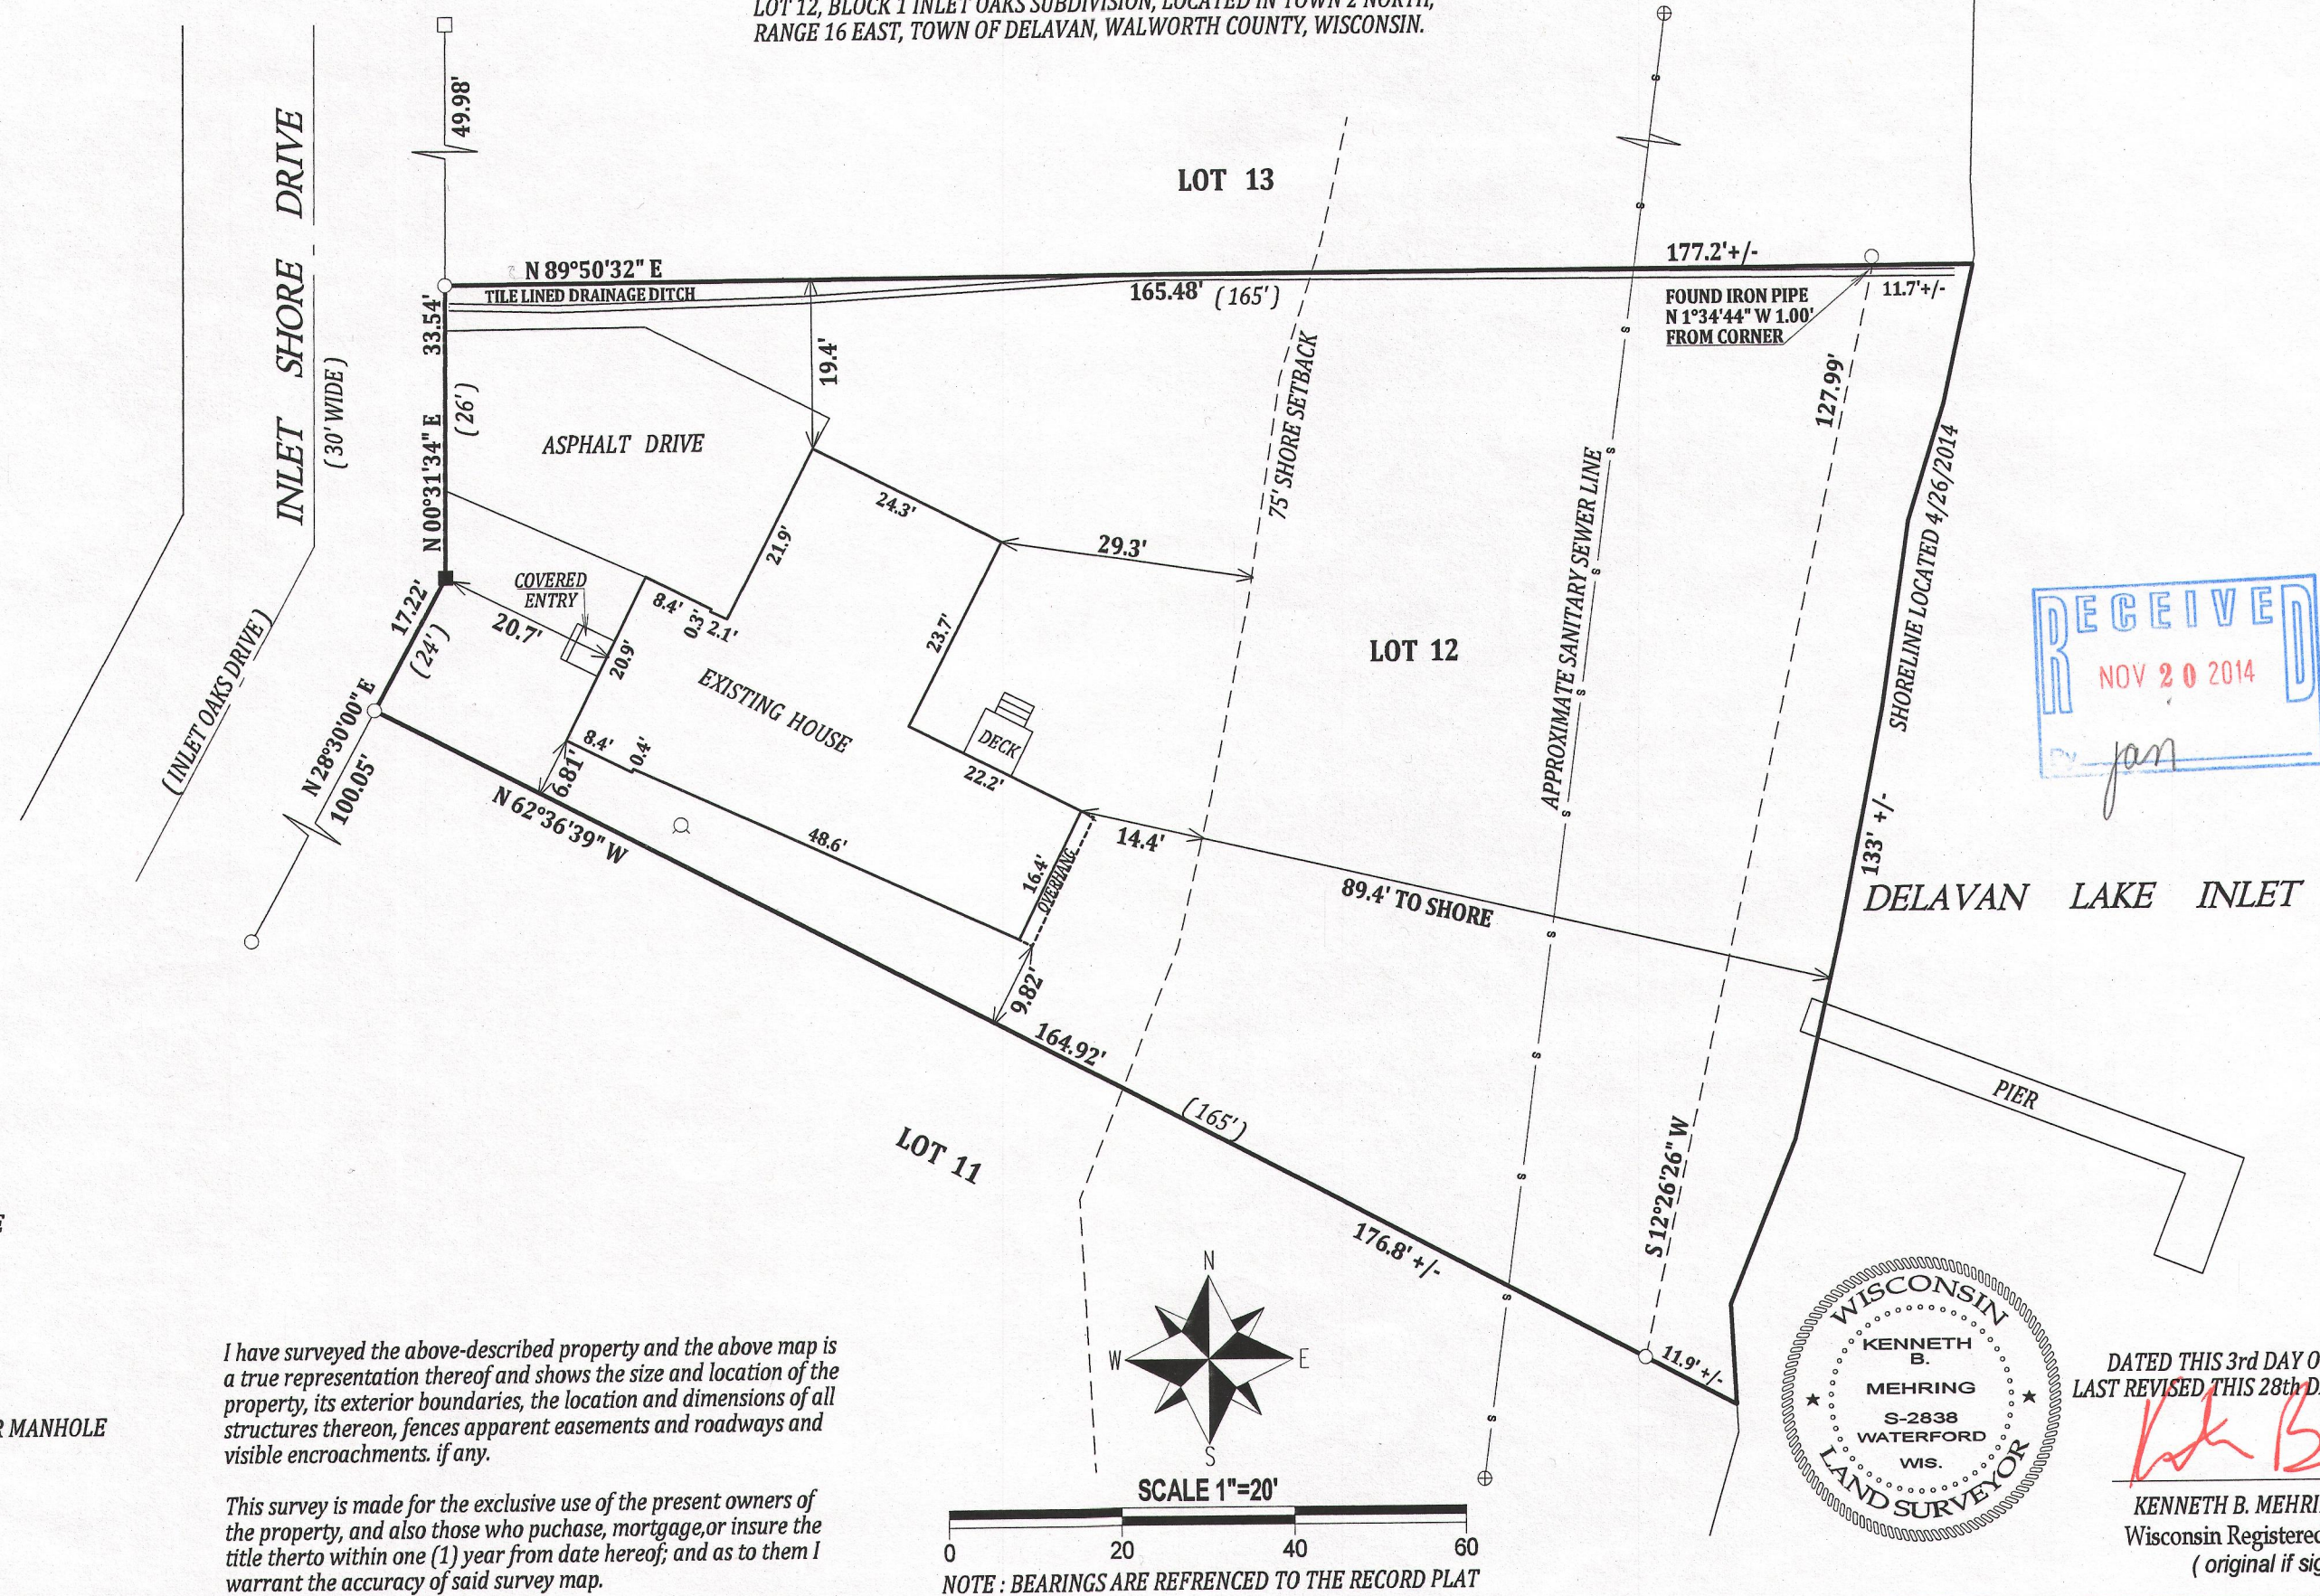

FIN-6

216-5144