Plat of Survey

of

Lot 76 of Lake Delavan Highlands,

a subdivision located in the Southwest 1/4 of the Southeast 1/4 of Section 31,
Town 2 North, Range 16 East, Town of Delavan, Walworth County, Wisconsin.

Surveyed for: **Dave & Andrea Kelly**
4229 Central Boulevard
Delavan, Wisconsin. 53115

Bearings referenced to the West line of Central Boulevard, recorded as N0°13'40"E on the plat of Lake Delavan Highlands.

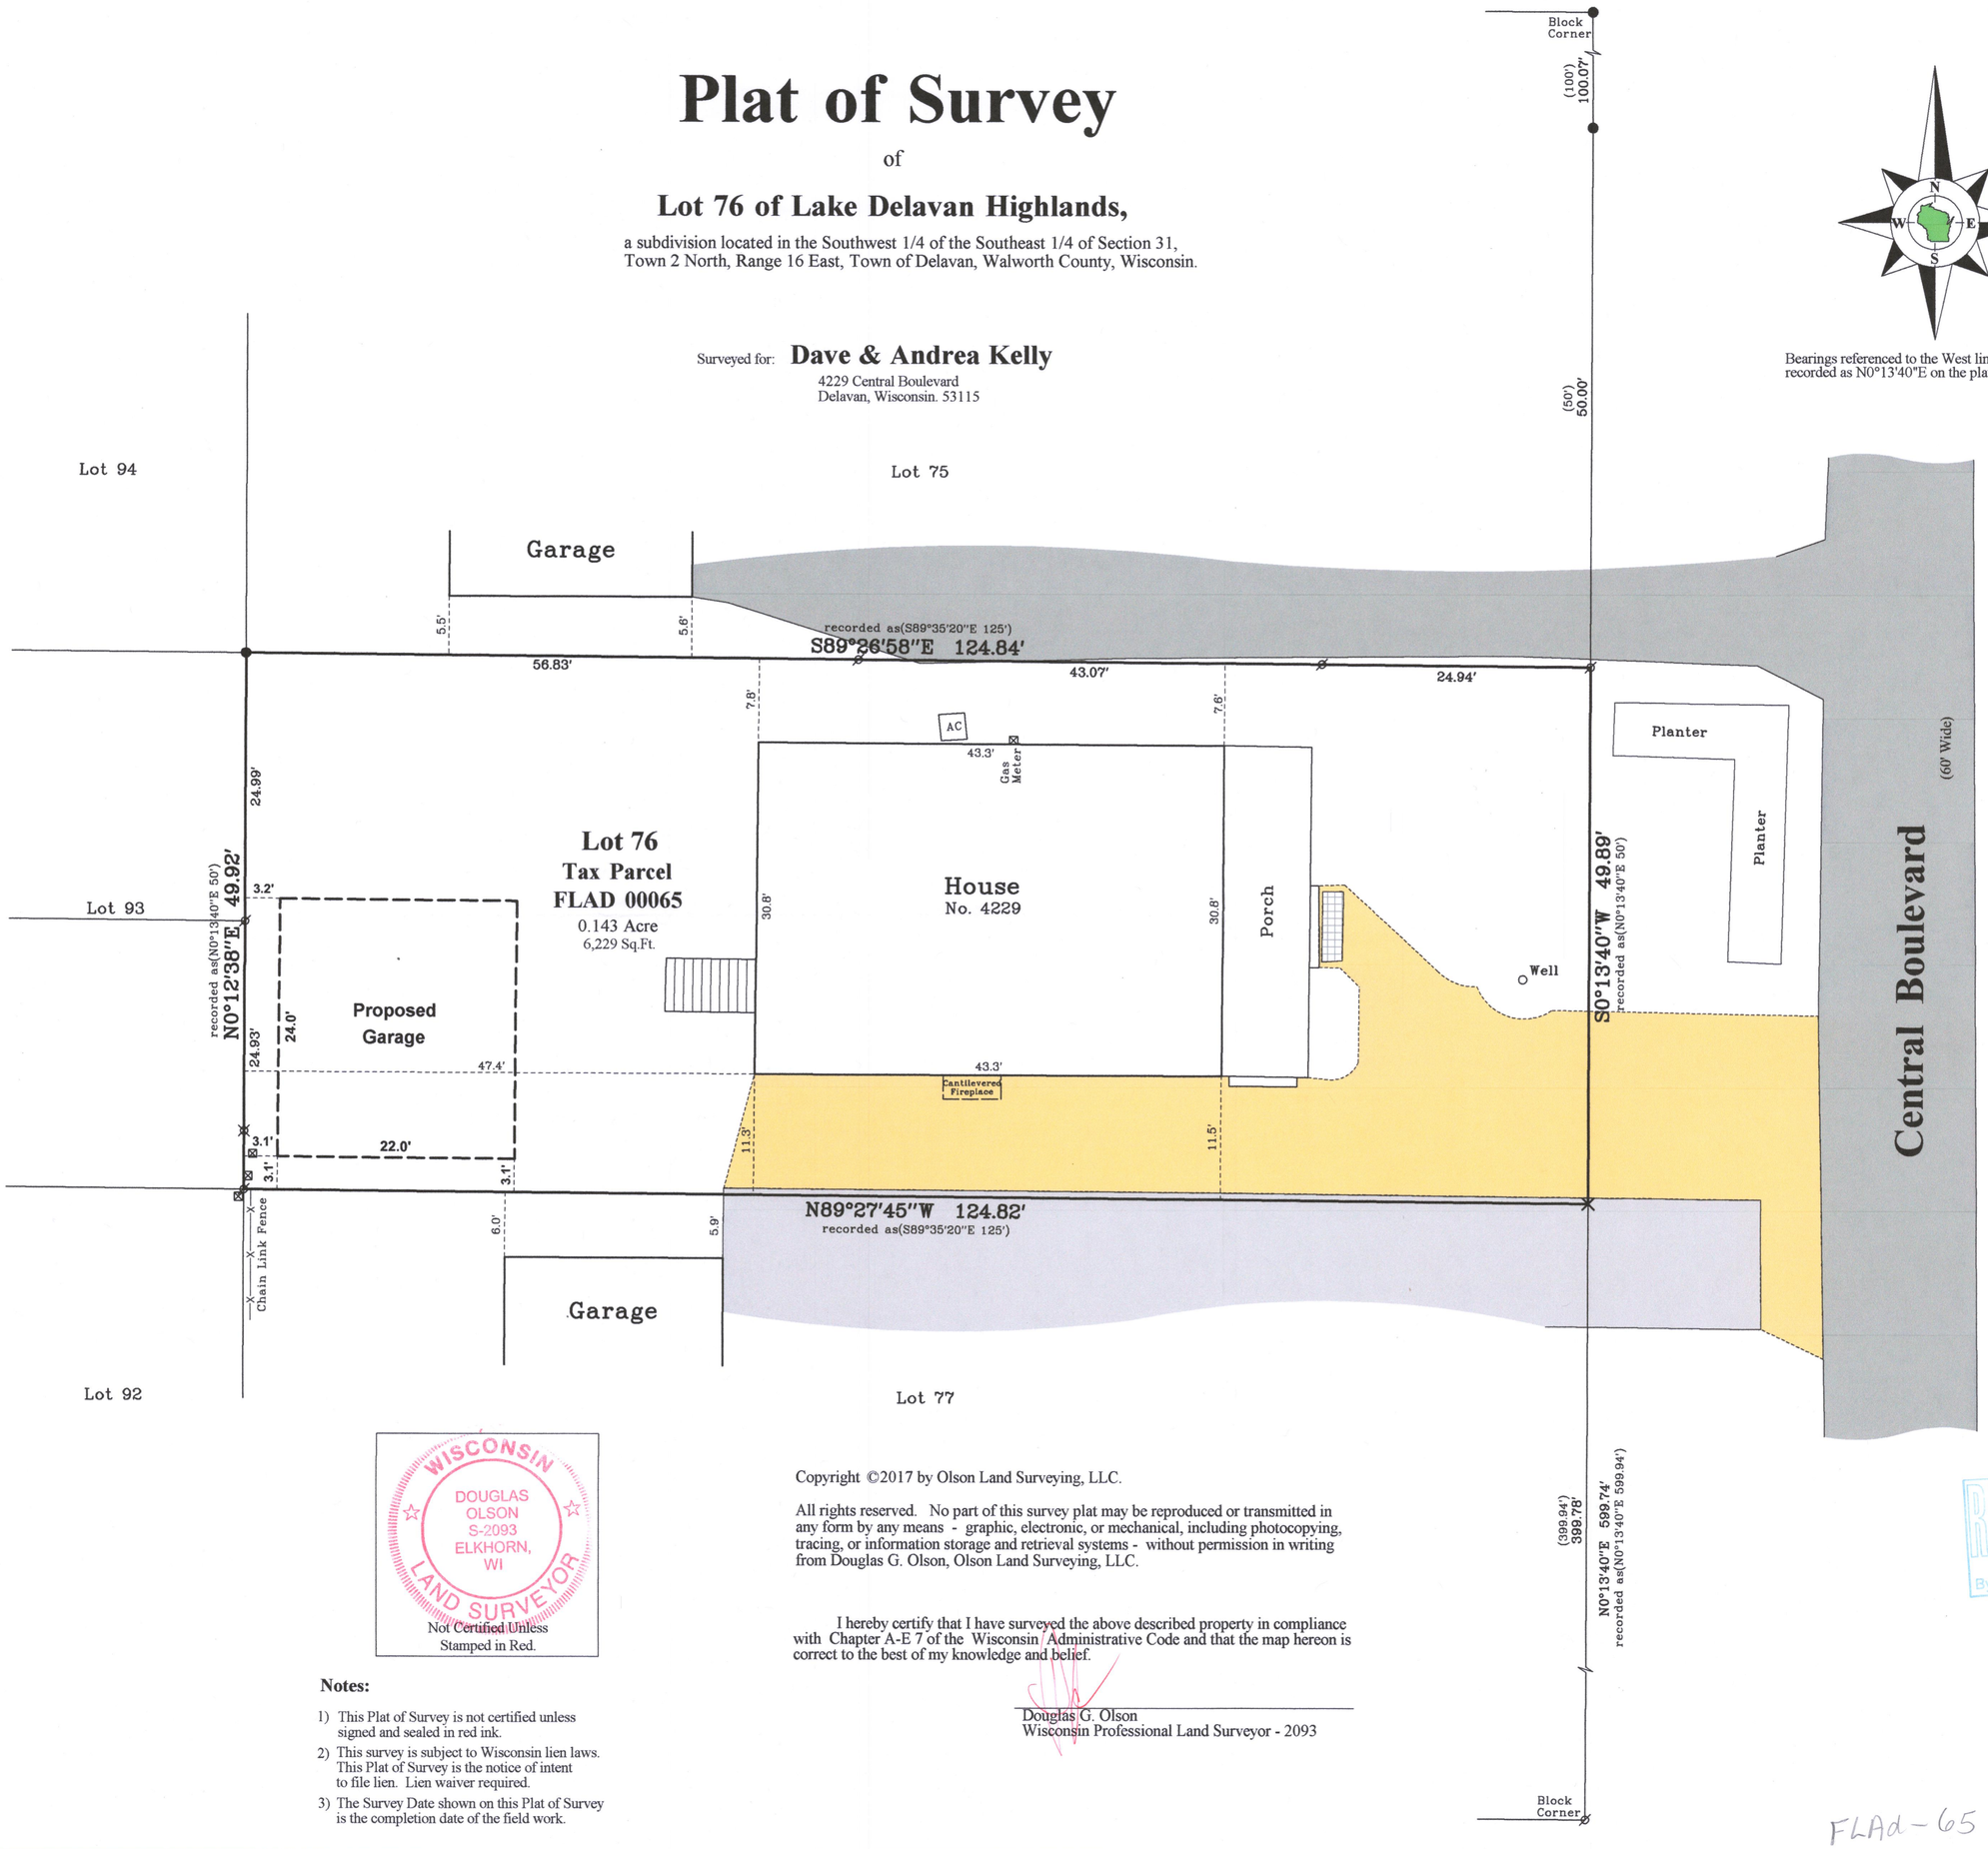

WISCONSIN
DOUGLAS OLSON
S-2093
ELKHORN, WI
LAND SURVEYOR
Not Certified Unless Stamped in Red.

Copyright ©2017 by Olson Land Surveying, LLC.

All rights reserved. No part of this survey plat may be reproduced or transmitted in any form by any means - graphic, electronic, or mechanical, including photocopying, tracing, or information storage and retrieval systems - without permission in writing from Douglas G. Olson, Olson Land Surveying, LLC.

I hereby certify that I have surveyed the above described property in compliance with Chapter A-E 7 of the Wisconsin Administrative Code and that the map hereon is correct to the best of my knowledge and belief.

Douglas G. Olson
Wisconsin Professional Land Surveyor - 2093

RECEIVED
SEP 25 2017
By

Notes:

1) This Plat of Survey is not certified unless signed and sealed in red ink.
2) This survey is subject to Wisconsin lien laws. This Plat of Survey is the notice of intent to file lien. Lien waiver required.
3) The Survey Date shown on this Plat of Survey is the completion date of the field work.

FLAd-65 216-5429

Survey Date: May 18, 2017.
Revisions: No. 1 - Proposed Garage

Scale in Feet
1" = 10'
0' 5' 10' 20' 30'

45 South Wisconsin Street | P.O. Box 322
Elkhorn, Wisconsin. 53121
Telephone: (262) 723-3434
Facsimile: (262) 723-8044
Email: doug@olsonsurveying.com
Website: www.olsonsurveying.com

OLSON
LAND SURVEYING, LLC
Rural | Residential | Commercial

Legend of Symbols & Abbreviations

- Found Iron Pipe
- Found Iron Rod
- Set Cut Cross
- Recorded Information
- Bollard
- Utility Pedestal
- Asphalt Surface
- Concrete Surface
- Gravel Surface
- Brick Pavers

N North
S South
E East
W West
In Bearings
° Degrees
' Minutes
" Seconds
In Distances
' Feet
" Inches

Sheet 1 of 1 Sheets

Drawing Name:

Job Reference Number
2017.031

2017.031