

Plat of Survey

of

Tax Parcel FA222900001,

located in Government Lot 5 in the Southeast 1/4 of Section 22, Town 2 North, Range 16 East, Town of Delavan, Walworth County, Wisconsin.


A parcel of land described in Title Commitment No. WA-19886 prepared by Chicago Title Insurance Company, dated July 13, 2021 as shown below:

Parcel F:
Lot 1, Certified Survey No. 2229 as recorded in Volume 10 of Certified Surveys on Page 357, recorded in the office of the Register of Deeds in and for Walworth County, Wisconsin, located in the Southwest 1/4 of the Southeast 1/4 of Section 22, Township 2 North, Range 16, East of the Fourth Principal Meridian.


Tax Key No.: FA222900001
Address: 1800 South Shore Drive

Surveyed for: **Keefe Real Estate, Inc.**

416 Bauer Parkway
Delavan, Wisconsin. 53115

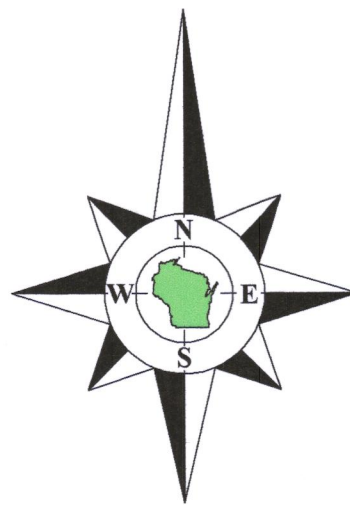

Bearings referenced to the North line of South Shore Drive, recorded as N66°25'00"E on the plat of Mereness Springs, the plat of San Souci, Certified Survey Map No. 2229 and numerous deeds, which produces a bearing of N89°45'39"W on the South line of the Southeast 1/4 of Section 22-2-16. A rotation of 2°32'18" from the Wisconsin State Plane Coordinate System, South Zone, (NAD-27).

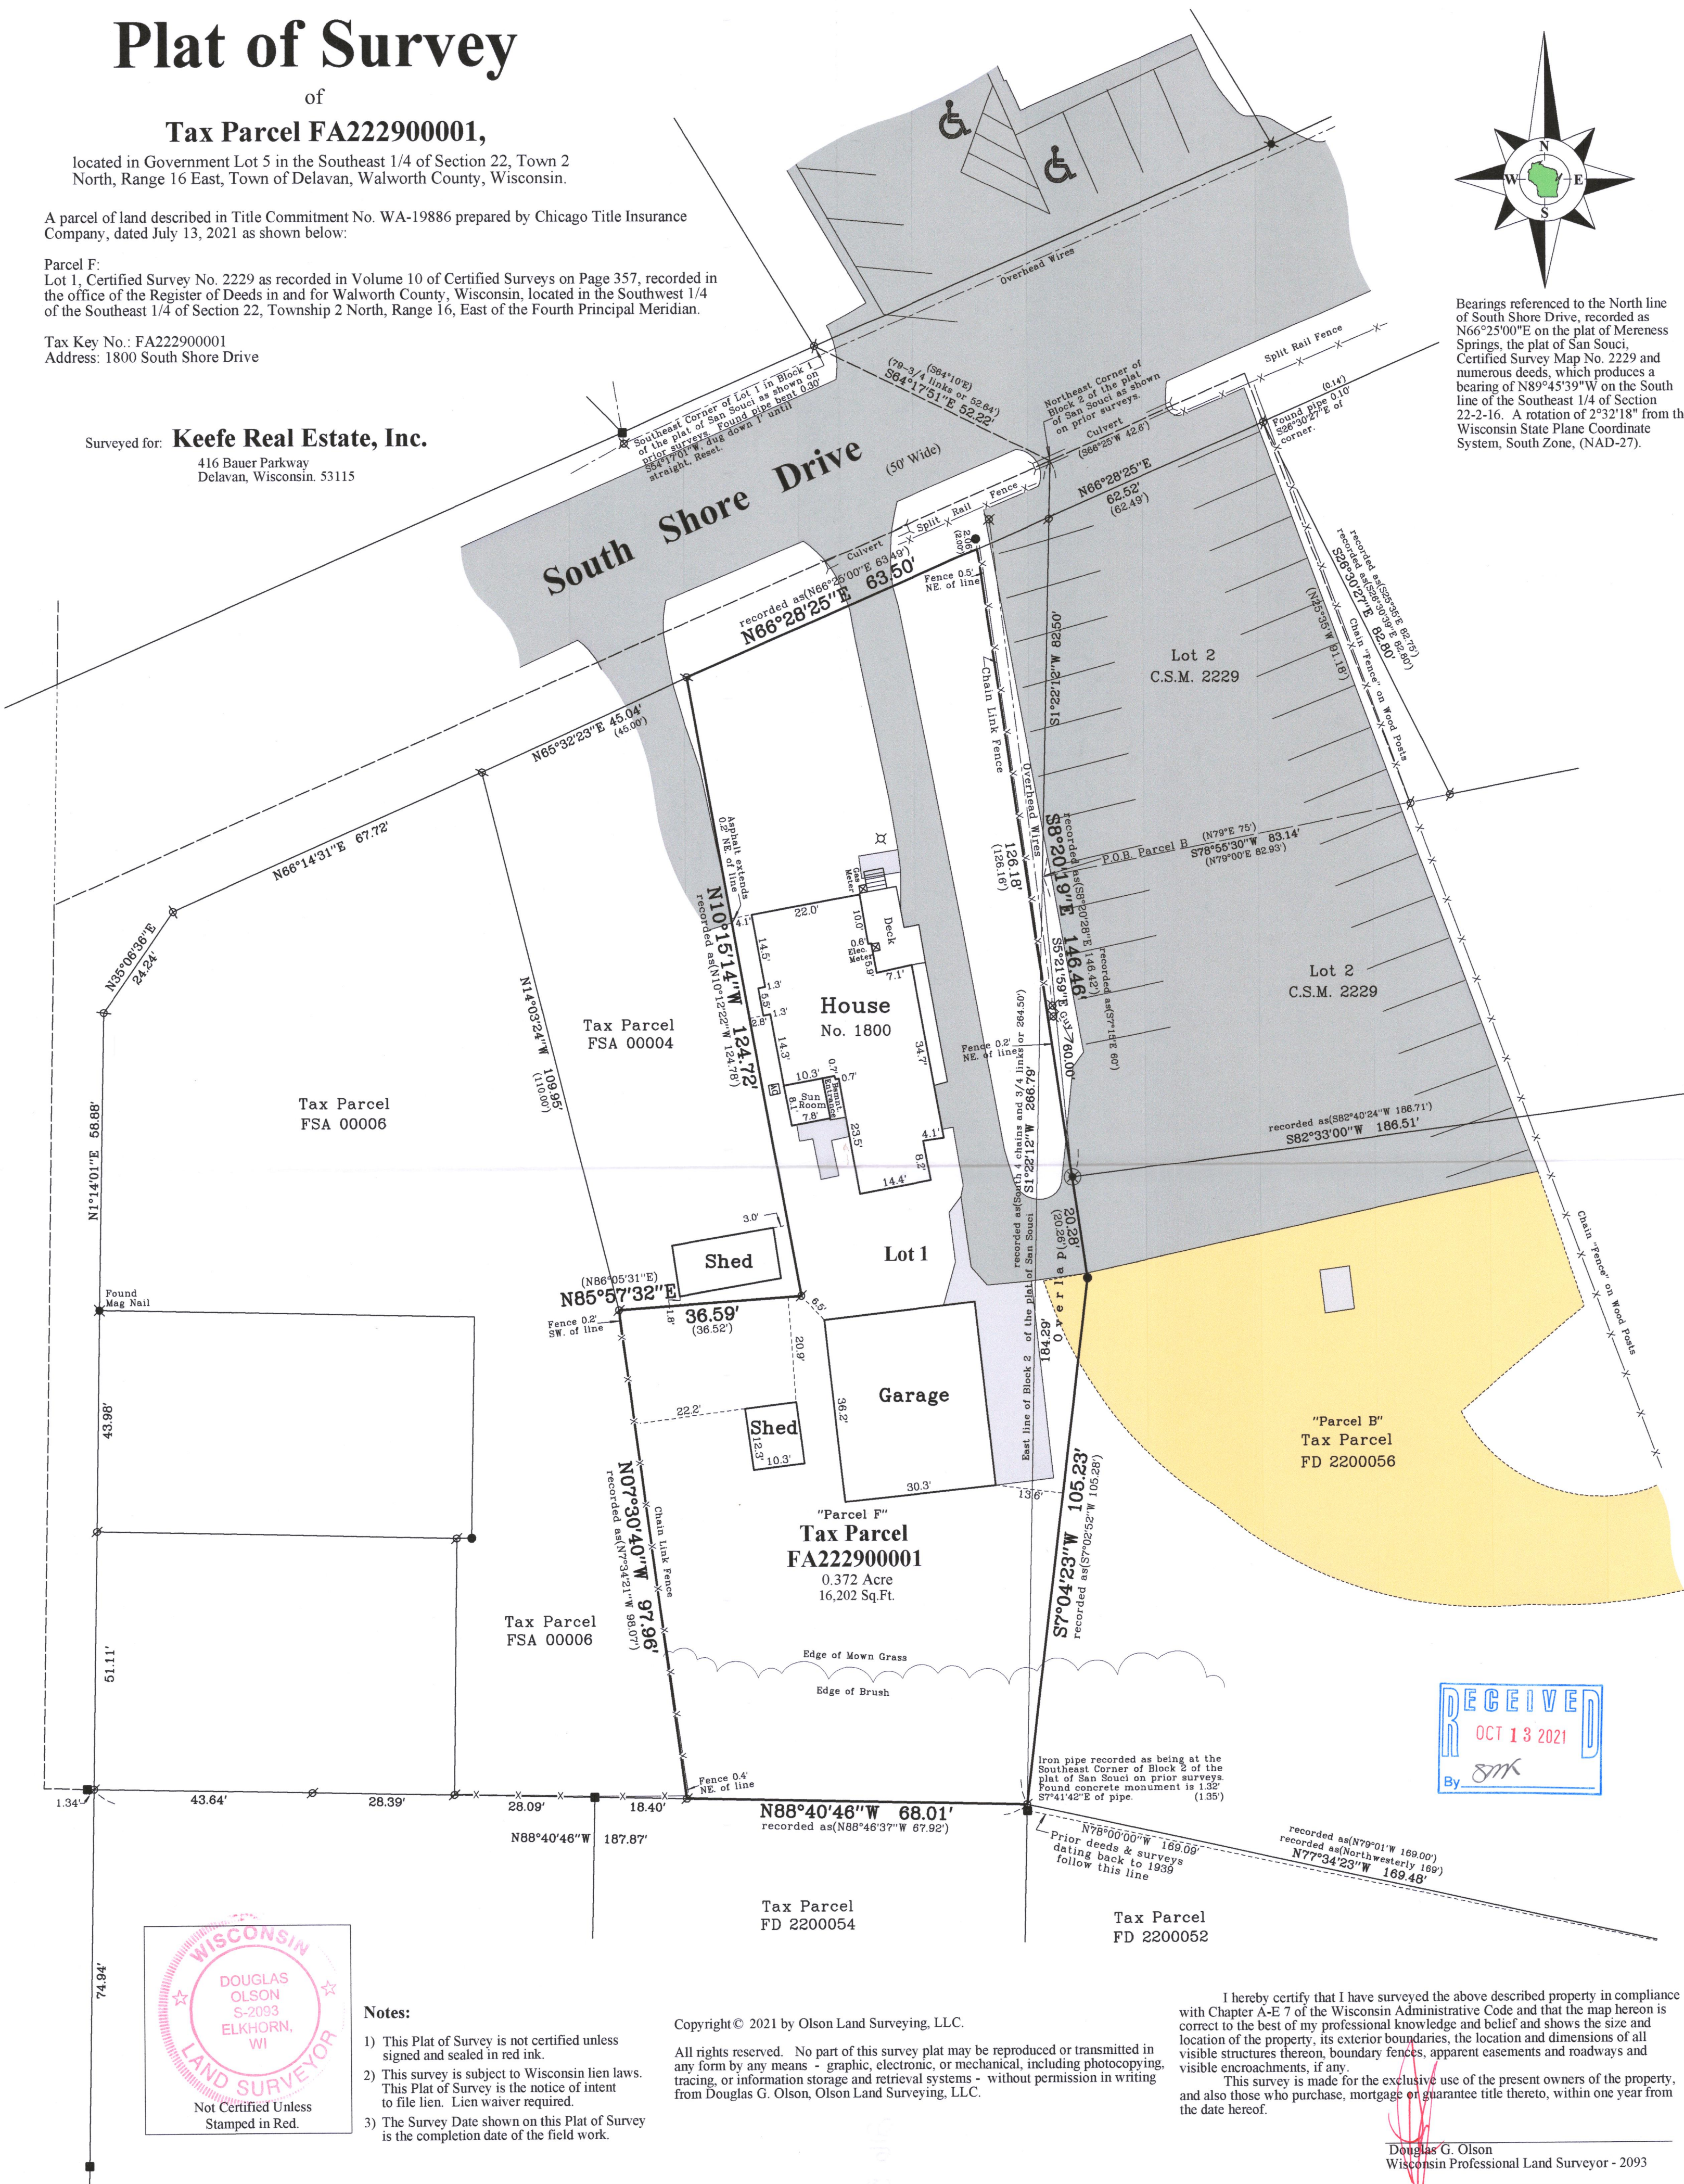

Notes:

- This Plat of Survey is not certified unless signed and sealed in red ink.
- This survey is subject to Wisconsin lien laws. This Plat of Survey is the notice of intent to file lien. Lien waiver required.
- The Survey Date shown on this Plat of Survey is the completion date of the field work.

Copyright © 2021 by Olson Land Surveying, LLC.

All rights reserved. No part of this survey plat may be reproduced or transmitted in any form by any means - graphic, electronic, or mechanical, including photocopying, tracing, or information storage and retrieval systems - without permission in writing from Douglas G. Olson, Olson Land Surveying, LLC.

I hereby certify that I have surveyed the above described property in compliance with Chapter A-E 7 of the Wisconsin Administrative Code and that the map hereon is correct to the best of my professional knowledge and belief and shows the size and location of the property, its exterior boundaries, the location and dimensions of all visible structures thereon, boundary fences, apparent easements and roadways and visible encroachments, if any.
This survey is made for the exclusive use of the present owners of the property, and also those who purchase, mortgage or guarantee title thereto, within one year from the date hereof.

Douglas G. Olson
Wisconsin Professional Land Surveyor - 2093

Sheet 7 of 7 Sheets

Drawing Name:

Job Reference Number
2021.082

Legend of Symbols & Abbreviations

- Found County Section Corner
- Found Concrete Monument
- Found Iron Pipe
- Found RR Spike
- Found Iron Rod
- Set Iron Pipe, 1" dia.
- Set Mag Nail
- Recorded Information
- Utility Pole
- Utility Pedestal
- Asphalt Surface
- Concrete Surface
- North
- South
- East
- West
- In Bearings
- Degrees
- Minutes
- Seconds
- In Distances
- Feet
- Inches

OLSON
LAND SURVEYING, LLC
Rural | Residential | Commercial

45 South Wisconsin Street | P.O. Box 322
Elkhorn, Wisconsin. 53121
Telephone: (262) 723-3434
Facsimile: (262) 723-8044
Email: doug@olsonsurveying.com
Website: www.olsonsurveying.com

Scale in Feet
1" = 20'

0' 10' 20' 40' 60'

Survey Date: July 30, 2021.

Revisions:

2021.082

FA2229-1

216-5838