


SURVEYING & SUBDIVIDING
DELA VAN, WISCONSIN 53115

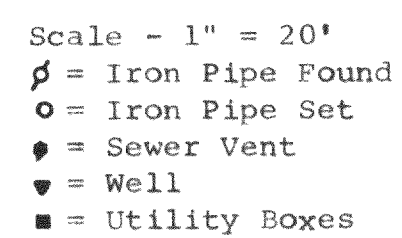

A circular seal with a dotted border. The text "WISCONSIN" is curved along the top inner edge, and "LAND SURVEYOR" is curved along the bottom inner edge. Two small stars are positioned on the left and right sides, separating the top and bottom text. In the center of the seal, the text "GEORGE T. DUNHAM" is written in a larger font, with "DELAVAN, WIS." written in a smaller font directly below it.