PLAT OF SURVEY OF LOTS 6,7,17,& 18 OF BLOCK 2 OF DELAVAN LAKE VIEW CREST, A SUBDIVISION LOCATED IN THE NORTH 1/2 OF SECTION 31, TOWN 2 NORTH, RANGE 16 EAST, WALWORTH COUNTY, WISCONSIN

FOR

John & Geralyn Stack

(xxx) = Record dimension

LEGEND FOR METAL MONUMENTS

= IRON PIPE SURVEY STAKE FOUND
= IRON ROD SURVEY STAKE FOUND
= IRON PIPE SURVEY STAKE SET

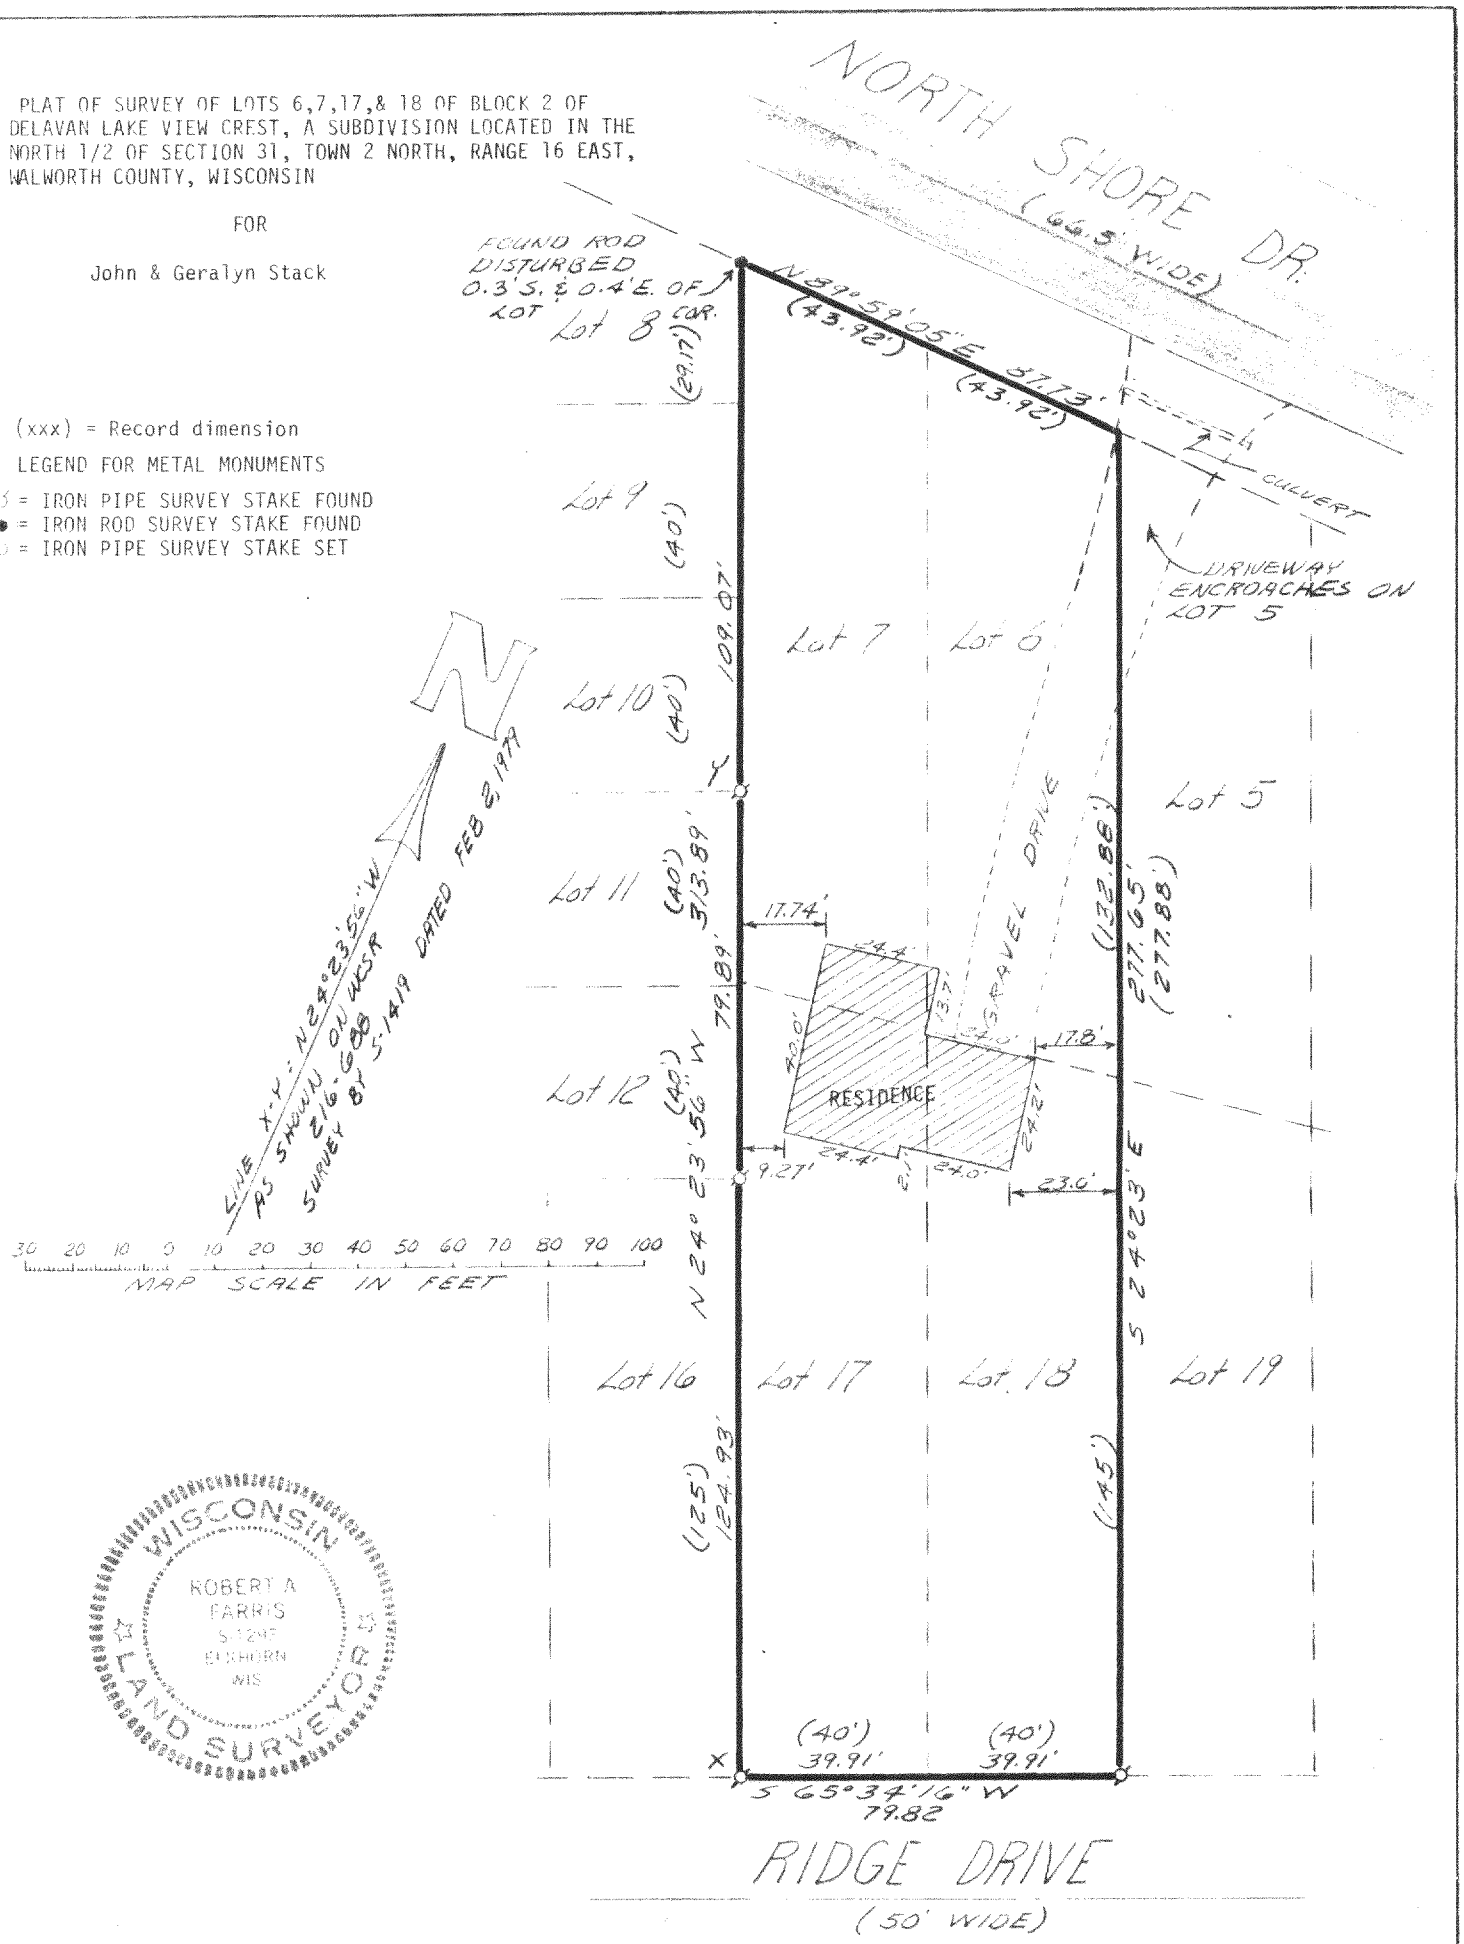

I hereby certify that I have surveyed the above described property and that the above map is a true representation thereof and shows the size and location of the property, its exterior boundaries, the location of all visible structures and dimensions of all principal buildings thereon, boundary fences, apparent easements, roadways and visible encroachments, if any.

This survey is made for the use of the present owners of the property, and also those who purchase, mortgage, or guarantee the title thereto within one (1) year from date hereof.

Robert A. Farris

Robert A. Farris RLS

DATED THIS 28th DAY OF OCTOBER, 1983

FOW-2A1, 2A8

Farris, Hansen & Associates, Inc.

Engineering, Surveying & Land Planning

P.O. BOX 487

715 W. WALWORTH STREET

ELKHORN, WISCONSIN 53121

PROJ. # 2178

216-771-F