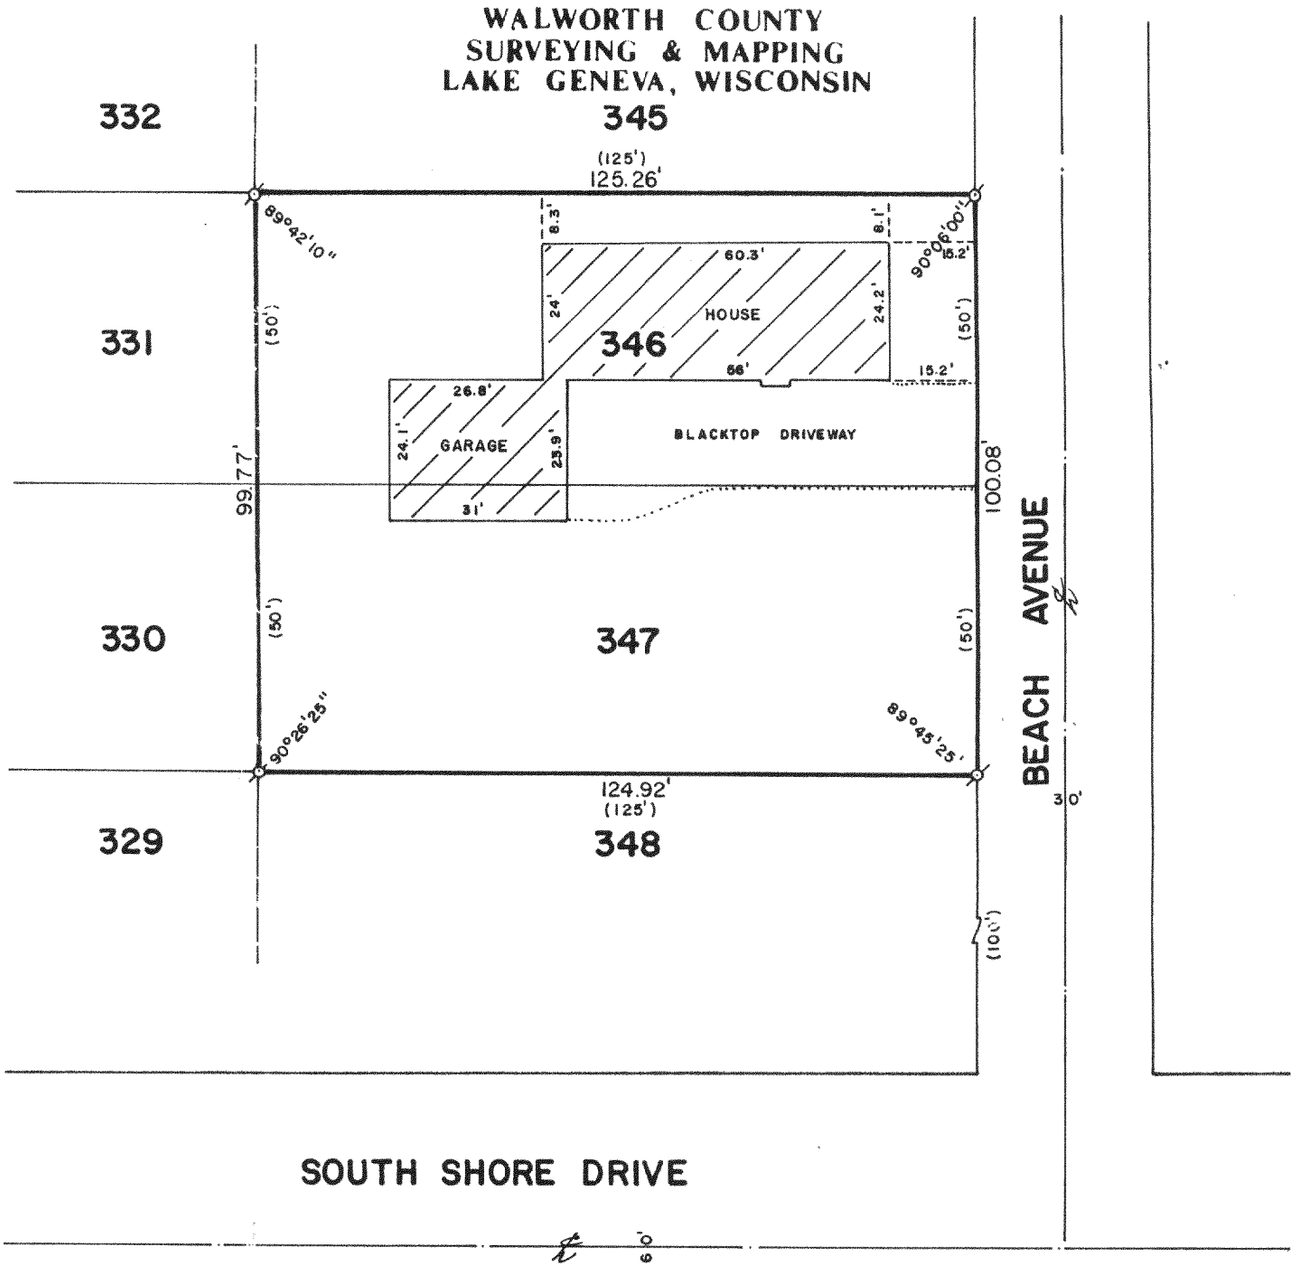

RECEIVED
FEB 4

PLAT OF SURVEY OF

LOTS 346 AND 347 OF LAKE DELAVAN HIGHLANDS, LOCATED IN SECTION 31, T 2 N, R 16 E, WALWORTH COUNTY, WISCONSIN.

ORDERED BY: COLDWELL BANKER
GENEVA LAKES AREA REALTORS
838 MAIN STREET
LAKE GENEVA, WISCONSIN 53147

SCALE: 1"=30'

ø-IRON PIPE FOUND
()-RECORDED AS

I, ROBERT M. BAERENWALD, DO HEREBY CERTIFY THAT I HAVE SURVEYED THE PROPERTY HEREON DESCRIBED ACCORDING TO THE OFFICIAL RECORDS AND THAT THE PLAT HEREON IS A CORRECT REPRESENTATION OF THE PROPERTY LINES TO THE BEST OF MY KNOWLEDGE AND BELIEF.

Robert M. Baerenwald
ROBERT M. BAERENWALD
WISCONSIN REGISTERED LAND SURVEYOR, S-1508

Oct. 6, 1986
DATE JOB NO. 0766

NOTE: THIS IS NOT A CERTIFIED COPY UNLESS SEALED.

FLAD-260

216-8836