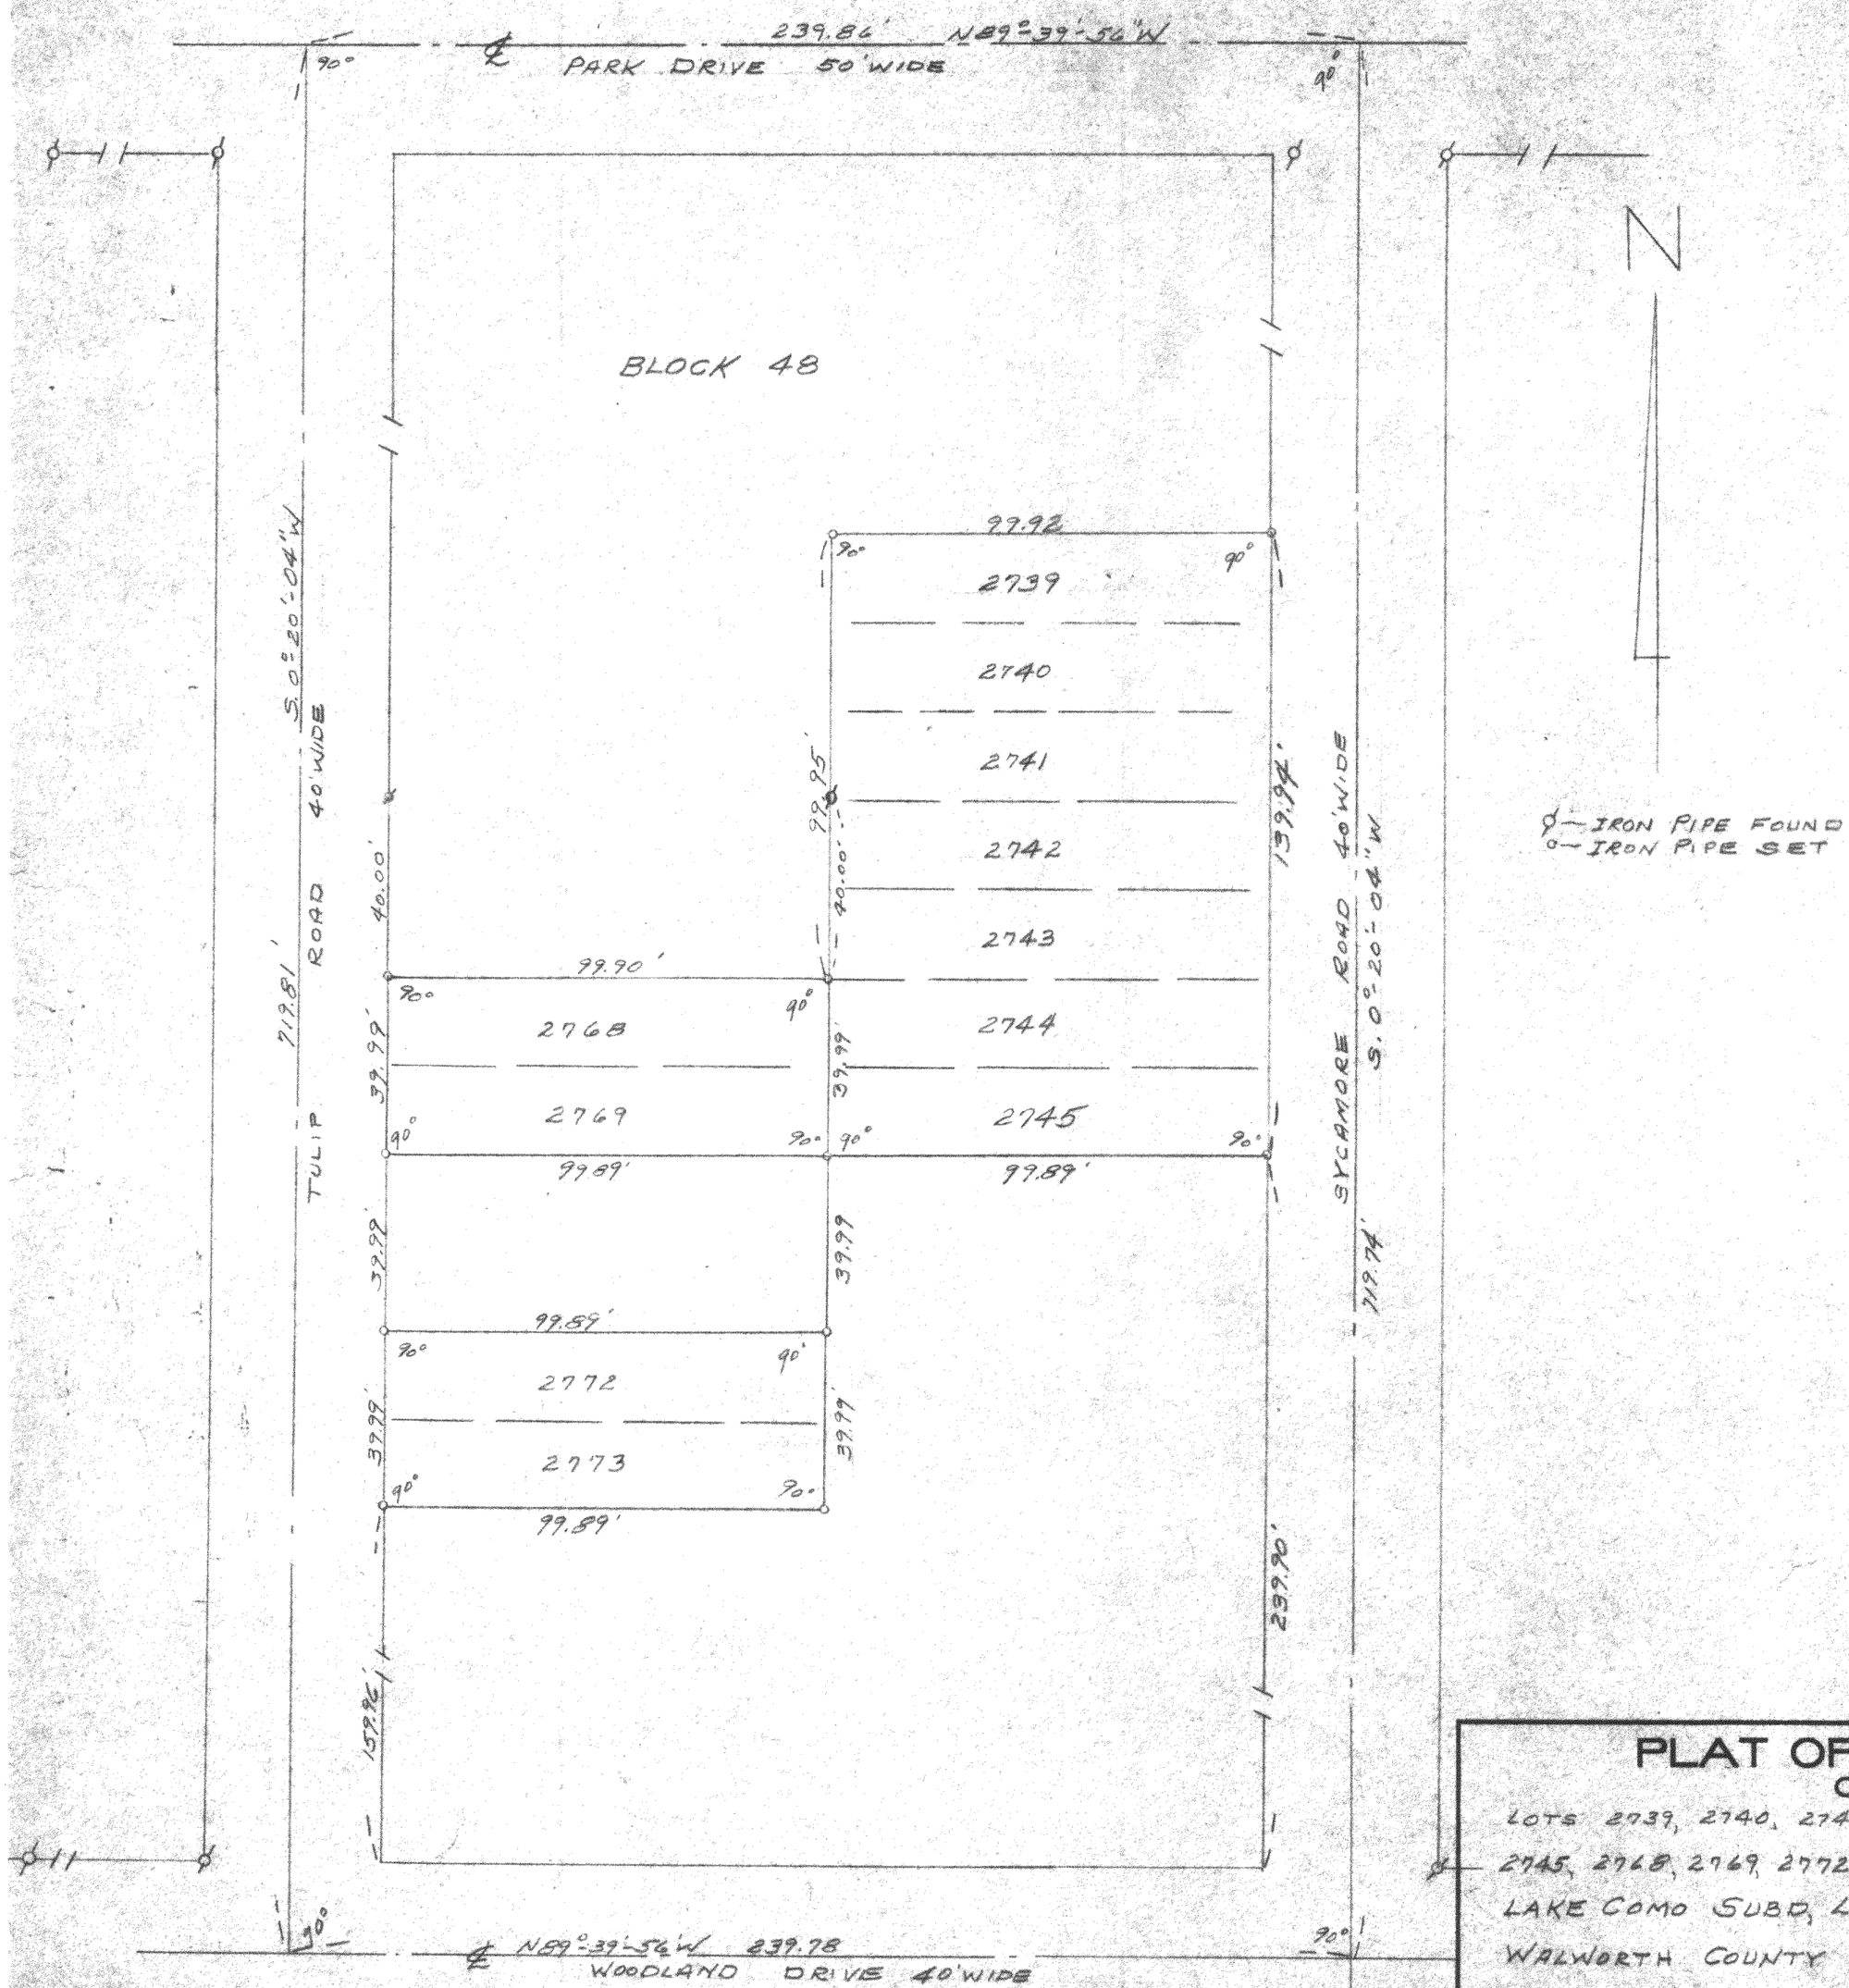

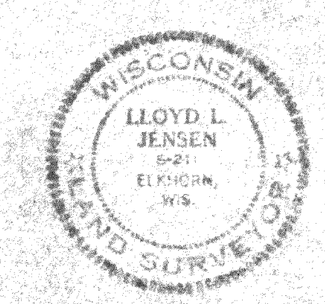

PLAT OF SURVEY
OF

LOTS 2739, 2740, 2741, 2742, 2743, 2744, 2745, 2768, 2769, 2772, 2773, BLOCK 48 LAKE COMO SUBD, LOCATED IN T2N R17E WALWORTH COUNTY WISCONSIN.

Lloyd L Jensen
SURVEYOR

SCALE 1" = 30'

DATE MAY 1967

JLCB 476,483

NO. 12511—400—1-30-58

217-105.1