

— WORK ORDERED BY —
LOWELL MANAGEMENT SERVICES, INC.
P.O. BOX 926
LAKE GENEVA, WI 53147



FARRIS, HANSEN & ASSOCIATES, INC.
ENGINEERING — ARCHITECTURE — SURVEYING
7 RIDGWAY COURT P.O. BOX 437
ELKHORN, WISCONSIN 53121
OFFICE: (262) 723-2098 FAX: (262) 723-5886

REVISIONS
10/20/2006 - NO
AND EROSION CONTROL
PLAN

PROJECT NO.
3269-10-06
DATE
10/05/2006
SHEET NO.
1 OF 1

PLAT OF SURVEY
UNIT 10-06
GENEVA NATIONAL CONDOMINIUM
NO. 10
LOCATED IN TOWN 2 NORTH, RANGE 17 EAST
WALWORTH COUNTY, WISCONSIN

LEGEND
● = FOUND IRON REBAR STAKE
(XXX) = RECORDED AS

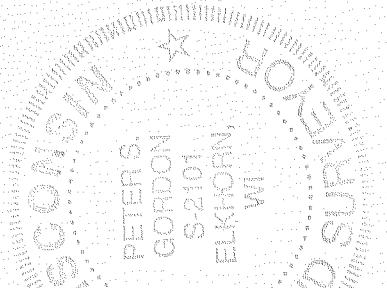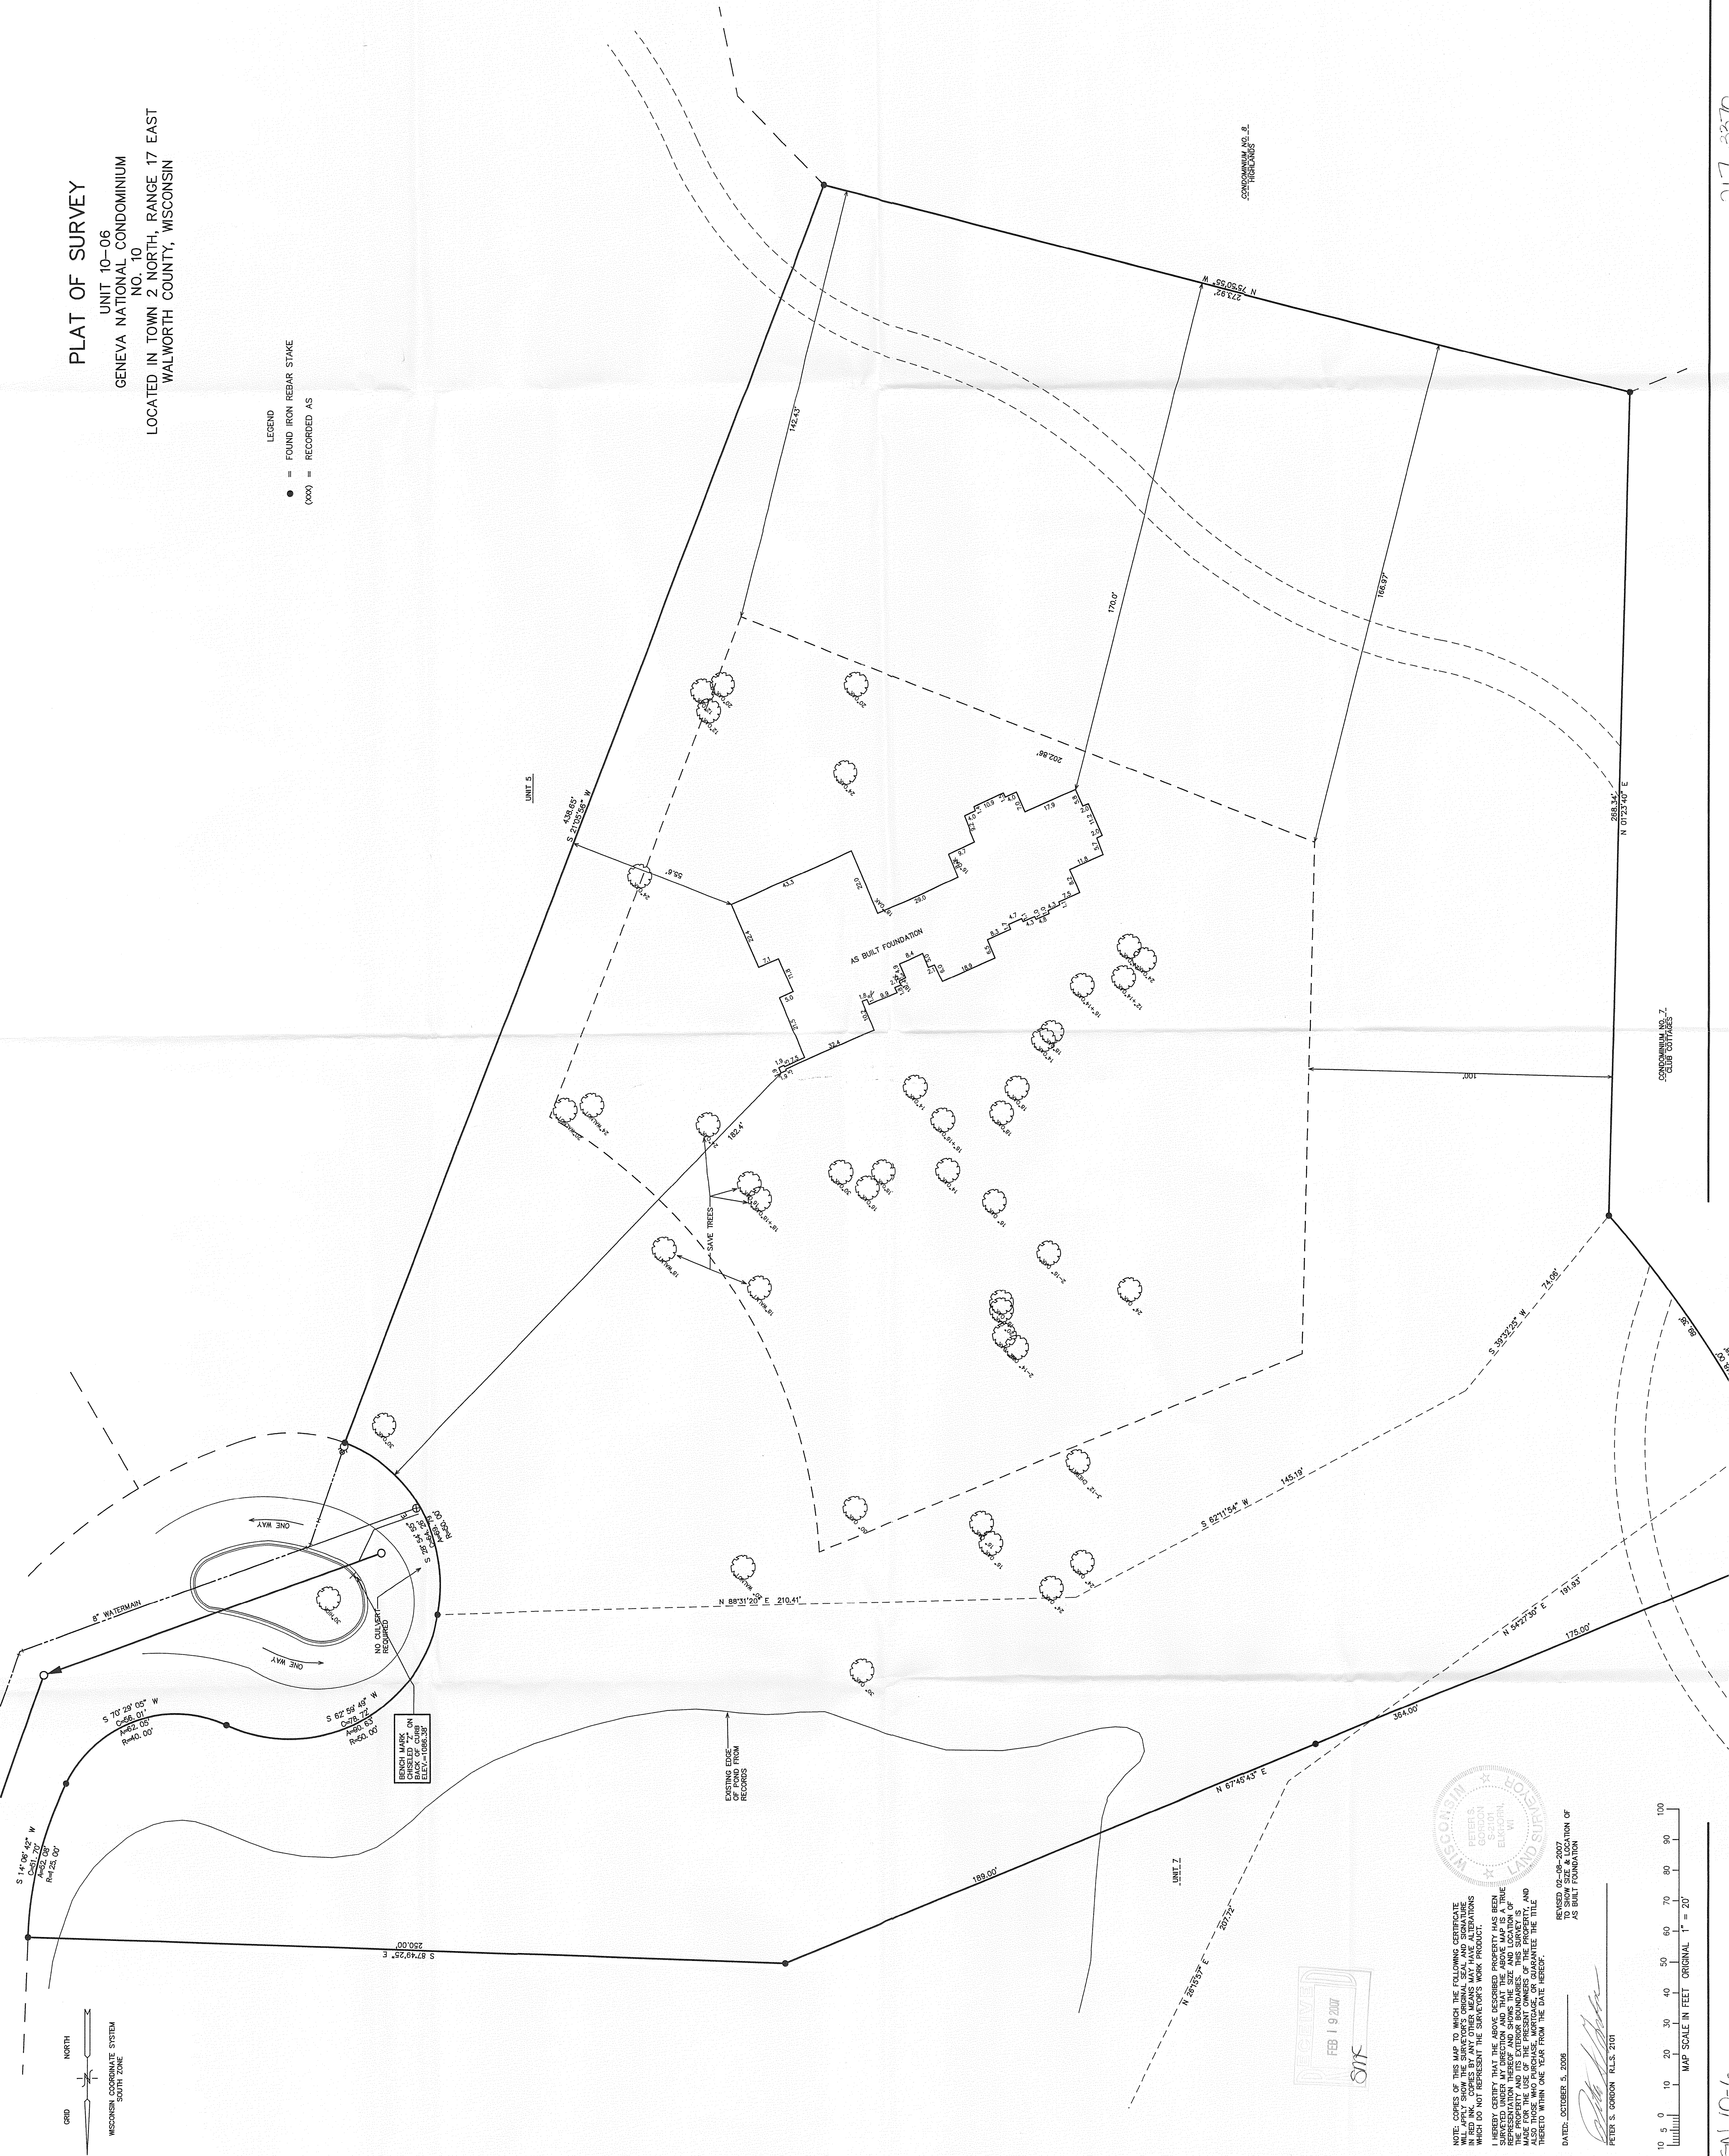

NOTE: COPIES OF THIS MAP TO WHICH THE FOLLOWING CERTIFICATE WILL APPLY SHALL BE THE SURVEYOR'S ORIGINAL SEAL AND SIGNATURE. THE SURVEYOR'S ORIGINAL SEAL AND SIGNATURE SHALL NOT BE REPRODUCED OR COPIED. 

I HEREBY CERTIFY THAT THE ABOVE DESCRIBED PROPERTY HAS BEEN SURVEYED UNDER MY PERSONAL SUPERVISION AND THAT THE ABOVE MAP IS A TRUE AND CORRECT COPY OF THE ORIGINAL SURVEY. THE SURVEY IS THE PROPERTY AND ITS EXTERIOR BOUNDARIES. THE SURVEY IS ALSO THOSE WHO SURVEYED, MORTGAGED, OR GUARANTEED THE TITLE THERETO WITHIN ONE YEAR FROM THE DATE HEREOF.

DATED: OCTOBER 5, 2006
BY: *Peter S. Gordon*
PETER S. GORDON, R.L.S. 2101

REVISION 02-08-2007
BY: *Peter S. Gordon*
AS BUILT FOUNDATION

10 5 0 10 20 30 40 50 60 70 80 90 100
MAP SCALE IN FEET ORIGINAL 1" = 20'