PREPARED FOR
DIANE PIERRARD
SHOREWEST REALTOR'S
623 MAIN ST.
LAKE GENEVA WI. 53147

PLAT OF SURVEY OF

LOT 2 OF CERTIFIED SURVEY MAP NO. 778, SAID SURVEY BEING LOCATED IN THE SOUTHWEST 1/4 OF SECTION 33, TOWN 2 NORTH, RANGE 17 EAST, TOWN OF GENEVA, WALWORTH COUNTY, WISCONSIN AND RECORDED ON APRIL 26, 1978 IN VOLUME 3 OF CERTIFIED SURVEYS ON PAGE 308 AS DOCUMENT NO. 31765

KROTT SURVEYING INC.
(262) 248-3697
N 3705 WILLOW BEND LANE
LAKE GENEVA WI. 53147

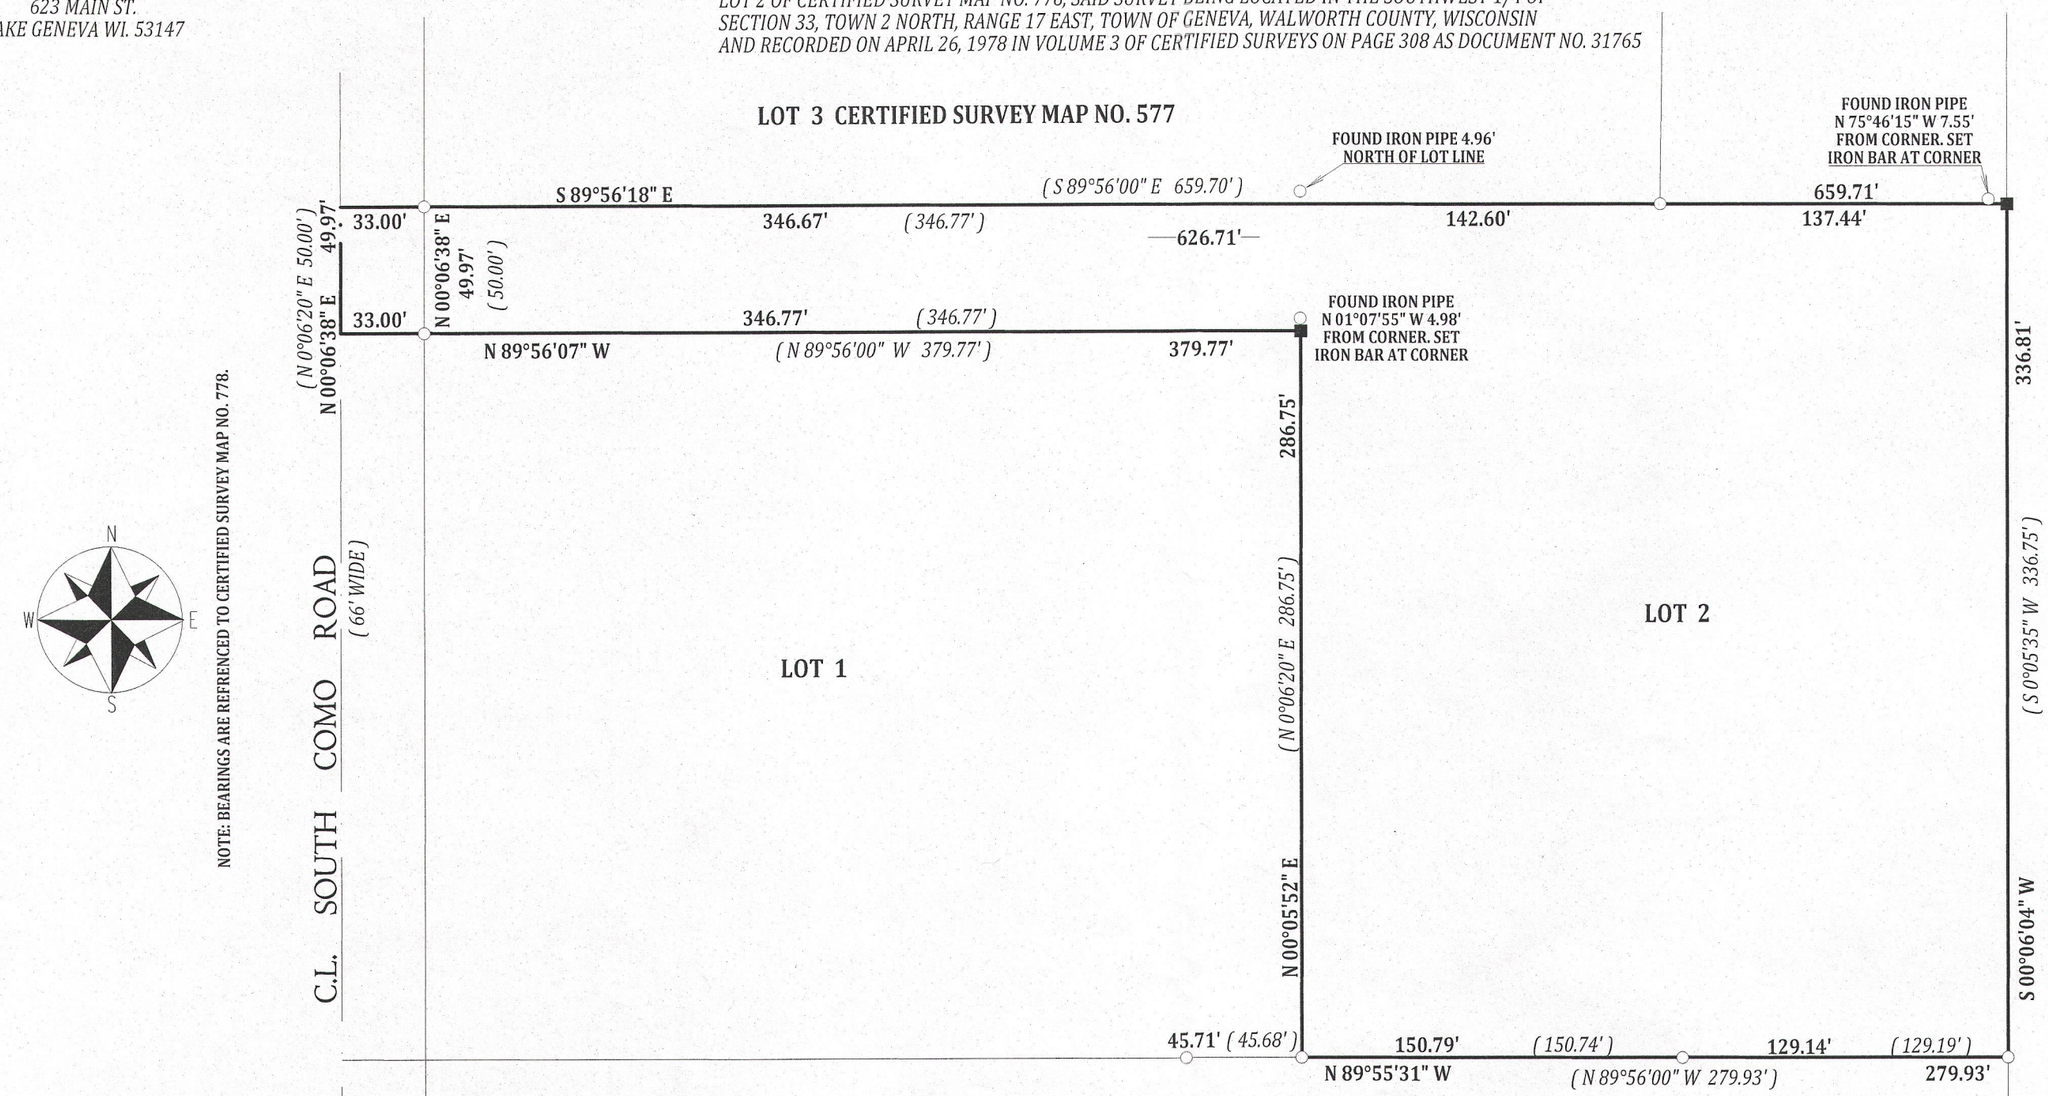

NOTE: BEARINGS ARE REFRENCED TO CERTIFIED SURVEY MAP NO. 778.

LEGEND

○ FOUND 1" DIA. IRON PIPE

■ SET 3/8" DIA. IRON BAR

(XX) RECORDED AS

TAX ID # JA77800002

JOB # 13-136

I have surveyed the above-described property and the above map is a true representation thereof and shows the size and location of the property, its exterior boundaries, the location and dimensions of all structures thereon, fences apparent easements and roadways and visible encroachments. if any.

This survey is made for the exclusive use of the present owners of the property, and also those who puchase, mortgage,or insure the title therto within one (1) year from date hereof; and as to them I warrant the accuracy of said survey map.

LOT 1 CERTIFIED SURVEY MAP NO. 1011

RECEIVED
OCT 4 2013
By jlc

SCALE 1" = 60'

0 60 120 180

WISCONSIN
JOHN P. KROTT
S-2258
LAKE GENEVA WIS.
LAND SURVEYOR

DATED THIS 16th DAY OF SEPTEMBER 2013

JOHN P. KROTT S-2258
WISCONSIN REGISTERED LAND SURVEYOR
(NOTE: THIS IS NOT A CERTIFIED COPY UNLESS SIGNED IN RED INK)

217-3913