


APR 27 2017

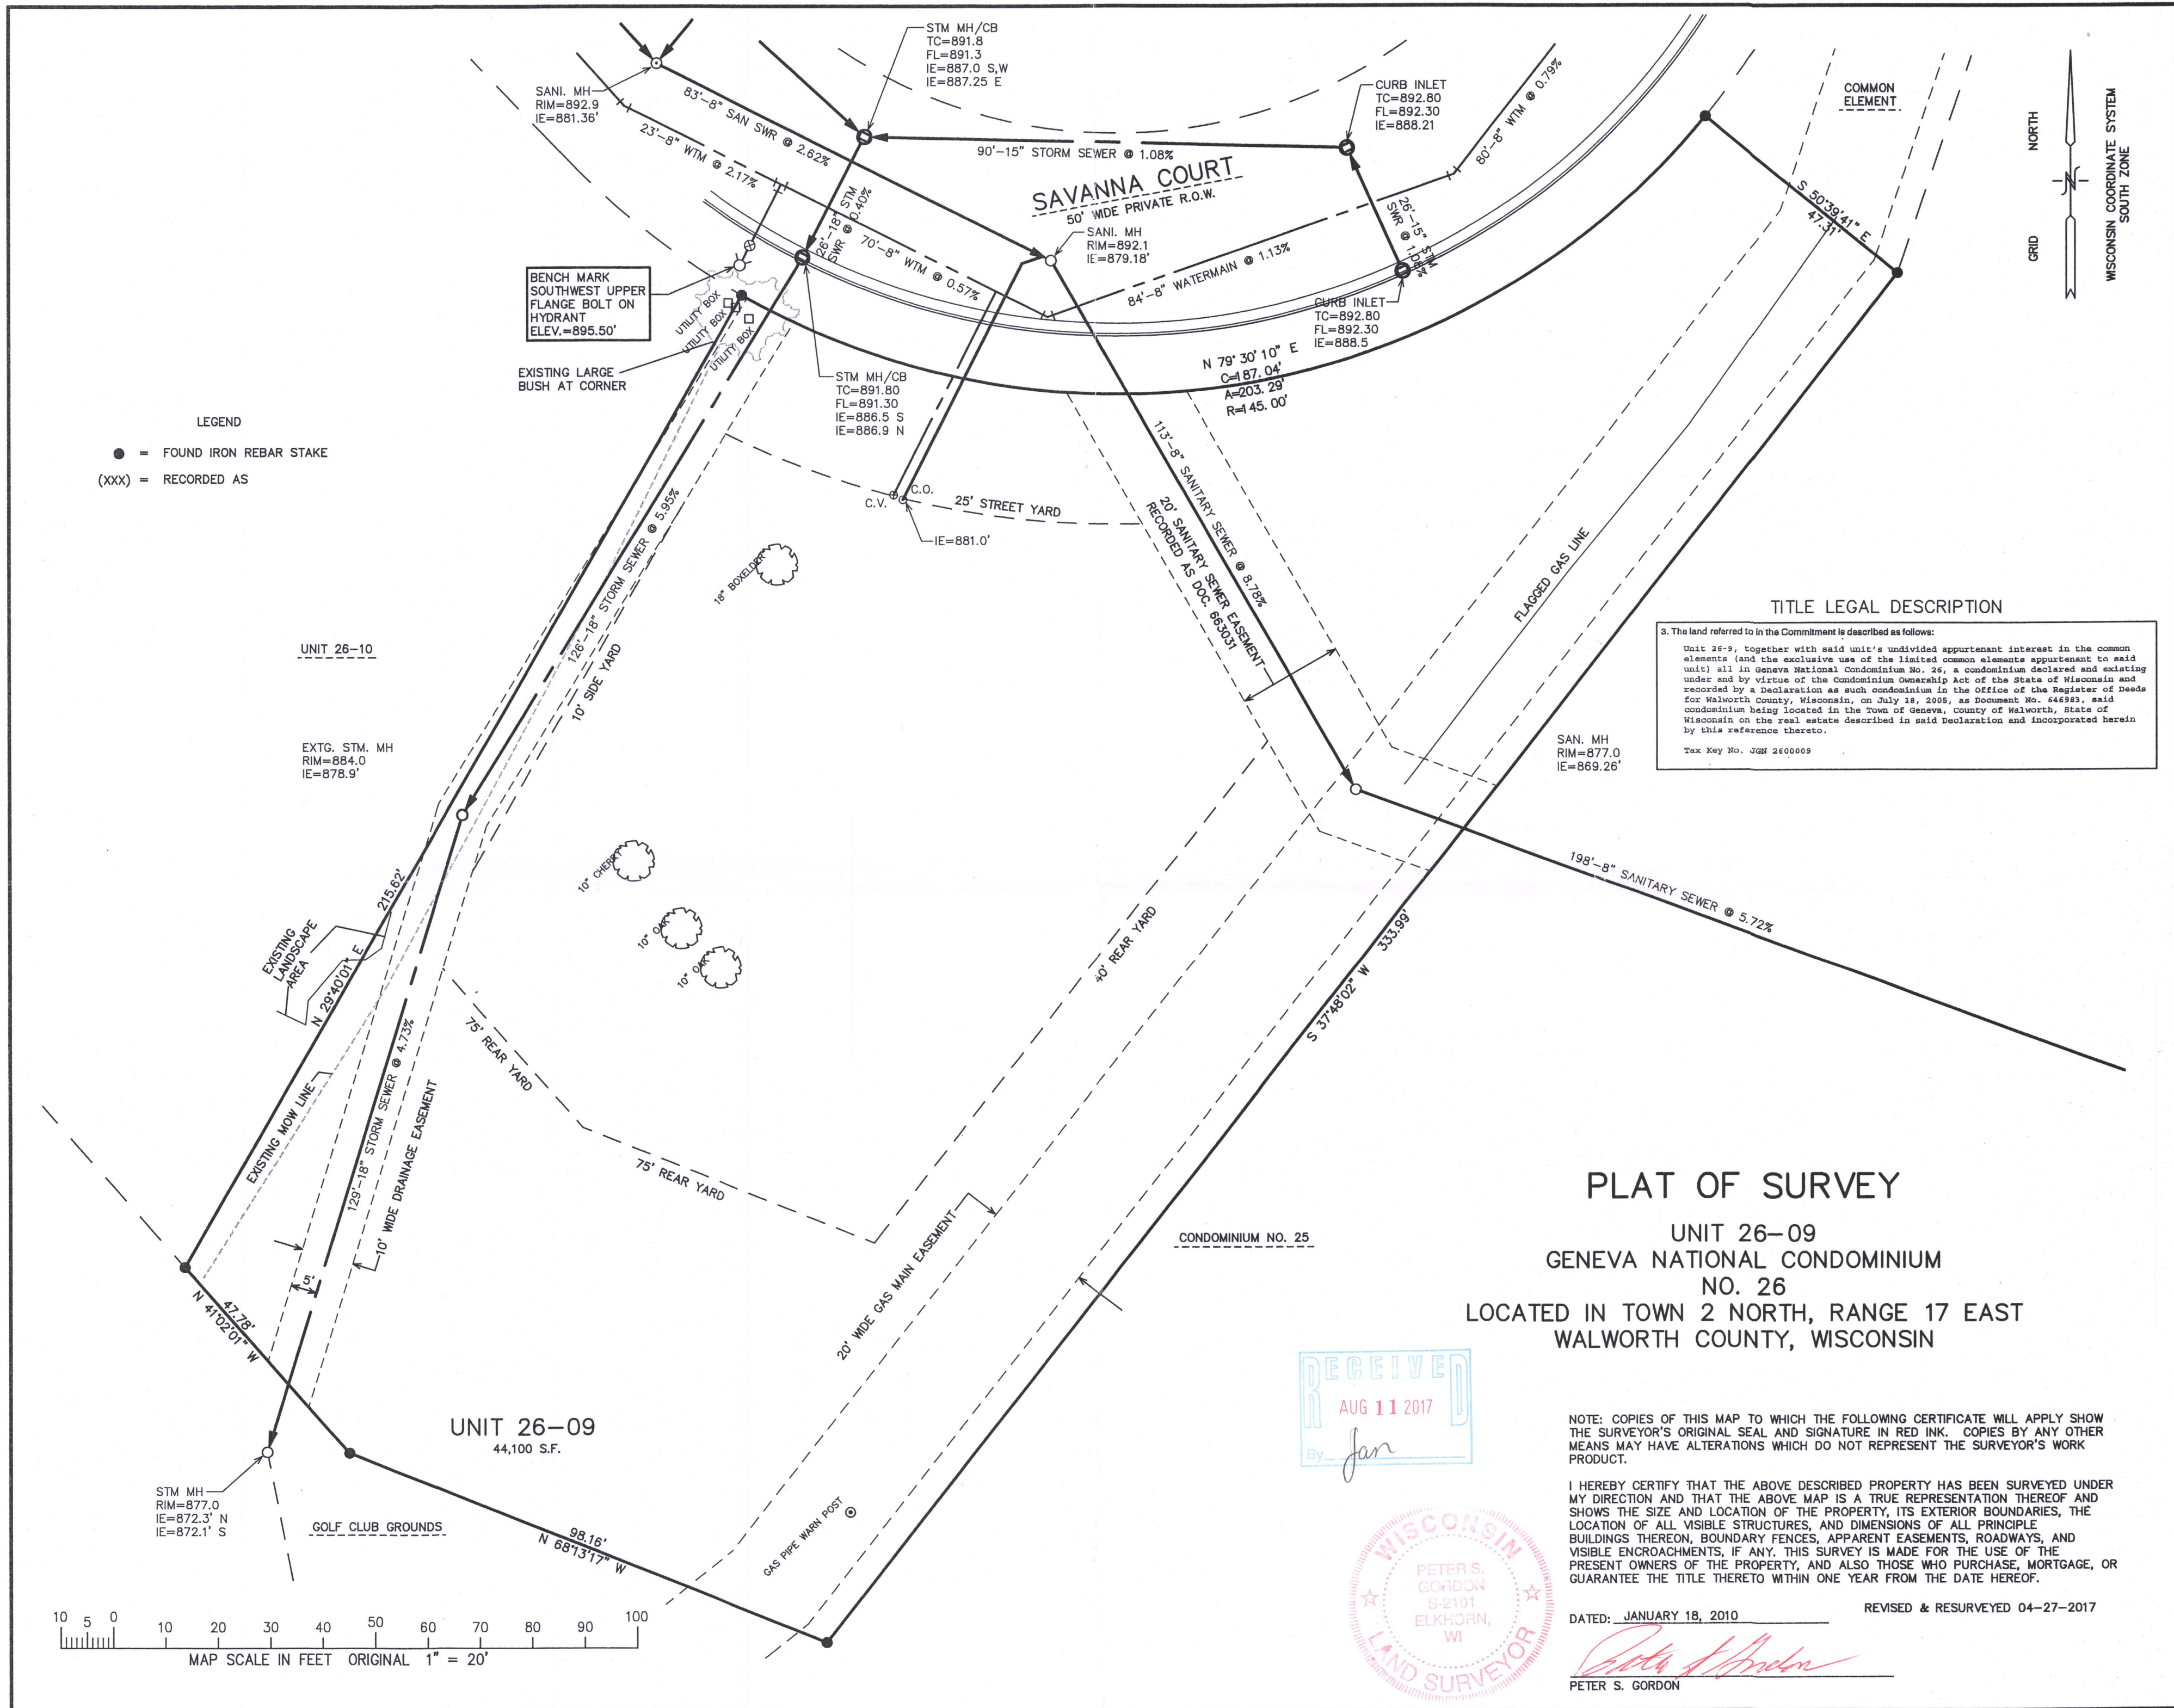

FARRIS, HANSEN & ASSOCIATES, INC.
Engineering, Architecture, Surveying
7 Ridgeway Court P.O. Box 437
ELKHORN, WISCONSIN 53121
Office: (262) 723-2098
Fax: (262) 723-5886

REVISIONS
09-18-2006
UPDATE
01-15-10
RESURVEY

PROJECT NO.
3269.26.09
DATE:
11/23/05
SHEET NO.
1 OF 1

WORK ORDERED FOR -
RICHARD & ANNE HUTTER
BY: RUTA SYVERSON
LAKE GENEVA, WI 53147

