

Wisconsin Professional Land Surveyor S-2582

**N9330 Knuteson Drive
Whitewater, WI 53190
Phone:(262)495-3284
MARKMIRITZ@
LAND-MARKSURVEYING.COM**

**LOTS 10622 THROUGH 10626 INCLUSIVE AND LOTS 10643 THROUGH 10647
ALL IN BLOCK 192, FIFTH MAP OF LAKE COMO BEACH SUBDIVISION, LOCATED
IN THE NORTHWEST 1/4, OF THE NORTHWEST 1/4, SECTION 28, TOWNSHIP 2
NORTH, RANGE 17 EAST, TOWN OF GENEVA, WALWORTH COUNTY, WISCONSIN.**

OWNER: ROBERT A. FECHO AND CLAUDIA J. FECHO
1177 HILLCREST DR.
CAROL STREAM, IL. 60188


Block 192







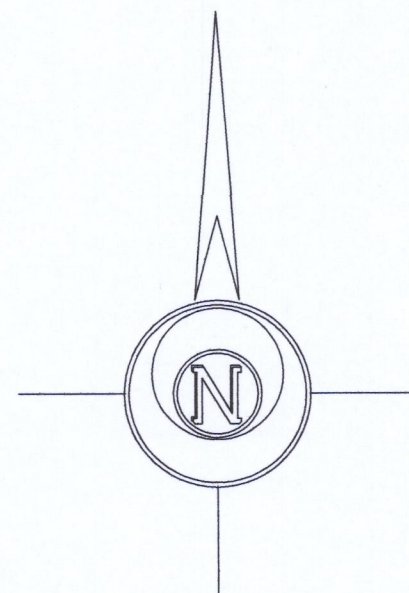

BASIS OF BEARINGS:
THE NORTH LINE OF BLOCK 192 AS MONUMENTED
BEING N 89°44'32" E

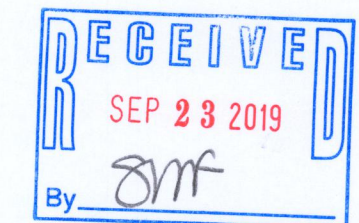

LEGEND

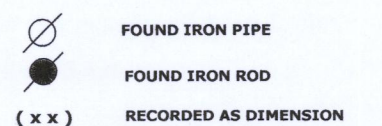

SCALE: 1 INCH= 20 FEET

"I hereby certify that the above described property has been surveyed by me or under my direction and that the above map is a true representation thereof and shows the situation and location of the property, its exterior boundaries, the location of all visible structures and dimensions of all principal buildings thereon, boundary fences, apparent easements, roadways and visible encroachments, if any."

hereof."

Mark L. Miritz
MARK L. MIRITZ
WISCONSIN PROFESSIONAL
LAND SURVEYOR S-2582

DATE: DEC. 6, 2016 JOB NO. 16.1108

REVISED AUGUST 31, 2019 TO
SHOW GARAGE "AS BUILT"

REVISED DEC. 20, 2018: ADD
MISC. EROSION CONT. DEVICES
REVISED DEC. 3, 2018: REVISE
GARAGE LOCATION

**REVISED NOV. 6, 2018: ADD
PROPOSED GARAGE & RELATED GRADING**

REVISD JAN. 10, 2017 TO
SHOW FOUNDATION "AS BUILT"

JLCB-2312

217-4588