


PLAT OF SURVEY & TOPOGRAPHIC MAPPING UNIT 3-46 OF GENEVA NATIONAL CONDOMINIUM NO. 3


LOCATED IN PART OF THE NW 1/4 OF THE SE 1/4
OF SECTION 30, TOWN 2 NORTH, RANGE 17 EAST,
TOWN OF GENEVA, WALWORTH COUNTY, WISCONSIN

GRID NORTH
WISCONSIN STATE PLANE COORDINATE SYSTEM
SOUTH ZONE

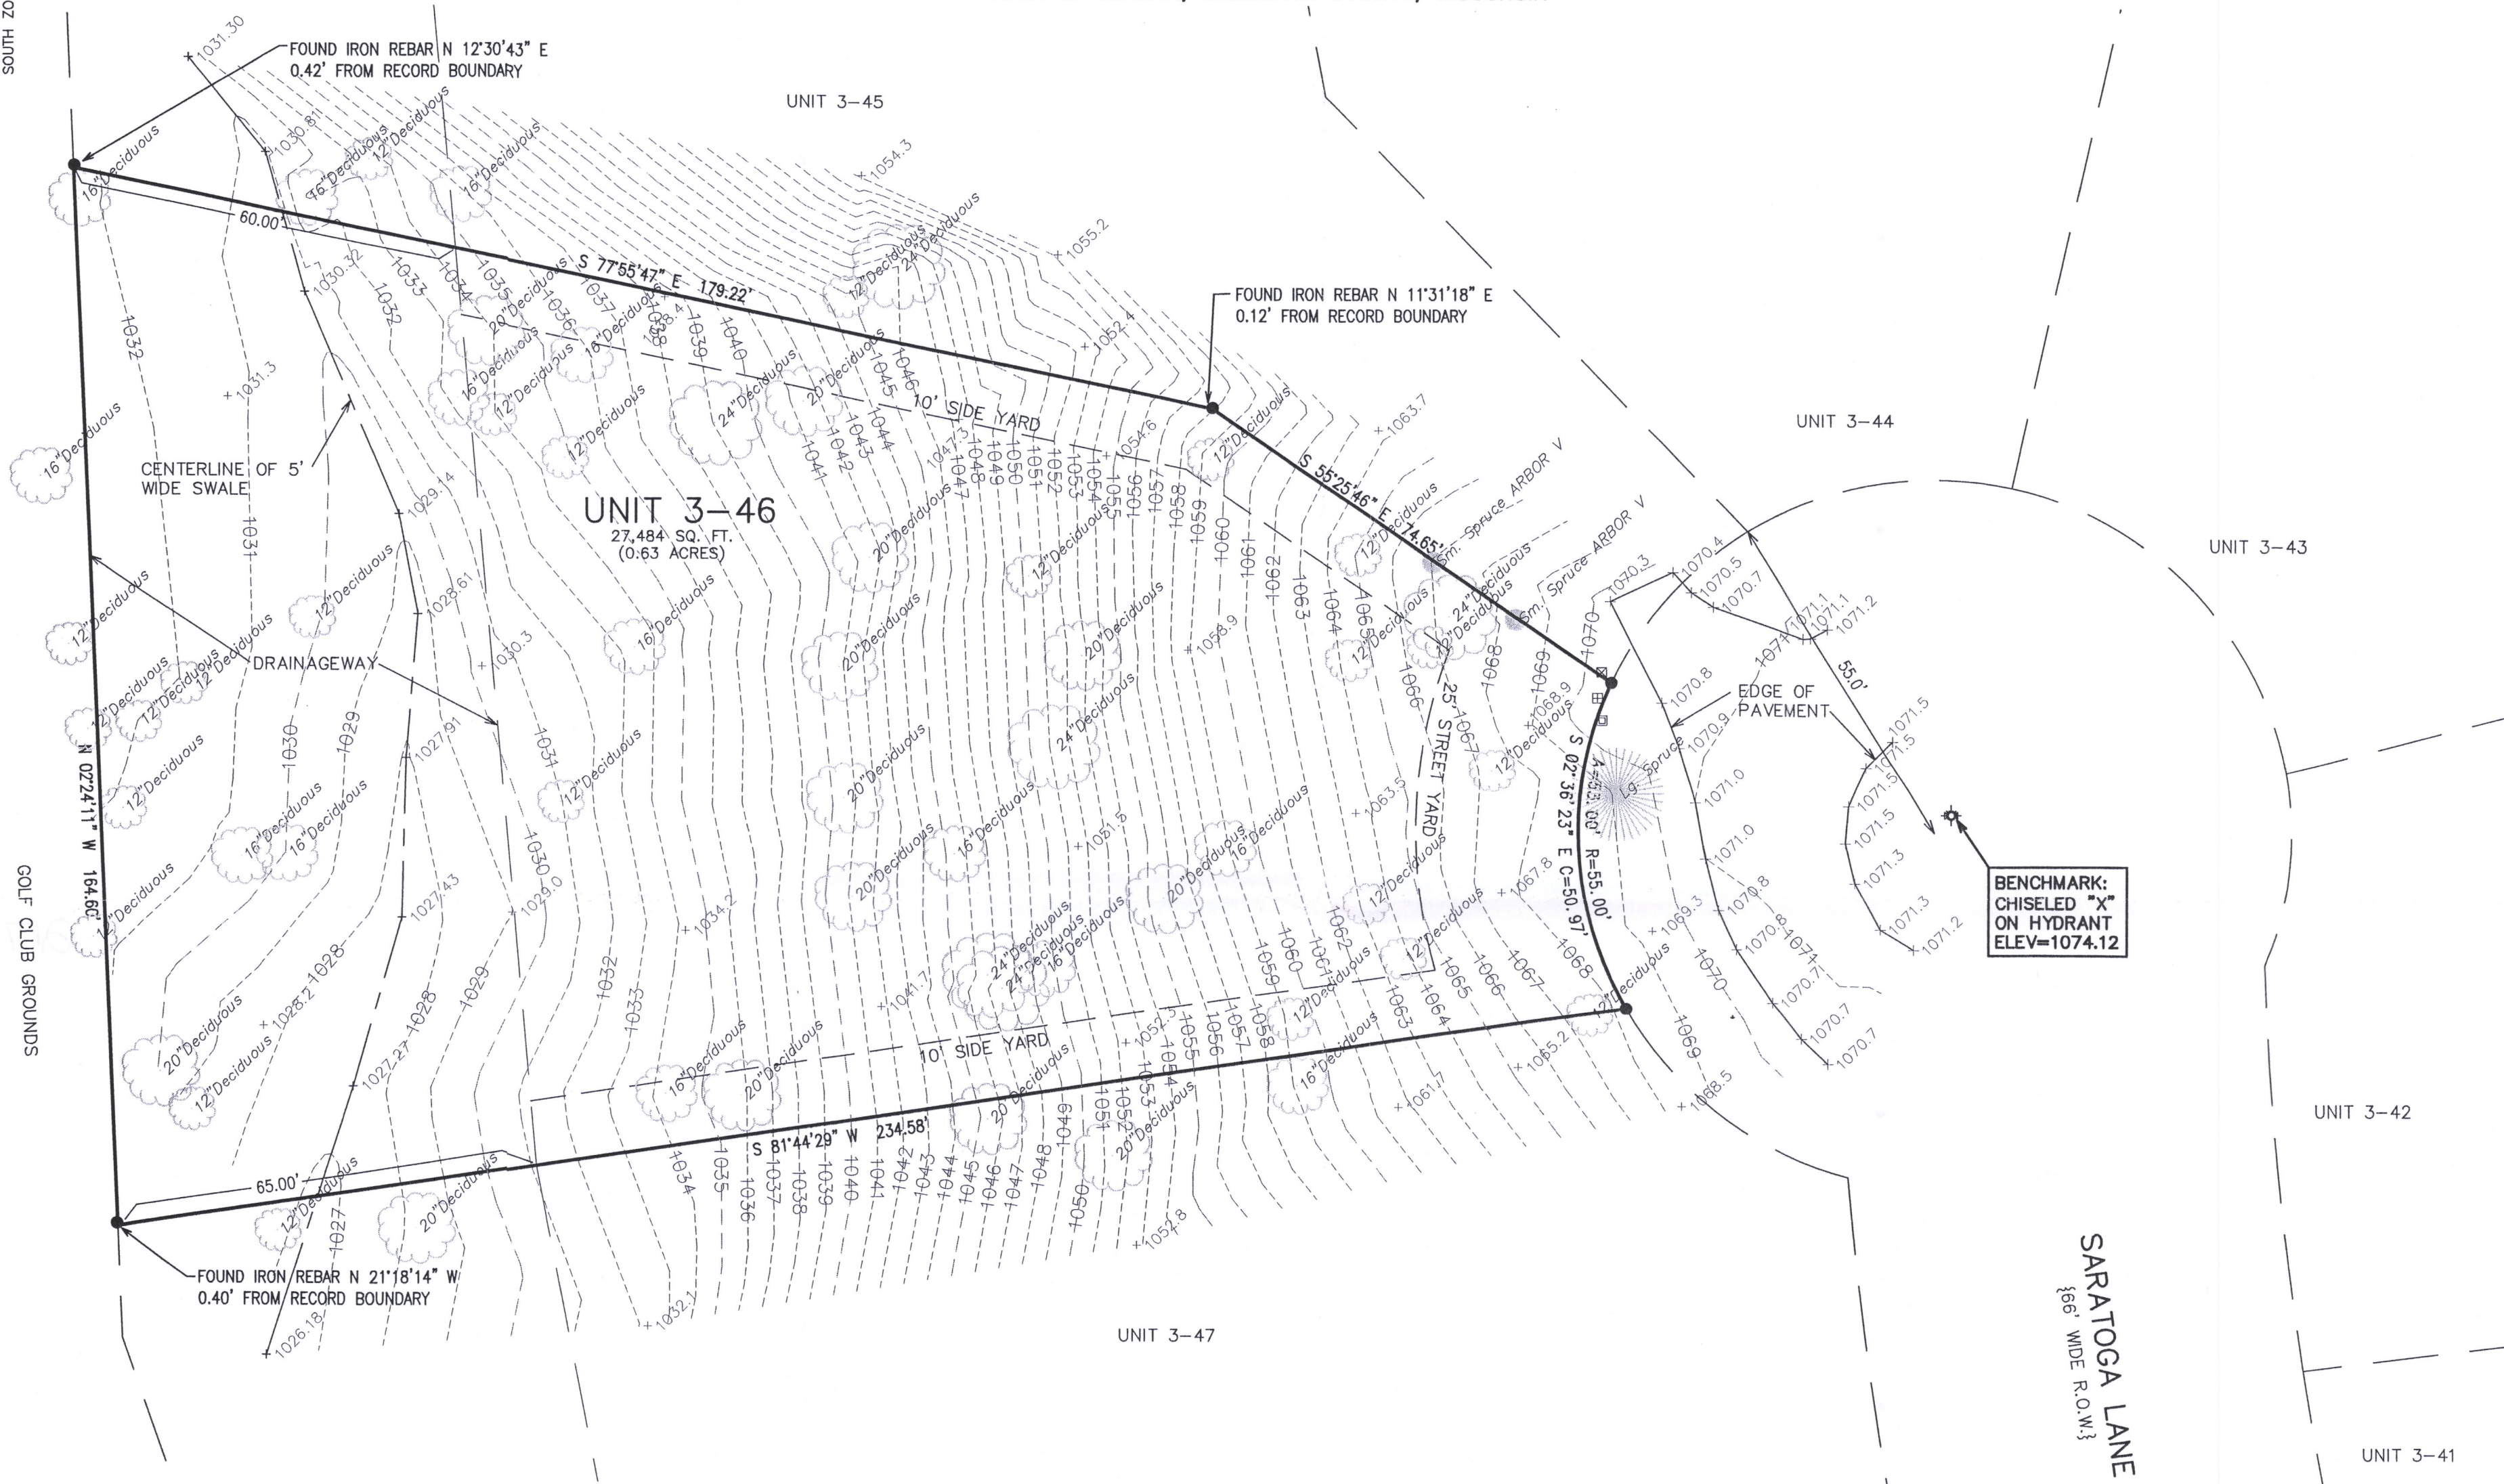

LEGEND

- ✕ = FOUND CHISELED "X"
- = FOUND REBAR STAKE
- ⋈ = HYDRANT
- ☐ = CABLE BOX
- ⊞ = ELECTRIC BOX
- ☒ = TELEPHONE BOX
- {XXX} = RECORDED AS
- +xxxx = EXISTING GROUND ELEVATION
- xxxx--- = EXISTING LAND CONTOURS

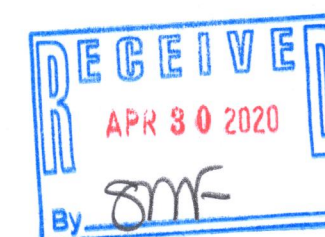


NOTE: COPIES OF THIS MAP TO WHICH THE FOLLOWING CERTIFICATE WILL APPLY SHOW THE SURVEYOR'S ORIGINAL SEAL AND SIGNATURE IN RED INK. COPIES BY ANY OTHER MEANS MAY HAVE ALTERATIONS WHICH DO NOT REPRESENT THE SURVEYOR'S WORK PRODUCT.

I HEREBY CERTIFY THAT THE ABOVE DESCRIBED PROPERTY HAS BEEN SURVEYED UNDER MY DIRECTION AND THAT THE ABOVE MAP IS A TRUE REPRESENTATION THEREOF AND SHOWS THE SIZE AND LOCATION OF THE PROPERTY AND ITS EXTERIOR BOUNDARIES. THIS SURVEY IS MADE FOR THE USE OF THE PRESENT OWNERS OF THE PROPERTY, AND ALSO THOSE WHO PURCHASE, MORTGAGE, OR GUARANTEE THE TITLE THERETO WITHIN ONE YEAR FROM THE DATE HEREOF.

DATED: 03/27/2020

Brian M. Carlson P.L.S. 2039

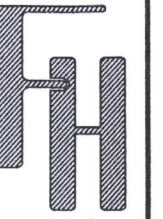

TOPOGRAPHIC SURVEY
1364 SARATOGA LANE
LAKE GENEVA, WI 53147

WORK ORDERED BY -
CAPITOL PLUMBING
8200 W. 185TH STREET SUITE N
TINLEY PARK, IL 60487

FARRIS, HANSEN & ASSOCIATES, INC.
ENGINEERING - ARCHITECTURE - SURVEYING
7 RIDGWAY COURT P.O. BOX 437
ELKHORN, WISCONSIN 53121
OFFICE: (262) 723-2098 FAX: (262) 723-5886

REVISIONS
03/27/2020 - LB
TOPO. RESURVEY

PROJECT NO.
3269-03-46.20

DATE:
01/20/2003

SHEET NO.
1 OF 1