KOLB LAND CONSULTING, INC.

LAND SURVEYING · SUBDIVIDING · LAND PLANNING

LAKE GENEVA, WISCONSIN 53147 WHITEWATER, WISCONSIN 53190

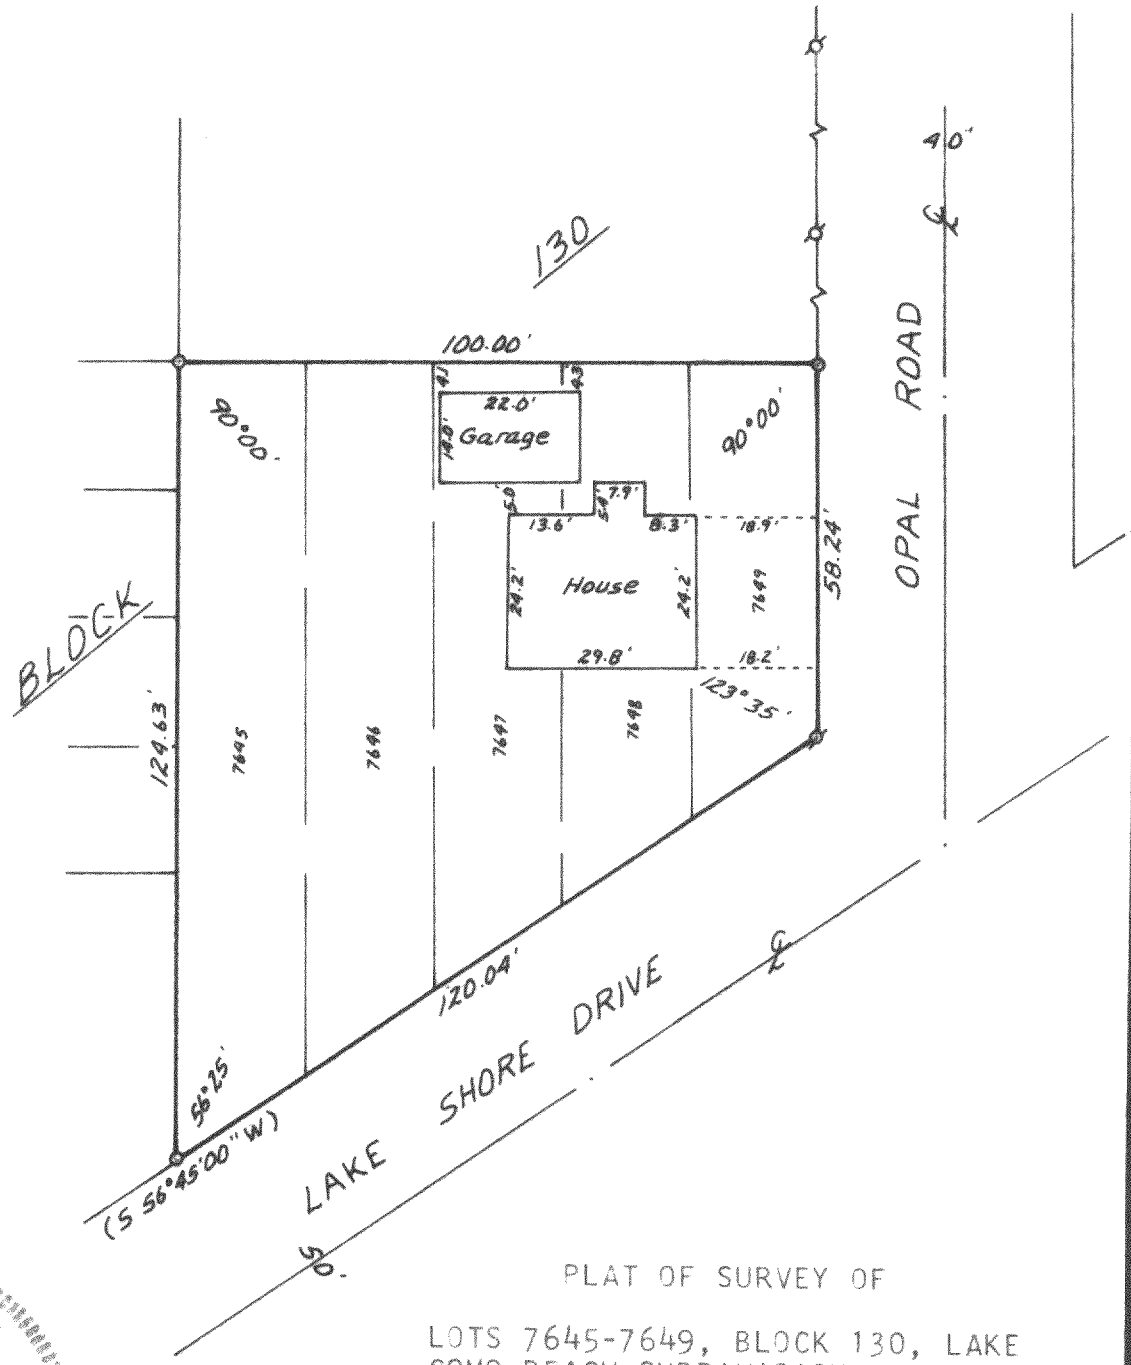

PLAT OF SURVEY OF

LOTS 7645-7649, BLOCK 130, LAKE COMO BEACH SUBDIVISION, T2N, R17E, WALWORTH COUNTY, WISCONSIN.

ORDERED BY: HERSH HUBBS
821 FOXWOOD CIRCLE
GENEVA, IL 60134

WISCONSIN HAROLD H. KOLB LAKE GENEVA, WIS. LAND SURVEYOR

SCALE - 1"=30'

LEGEND
- IRON PIPE FOUND
- IRON PIPE SET
() - RECORDED AS

I, HAROLD H. KOLB, DO HEREBY CERTIFY THAT I HAVE SURVEYED THE PROPERTY HEREON DESCRIBED ACCORDING TO THE OFFICIAL RECORDS, AND THAT THE PLAT HEREON IS A CORRECT REPRESENTATION OF THE LOT LINES TO THE BEST OF MY KNOWLEDGE AND BELIEF.

Harold H. Kolb

HAROLD H. KOLB
WISCONSIN REGISTERED LAND SURVEYOR, S-187

DATE OCTOBER 4, 1983

JLCB 01625

217-593